


DUNHAM SURVEYING, S.C.
SURVEYING & SUBDIVIDING
DELAVAN, WISCONSIN 53115

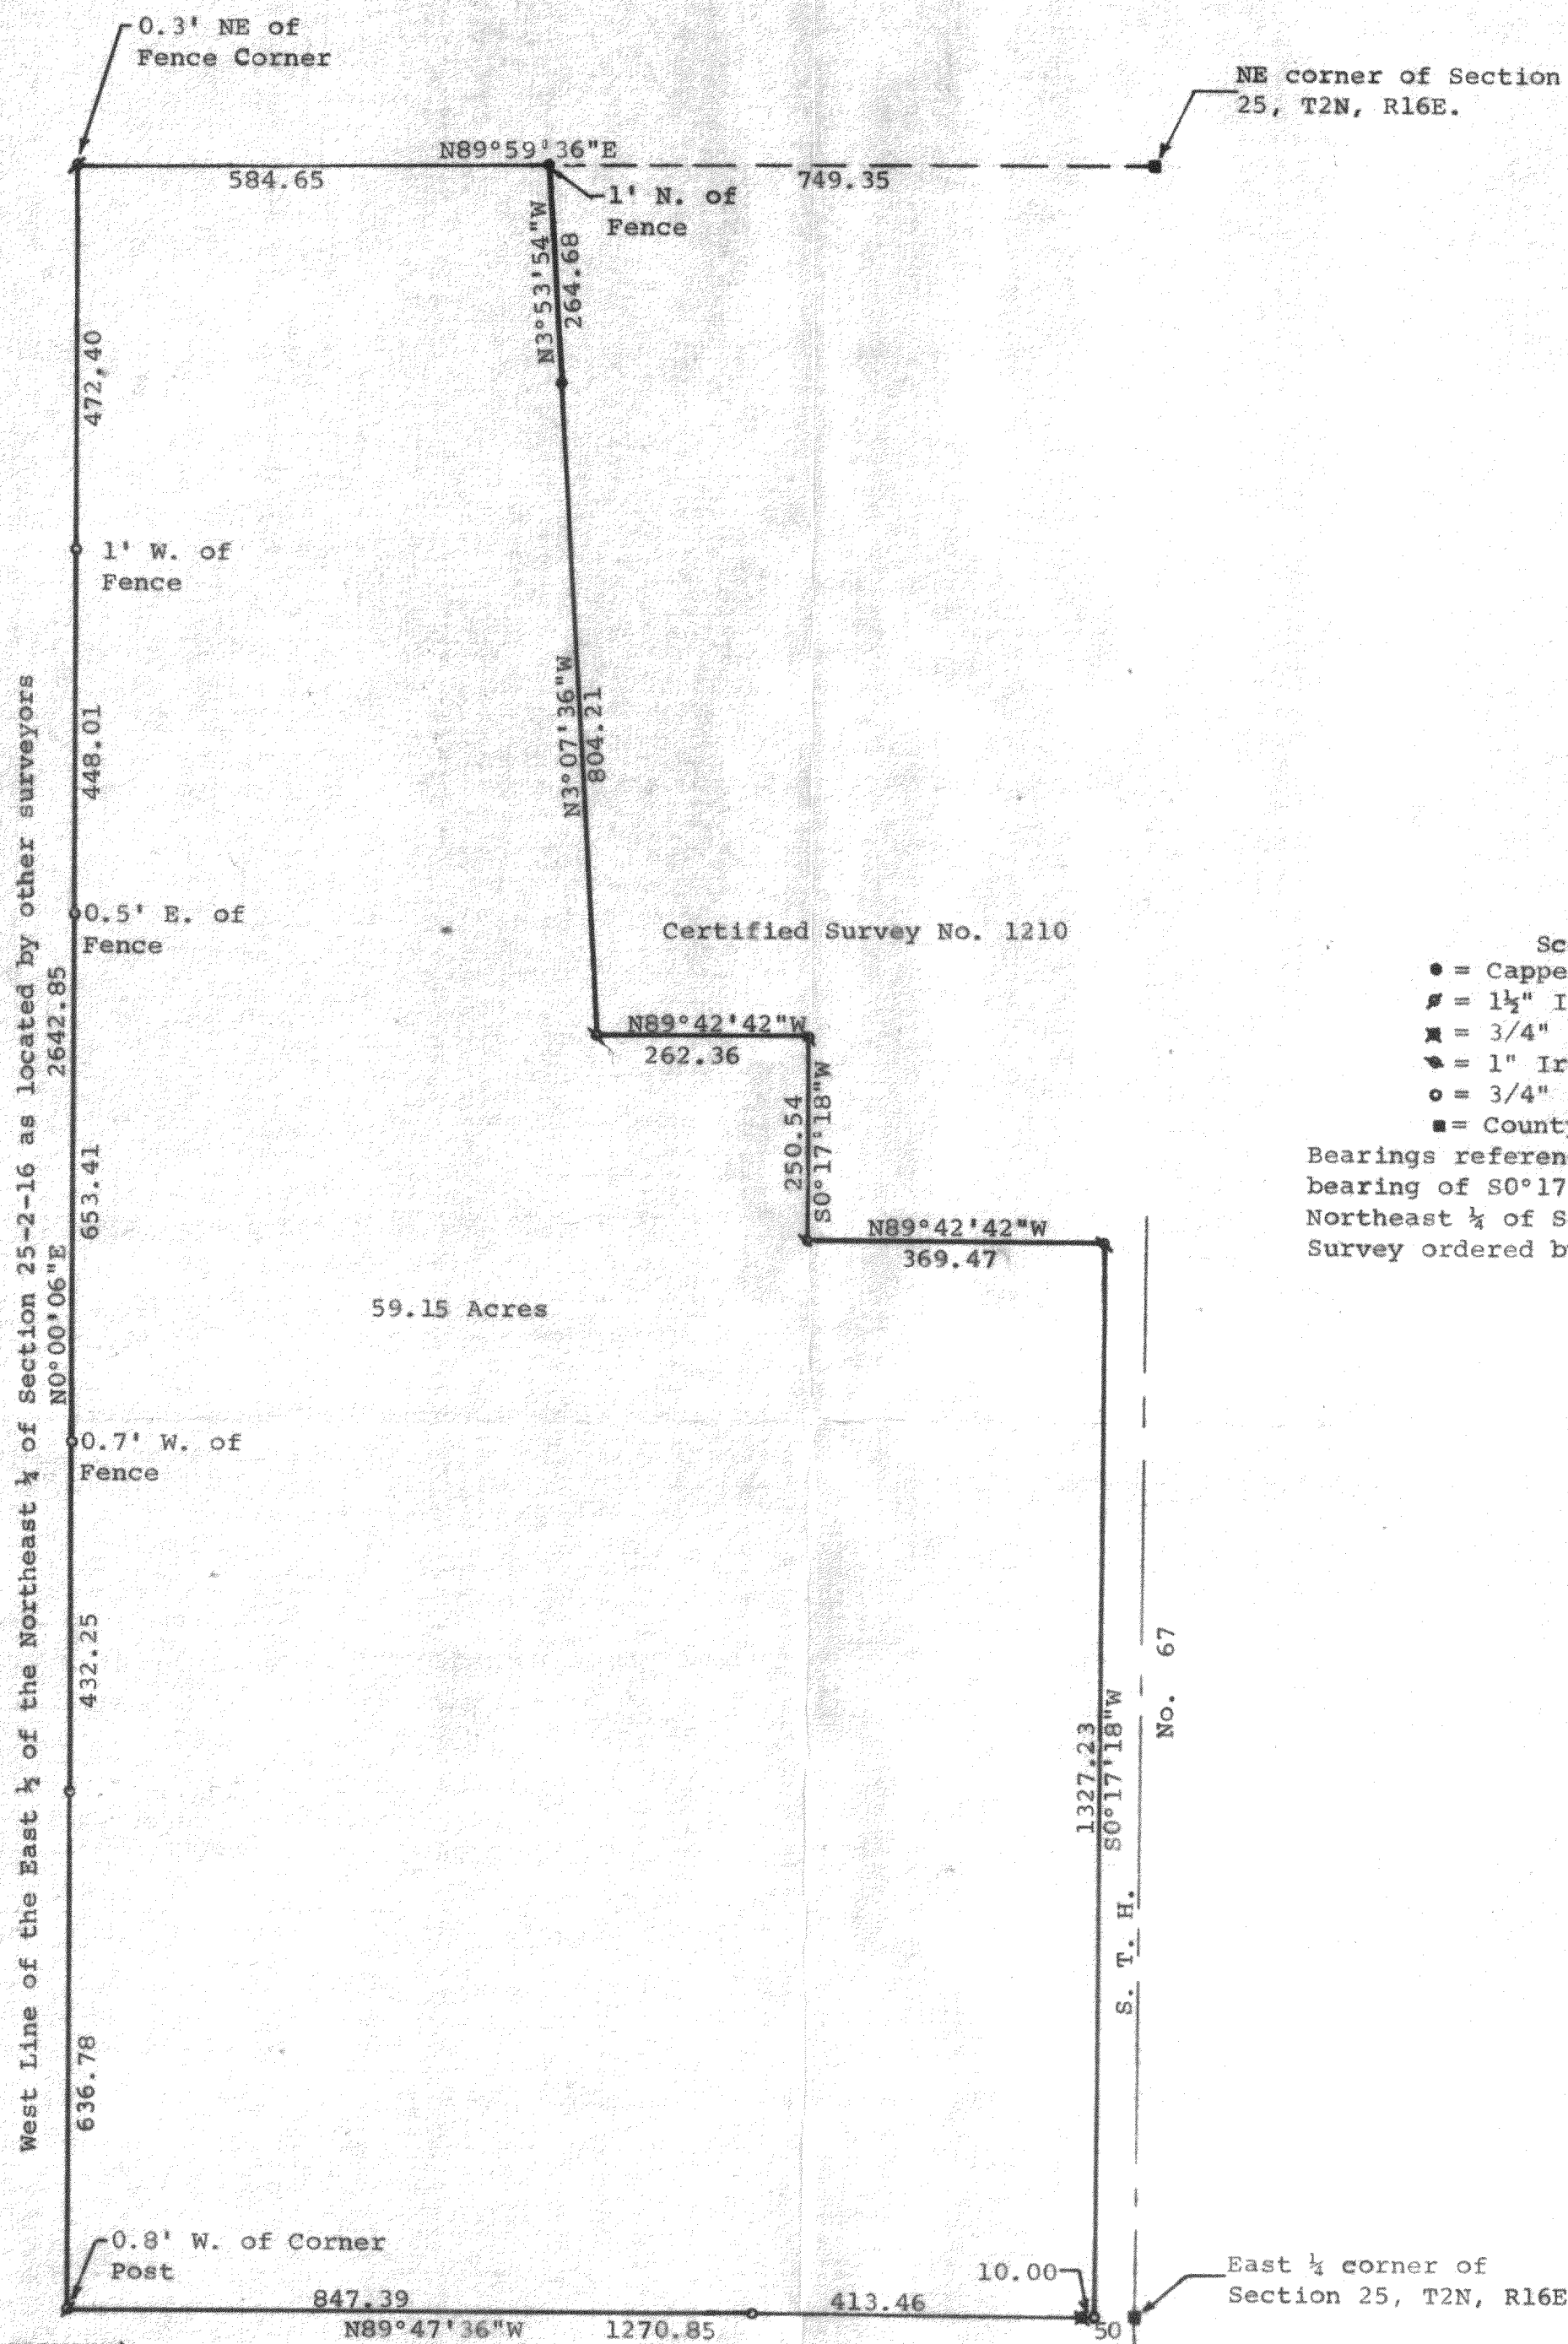

Scale - 1" = 200'
 • = Capped iron rod found
 ▣ = 1 1/2" Iron Pipe Found
 ▢ = 3/4" Iron Pipe Found
 ◐ = 1" Iron Pipe Found
 ○ = 3/4" Iron Pipe Set
 ■ = County Concrete Monument
 Bearings referenced to the previously assumed bearing of S0°17'18"W along the east line of the Northeast 1/4 of Section 25-2-16
 Survey ordered by Arlyne Greenwald
 Inlet Oaks
 Delavan, WI 53115

STATE OF WISCONSIN)
COUNTY OF WALWORTH) SS

I, George T. Dunham, Surveyor, certify that I have surveyed the property described as follows:

A parcel of land located in the East 1/4 of the Northeast 1/4 of Section 25, T 2 N, R 16 E, Walworth County, Wisconsin, described as follows: Commencing at the East 1/4 corner of said Section 25; thence N89°47'36"W along the south line of said Northeast 1/4, 50.00 feet to the place of beginning; thence continue N89°47'36"W 1270.85 feet to the southwest corner of said East 1/4; thence N0°00'06"E along the west line of said East 1/4, 2642.85 feet to the northwest corner of said East 1/4; thence N89°59'36"E along the north line of said East 1/4, 584.65 feet; thence S3°53'54"E 264.68 feet to the northwest corner of Certified Survey No. 1210; thence S3°07'36"E 804.21 feet; thence S89°42'42"E 262.36 feet; thence S0°17'18"W 250.54 feet; thence S89°42'42"E 369.47 feet to the southeast corner of said Certified Survey No. 1210; thence S0°17'18"W along the westerly right of way line of State Trunk Highway No. 67, 1327.23 feet to the place of beginning containing 59.15 acres of land.

and that the plat shown above is a true representation thereof and shows the size and location of the property, its exterior boundaries, the location of boundary fences, apparent easements, roadways and visible encroachments, if any, and that I have surveyed the property hereon described according to the official records to the best of my knowledge and belief.

January 17, 1984

George T. Dunham
George T. Dunham, Surveyor

