


KOLB LAND CONSULTING, INC.
LAND SURVEYING • SUBDIVIDING • LAND PLANNING

LAKE GENEVA, WISCONSIN 53147

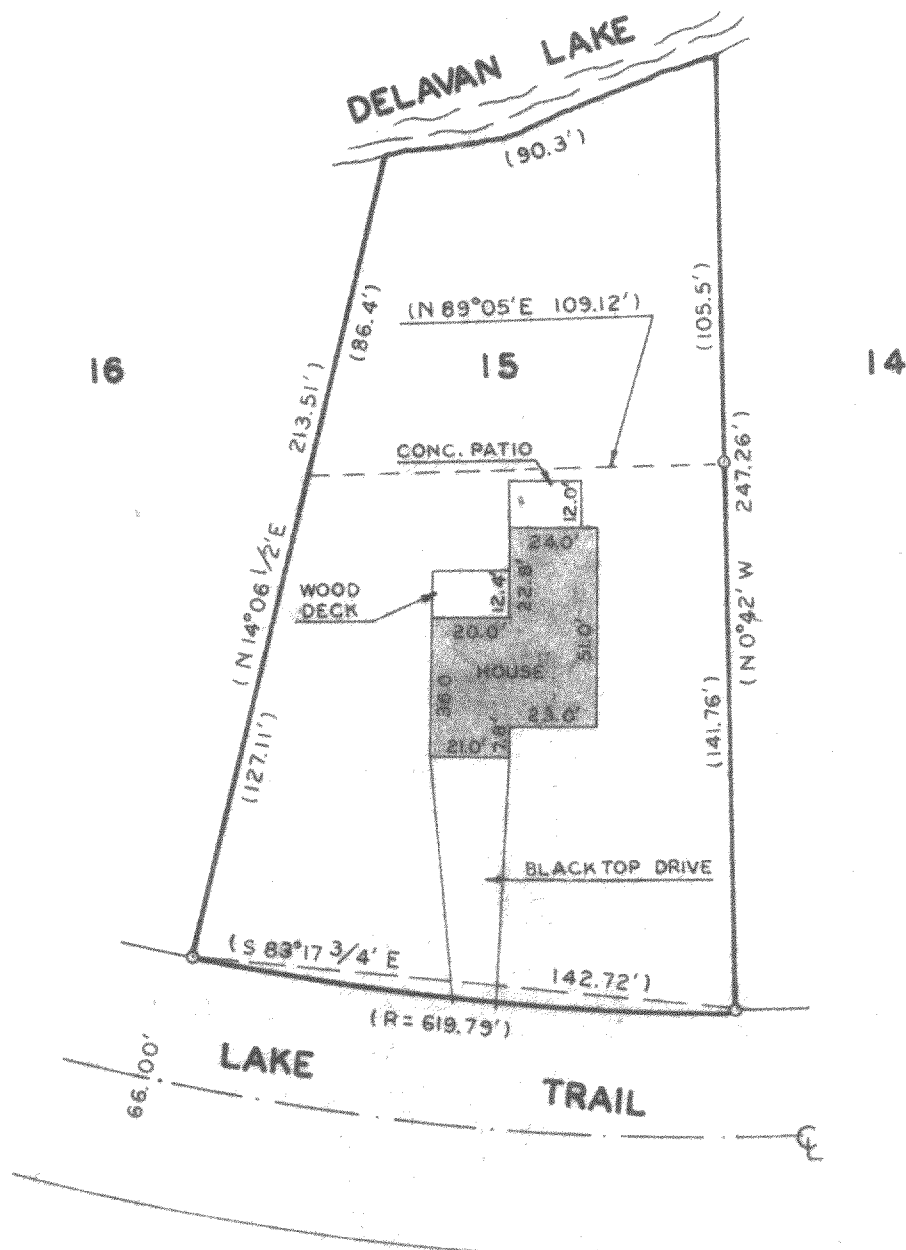

MORTGAGE INSPECTION OF

LOT 15, LAKEWOOD ESTATES SUBDIVISION, SECTION 21, T 2 N,
R 16 E, WALWORTH COUNTY, WISCONSIN.

ORDERED BY: ANCHOR SAVINGS & LOAN ASSOCIATION
500 E. WALWORTH AVE.
DEHAVAN, WI 53115

BUYER: NOREEN M. MC CANN

COMPLIANCE WITH A-E 3, 5(F), 6 (A), (B), (C), (D) AND 7 HAS
BEEN WAIVED BY THE CLIENT, IN AGREEMENT WITH THE SURVEYOR,
AS PERMITTED IN A-E5.01(B).



SCALE - 1"=50'

LEGEND

◊ IRON PIPE FOUND
() RECORDED AS

Harold H. Kolb

HAROLD H. KOLB
WISCONSIN REGISTERED LAND SURVEYOR, S-187
DATE JANUARY 3, 1985