



ANDERSON LAND SURVEYING

DELAVAN, WIS. 53115


728-2525

PLAT OF SURVEY

DESCRIPTION: Part of Lot 9 of Cedar Point Subdivision located in the NE. 1/4 of Sec. 28, T. 2 N., R. 16 E., described as follows: Commencing at the SW. corner of Lot 10 of said subdivision; Thence S. 89° 52' E. along the N/L of said Lot 9, 63 feet to an iron pipe at the place of beginning; Thence S. 0° 09' W. --- 136.77 feet to an iron pipe; Thence S. 89° 54' E. --- 52.38 feet to an iron rod; Thence N. 0° 09' E. --- 136.73 feet to an iron pipe on the N/L of said Lot 9; Thence N. 89° 52' W. --- 52.38 feet along the N/L of said Lot 9 to the place of beginning; subject to a R/W described in Vol. 544 Pages 560 & 561 of Walworth Co. Records; Walworth County, Wisconsin.

PREPARED FOR: Martha Rehder
R. 3 Box 430A
Liberty, N.C. 27298


PREPARED BY: Anderson Land Surveying
P.O. Box 10
Delavan, Wis. 53115

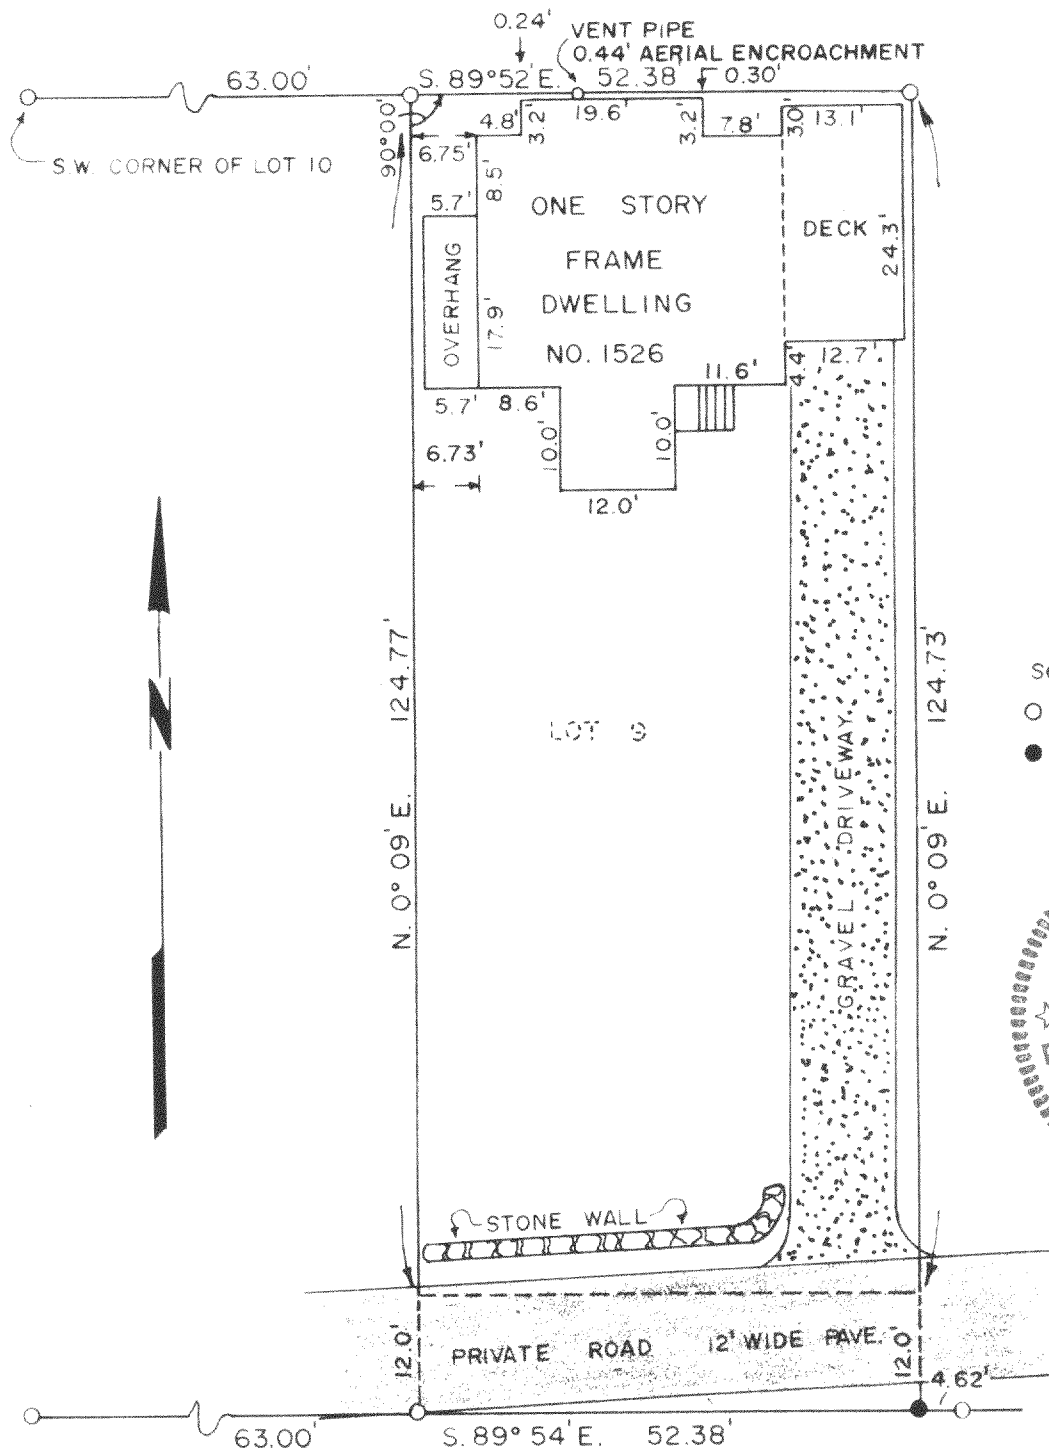

SCALE: 1" EQUALS 20'

O = IRON PIPE FOUND

● = IRON ROD W/CAP SET

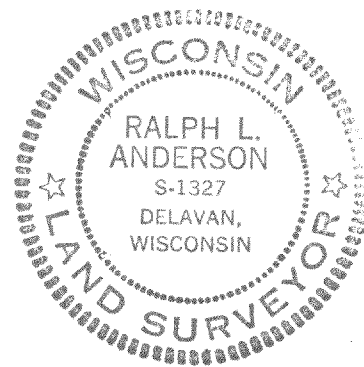

SURVEYOR'S CERTIFICATE

I HEREBY CERTIFY THAT I HAVE SURVEYED THE ABOVE DESCRIBED PROPERTY AND THE ABOVE MAP IS A TRUE REPRESENTATION THEREOF AND SHOWS THE SIZE AND LOCATION OF THE PROPERTY, ITS EXTERIOR BOUNDARIES, THE LOCATION AND DIMENSIONS OF ALL VISIBLE STRUCTURES THEREON. THIS SURVEY IS MADE FOR THE EXCLUSIVE USE OF THE PRESENT OWNERS OF THE PROPERTY, AND ALSO THOSE WHO PURCHASE, MORTGAGE, OR GUARANTEE THE TITLE THERETO WITHIN ONE (1) YEAR FROM DATE HEREOF.

DATE 21 SEPT. 1984

SURVEYOR Ralph L. Anderson, R.L.S.

JOB NO. 24084