

PLAT OF SURVEY OF A PARCEL OF LAND LOCATED IN THE SE 1/4 OF FRACTIONAL SECTION 22, T2N, R16E TOWN OF DELEVAN, WALWORTH COUNTY, WISCONSIN.

JENSEN SURVEYING & MAPPING S.C.


P.O. BOX 322 ELKHORN, WISCONSIN 45 S. WISCONSIN ST.
PHONE ~ (414) 723-3434 53121

SURVEYED FOR: STAN BONTKOWSKI

1. The land referred to in the Commission is described as follows:


Beginning at a point in the center of the highway at the SE 1/4 corner of that certain piece of real estate sold and conveyed by Albert W. Biedgett and his wife, to Frank G. Dahlgren, dated October 1, 1920 and recorded in the office of the Register of Deeds in and for Walworth County, Wisconsin in Volume 161 of Deeds, on page 321, and from said place of beginning, running in a NE 1/4 direction along the center of said road or highway to a point where a line drawn parallel with the 50 feet NE 1/4 of (measuring at right angles to) the NE 1/4 line of said land so conveyed on October 1, 1920 would intersect said center line, thence NW 1/4 on a line parallel with and 50 feet from and measuring at right angles to the NE 1/4 line of said land so conveyed 400 feet more or less to the shore of Delavan Lake at low water line, thence in a SW 1/4 direction along the low water line of said lake to the NE 1/4 corner of said land so conveyed, thence SE 1/4 along the NE 1/4 line of said so conveyed to the place of beginning; all being in the Southeast 1/4 of Section 22, Township 2 North, Range 16 East, Walworth County, Wisconsin.

Tax Key No. FD 2200072

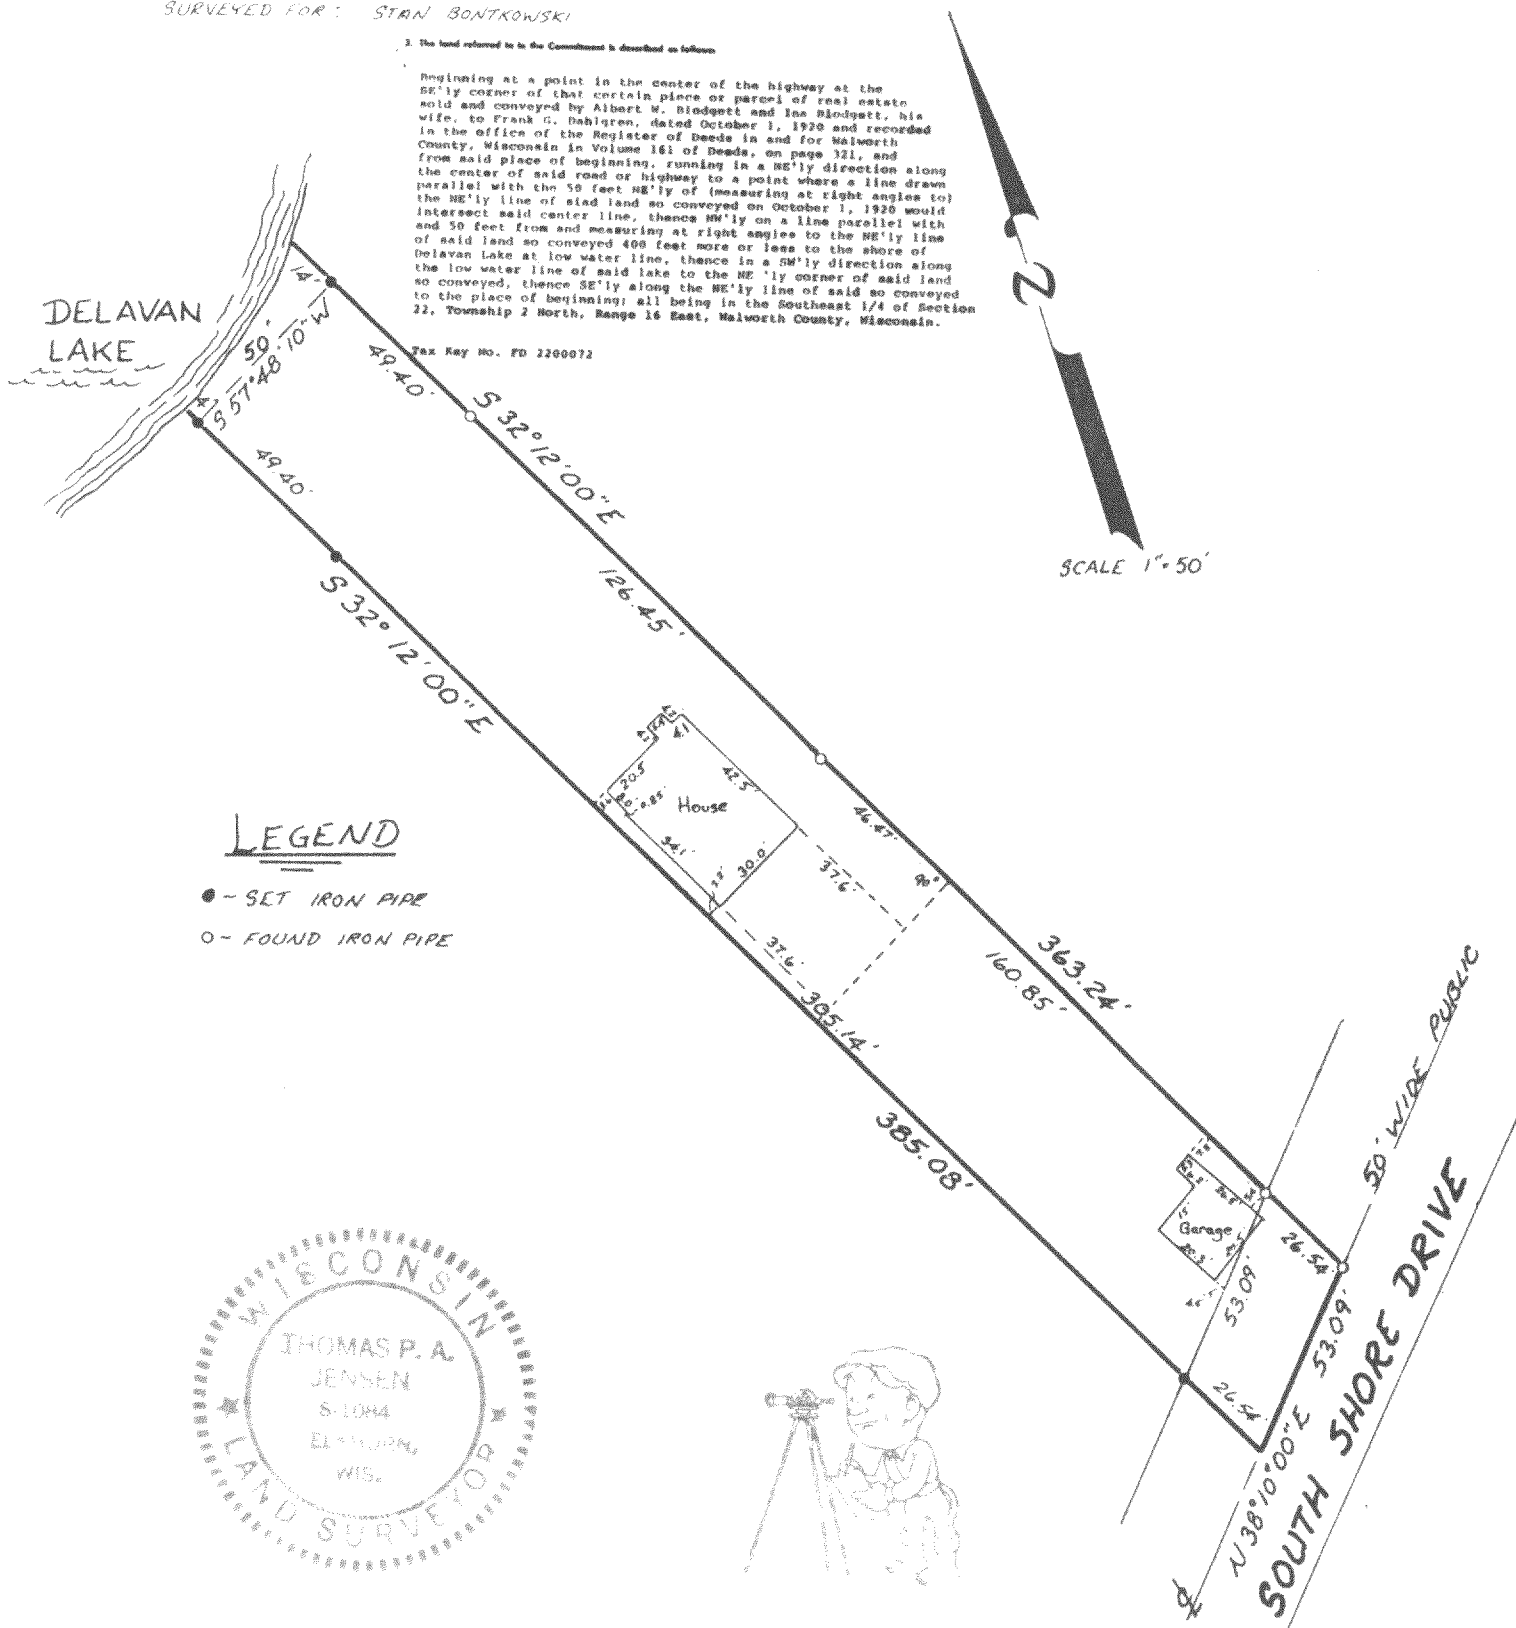

LEGEND

- - SET IRON PIPE
- - FOUND IRON PIPE

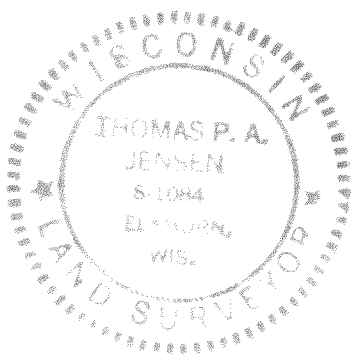

I HEREBY CERTIFY THAT THE ABOVE DESCRIBED
PROPERTY HAS BEEN SURVEYED UNDER MY DIRECTION THAT
THE PLAT SHOWN HEREON IS AN ACCURATE SURVEY A TRUE
REPRESENTATION THEREOF CORRECTLY SHOWS THE EXTERIOR
BOUNDARY LINES ON SAID PROPERTY AND THE CORRECT
MEASUREMENTS THEREOF AND BUILDINGS THEREON.

MAPPING DATE ~ 16 Oct 84

Thomas P.A. Jensen
THOMAS P.A. JENSEN RLS-1084 ✓

216-799-J

FD-22-72

1984.066 X