
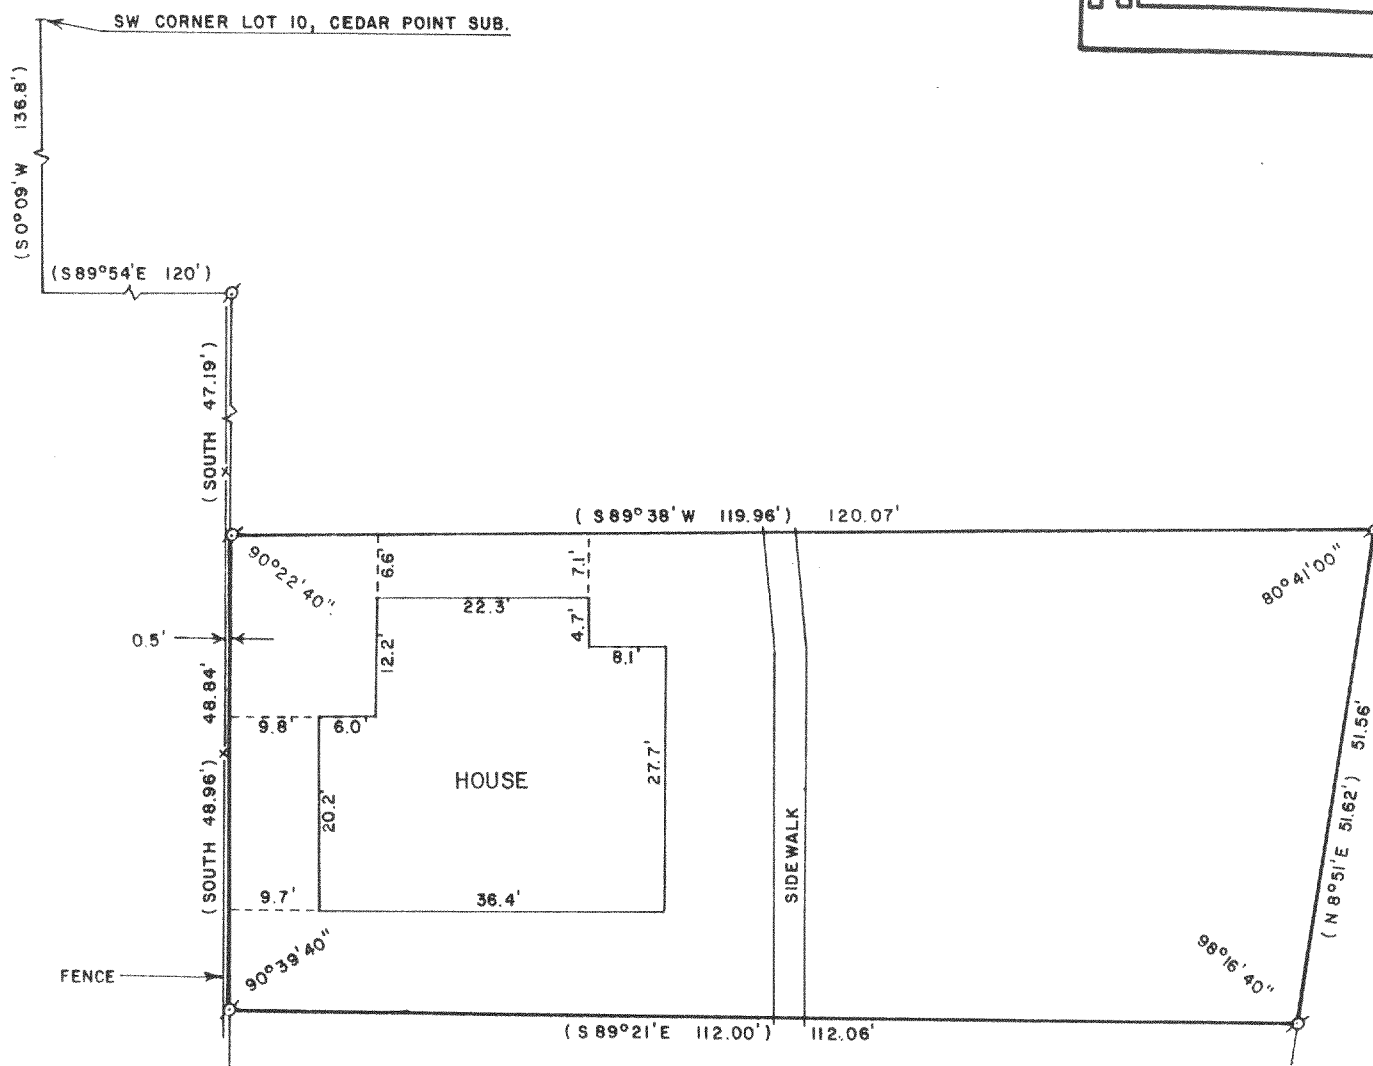



ABELL
SURVEYING & MAPPING
DELAVER, WISCONSIN 53115

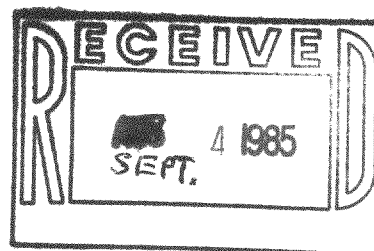

PLAT OF SURVEY OF

PART OF LOT 9 OF CEDAR POINT SUBDIVISION,
LOCATED IN THE NORTHEAST 1/4 OF SECTION
28, T 2 N, R 16 E, AS DESCRIBED IN VOLUME
12, PAGE 191 OF RECORDS, WALWORTH COUNTY,
WISCONSIN.

ORDERED BY: RICHARD BLOCK
7531 EMERSON
MORTON GROVE, IL 60053

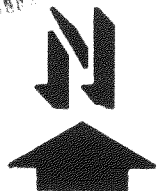

SCALE - 1"=20'

LEGEND

- σ - IRON PIPE FOUND
() - RECORDED AS

I, DAVID F. ABELL, DO HEREBY CERTIFY
THAT I HAVE SURVEYED THE PROPERTY
HEREON DESCRIBED ACCORDING TO THE
OFFICIAL RECORDS, AND THAT THE PLAT
HEREON IS A CORRECT REPRESENTATION
OF THE LOT LINES TO THE BEST OF MY
KNOWLEDGE AND BELIEF.

David F. Abell
DAVID F. ABELL
WISCONSIN REGISTERED LAND SURVEYOR, S-1596

August 5, 1985
DATE JOB NUMBER - 6885001

FC-9J

216-800-A ✓