

I, DANIEL D. COOPER, REGISTERED LAND SURVEYOR, DO HEREBY CERTIFY THAT I HAVE SURVEYED THE PROPERTY DESCRIBED HEREON AND THAT THE MAP SHOWN HEREON IS A TRUE AND ACCURATE REPRESENTATION THEREOF TO THE BEST OF MY PROFESSIONAL KNOWLEDGE AND BELIEF.

Daniel D. Cooper


DANIEL D. COOPER, RLS NO. 1464

DATED THIS 23 DAY OF Aug, 1984.



LEGEND


- Ø — IRON PIPE SURVEY MONUMENT FOUND
- — 1" x 24" IRON PIPE SET
- () — RECORD DIMENSION

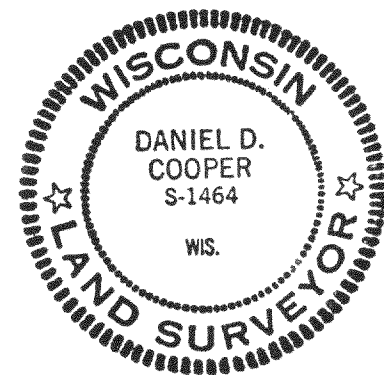

FDM-68

SURVEY ORDERED BY:
FIRST STATE SAVINGS

PLAT OF SURVEY OF
LOT 25 BLOCK 15 OF
DELMAR SUBDIVISION
LOCATED IN T2N R16 E
WALWORTH COUNTY WIS.

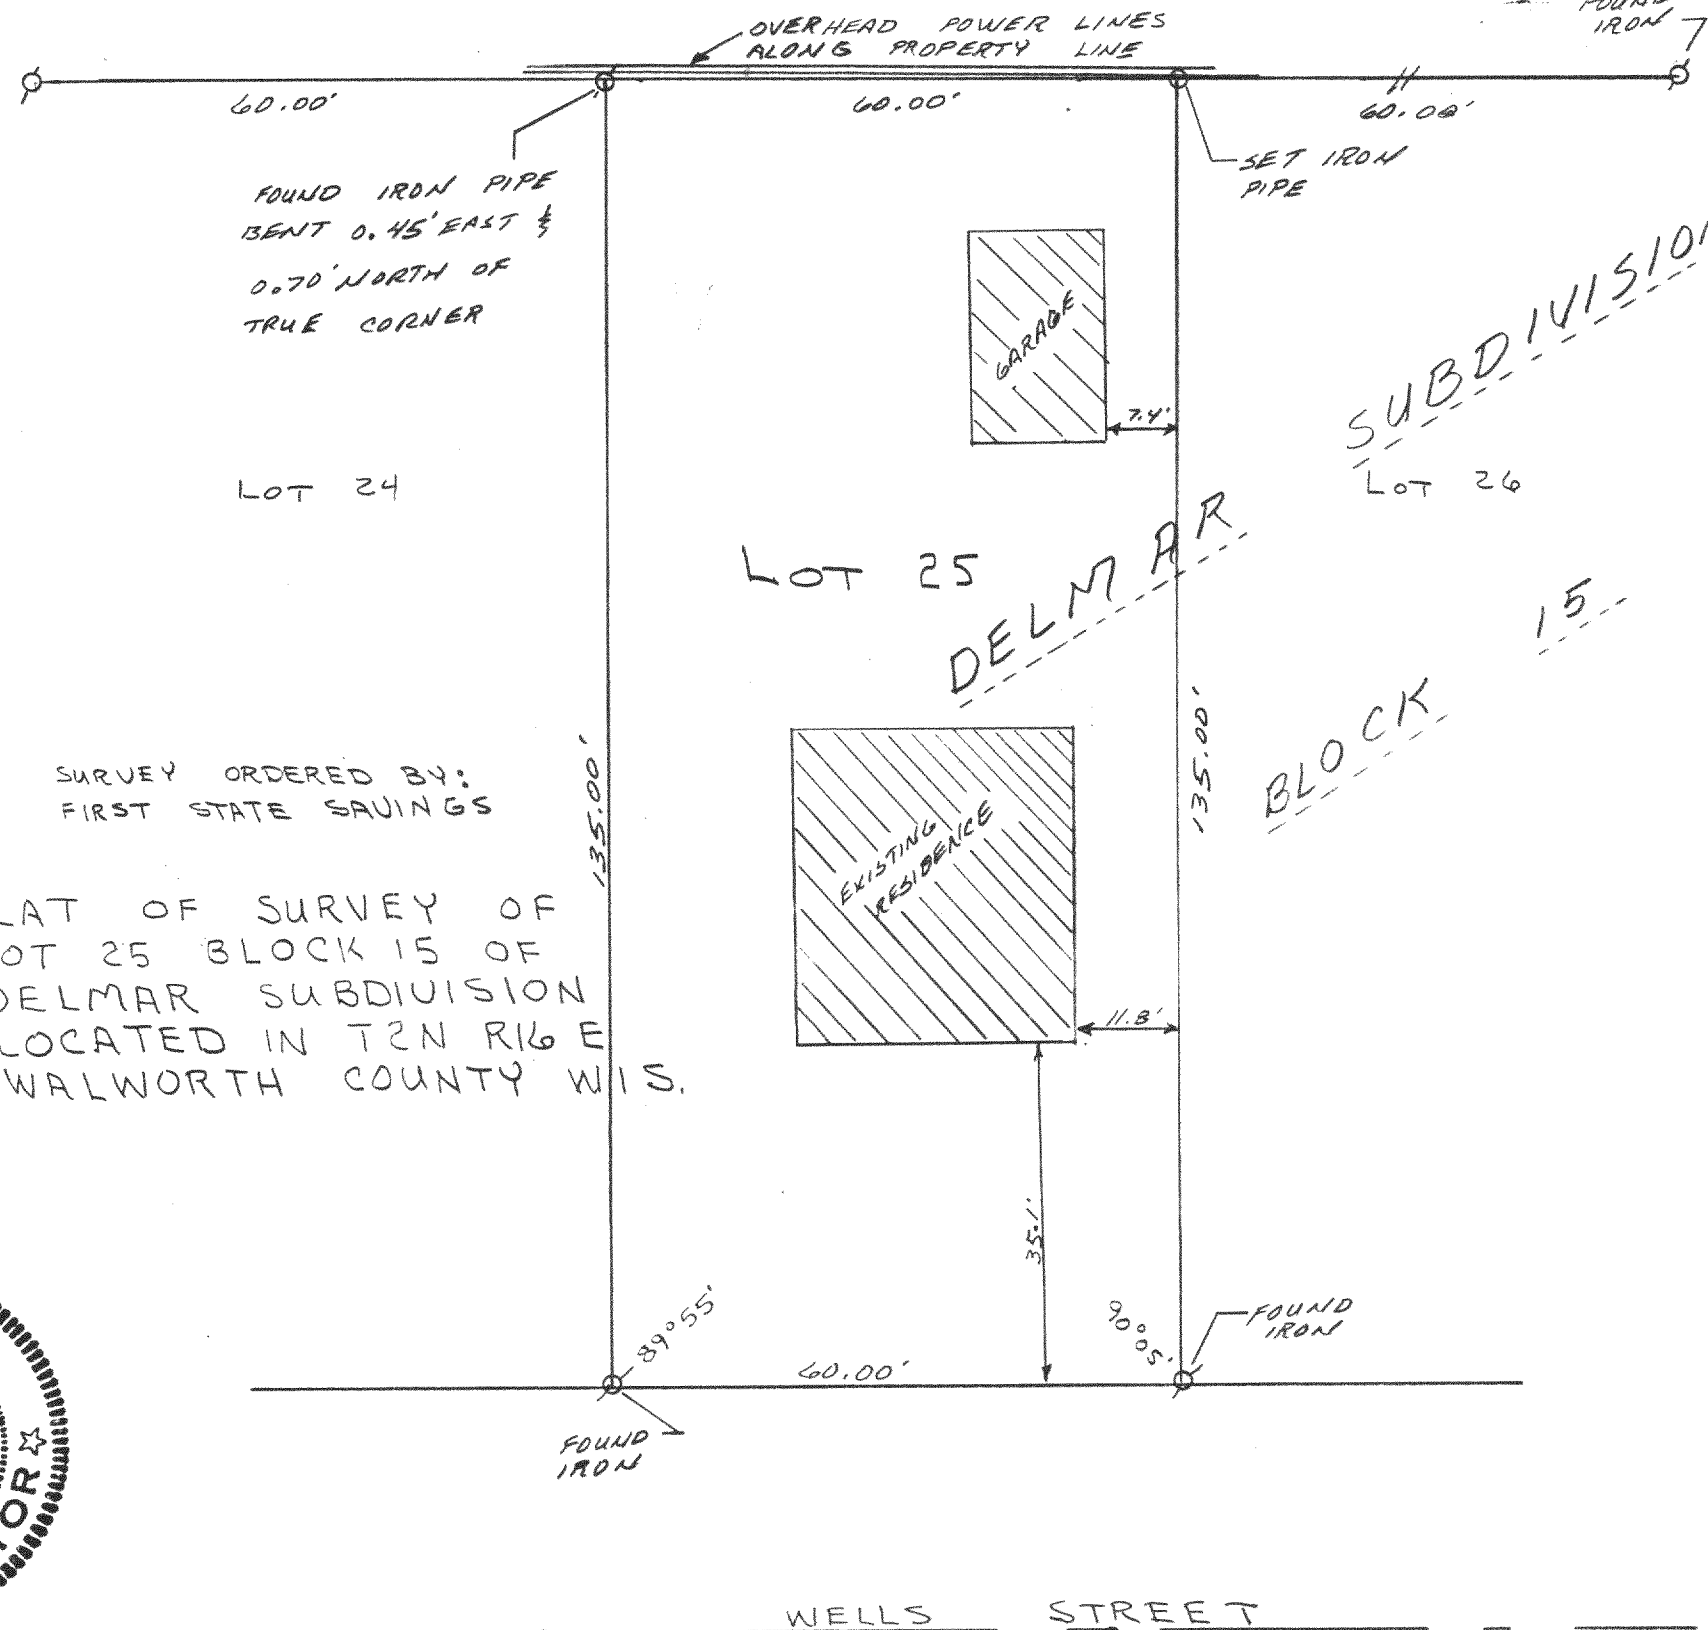

216-801-C
DRAWING NO. 1962