

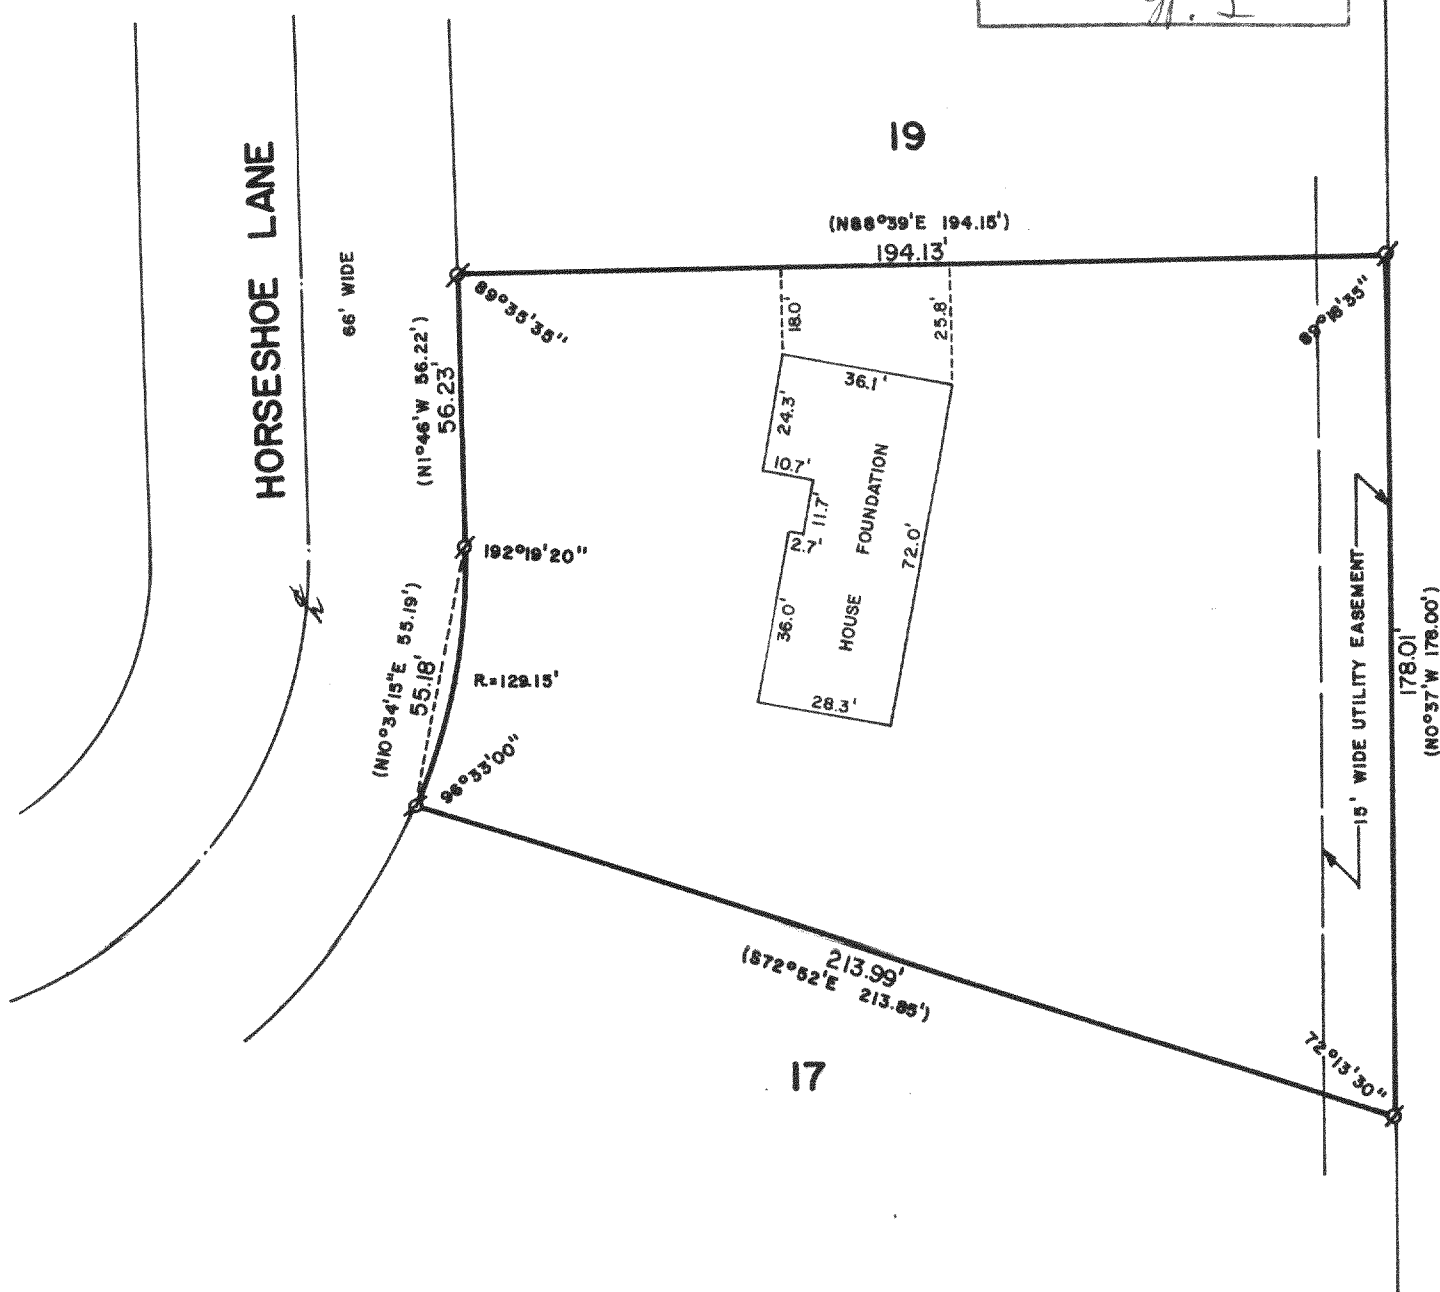


WALWORTH COUNTY
SURVEYING & MAPPING
LAKE GENEVA, WISCONSIN

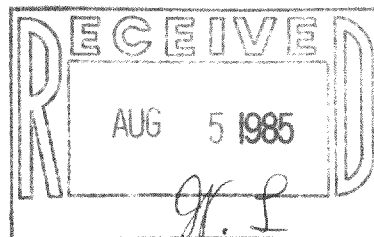


PLAT OF SURVEY OF

LOT 18 OF OAK MEADOWS SUBDIVISION, LOCATED IN
THE NORTHEAST 1/4 OF SECTION 29, T 2 N, R 16 E,
WALWORTH COUNTY, WISCONSIN.

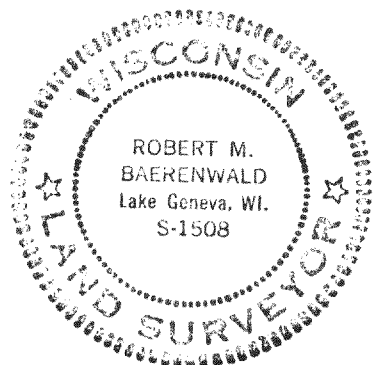

ORDERED BY: RICK JONES
1333 TOMIKE
LAKE GENEVA, WISCONSIN 53147

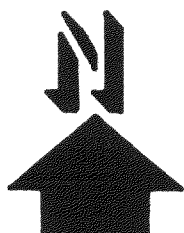

SCALE: 1"=30'

Ø - IRON ROD FOUND
() - RECORDED AS

I, ROBERT M. BAERENWALD, DO HEREBY CERTIFY THAT I
HAVE SURVEYED THE PROPERTY HEREON DESCRIBED ACCORDING
TO THE OFFICIAL RECORDS AND THAT THE PLAT HEREON IS A
CORRECT REPRESENTATION OF THE PROPERTY LINES TO THE
BEST OF MY KNOWLEDGE AND BELIEF.

Robert M. Baerenwald
ROBERT M. BAERENWALD
WISCONSIN REGISTERED LAND SURVEYOR, S-1508

March 5, 1985
DATE JOB NO. 0211

REVISED: JUNE 13, 1985