
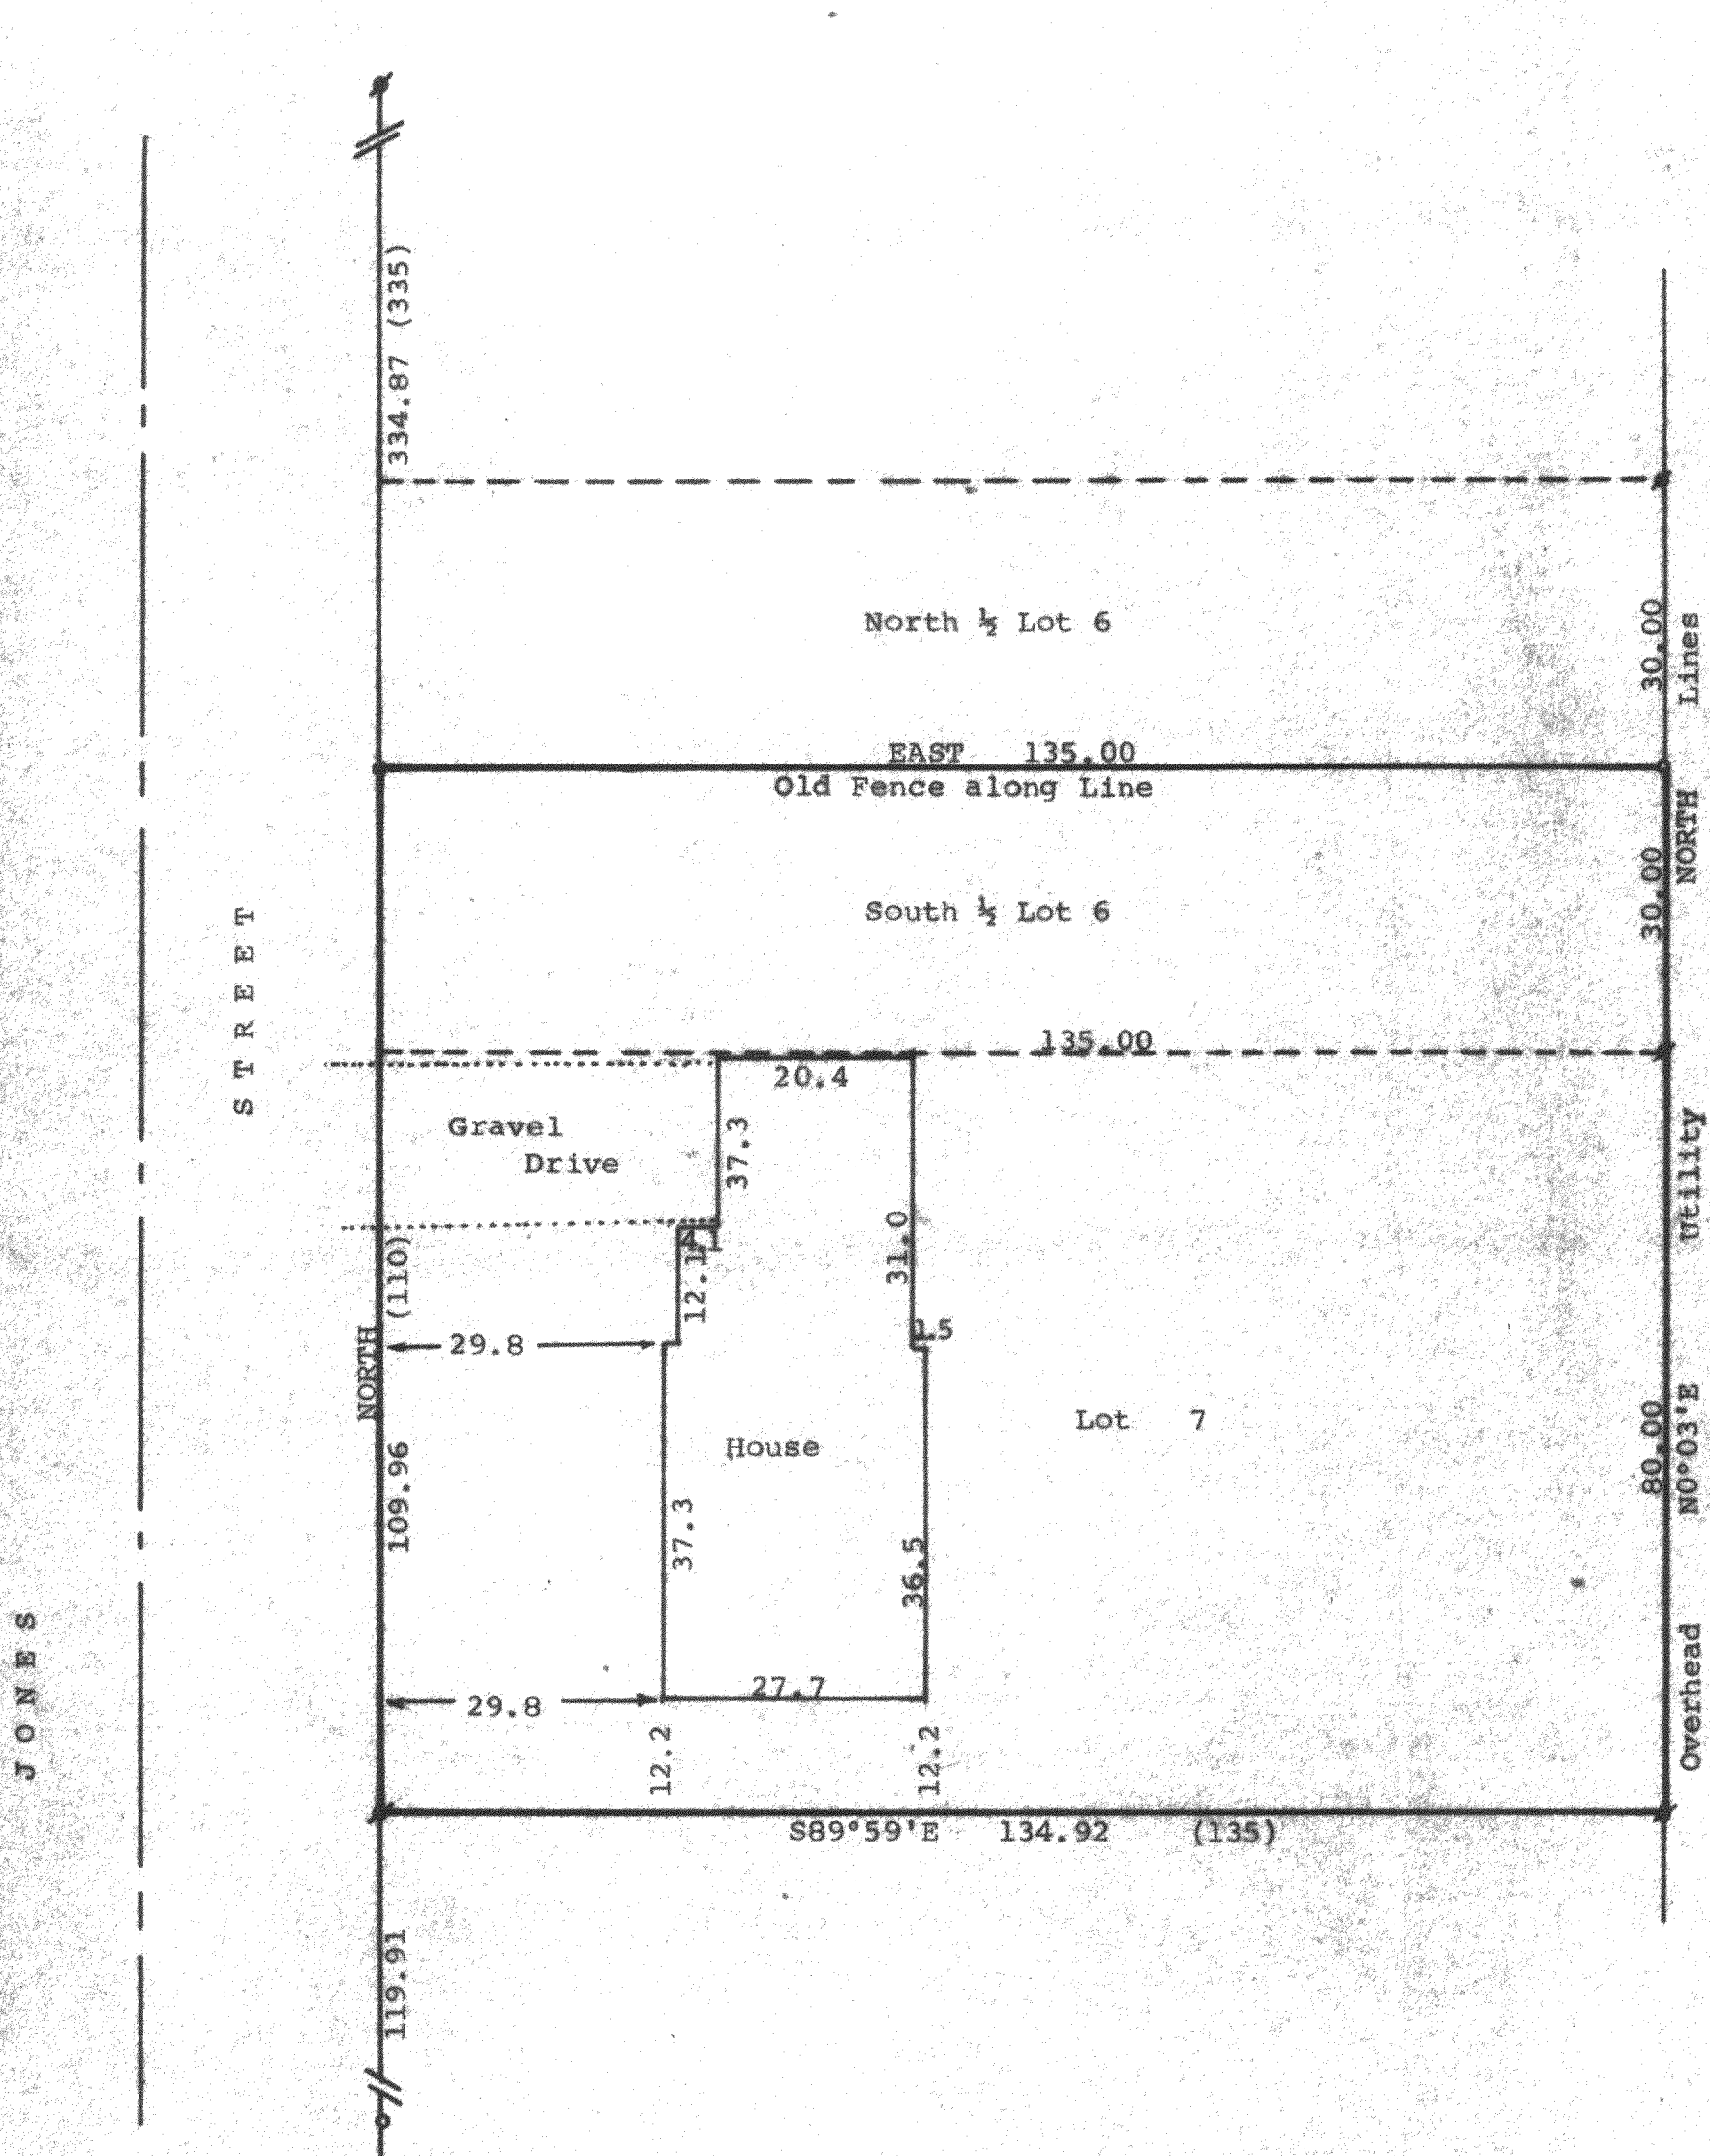


DUNHAM SURVEYING, S. C.
SURVEYING & SUBDIVIDING
DELAVAN, WISCONSIN 53115

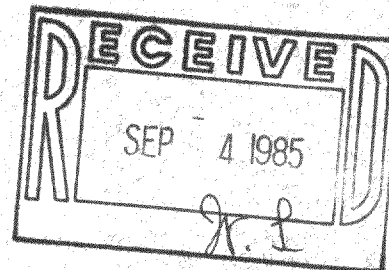

Scale - 1" = 20'
 * = 1" Iron Pipe Found
 • = 1 1/4" Iron Pipe Found and set 3/4" X 24" Iron Pipe inside
 o = 3/4" X 24" Iron Pipe Set
 (0.00) = recorded distance
 Bearings referenced to the recorded bearing of North along the east line of Jones Street
 Survey ordered by: Keefe Real Estate, Inc.
 Better Homes & Gardens
 302 E. Walworth Avenue
 Delavan, WI 53115

STATE OF WISCONSIN)
COUNTY OF WALWORTH) SS

I, George T. Dunham, Surveyor, certify that I have surveyed the property described as follows: Lot 7 and the South 1/2 of Lot 6 in Delmar, a subdivision located in Section 27, T 2 N, R 16 E, Walworth County, Wisconsin and that the map shown above is a true representation thereof and shows the size and location of the property, its exterior boundaries, the location of all visible structures and dimensions of all principal buildings thereon, boundary fences, apparent easements, roadways and visible encroachments, if any, and that I have surveyed the property hereon described according to the official records, to the best of my knowledge and belief.
July 31, 1985

George T. Dunham
George T. Dunham, Surveyor

