

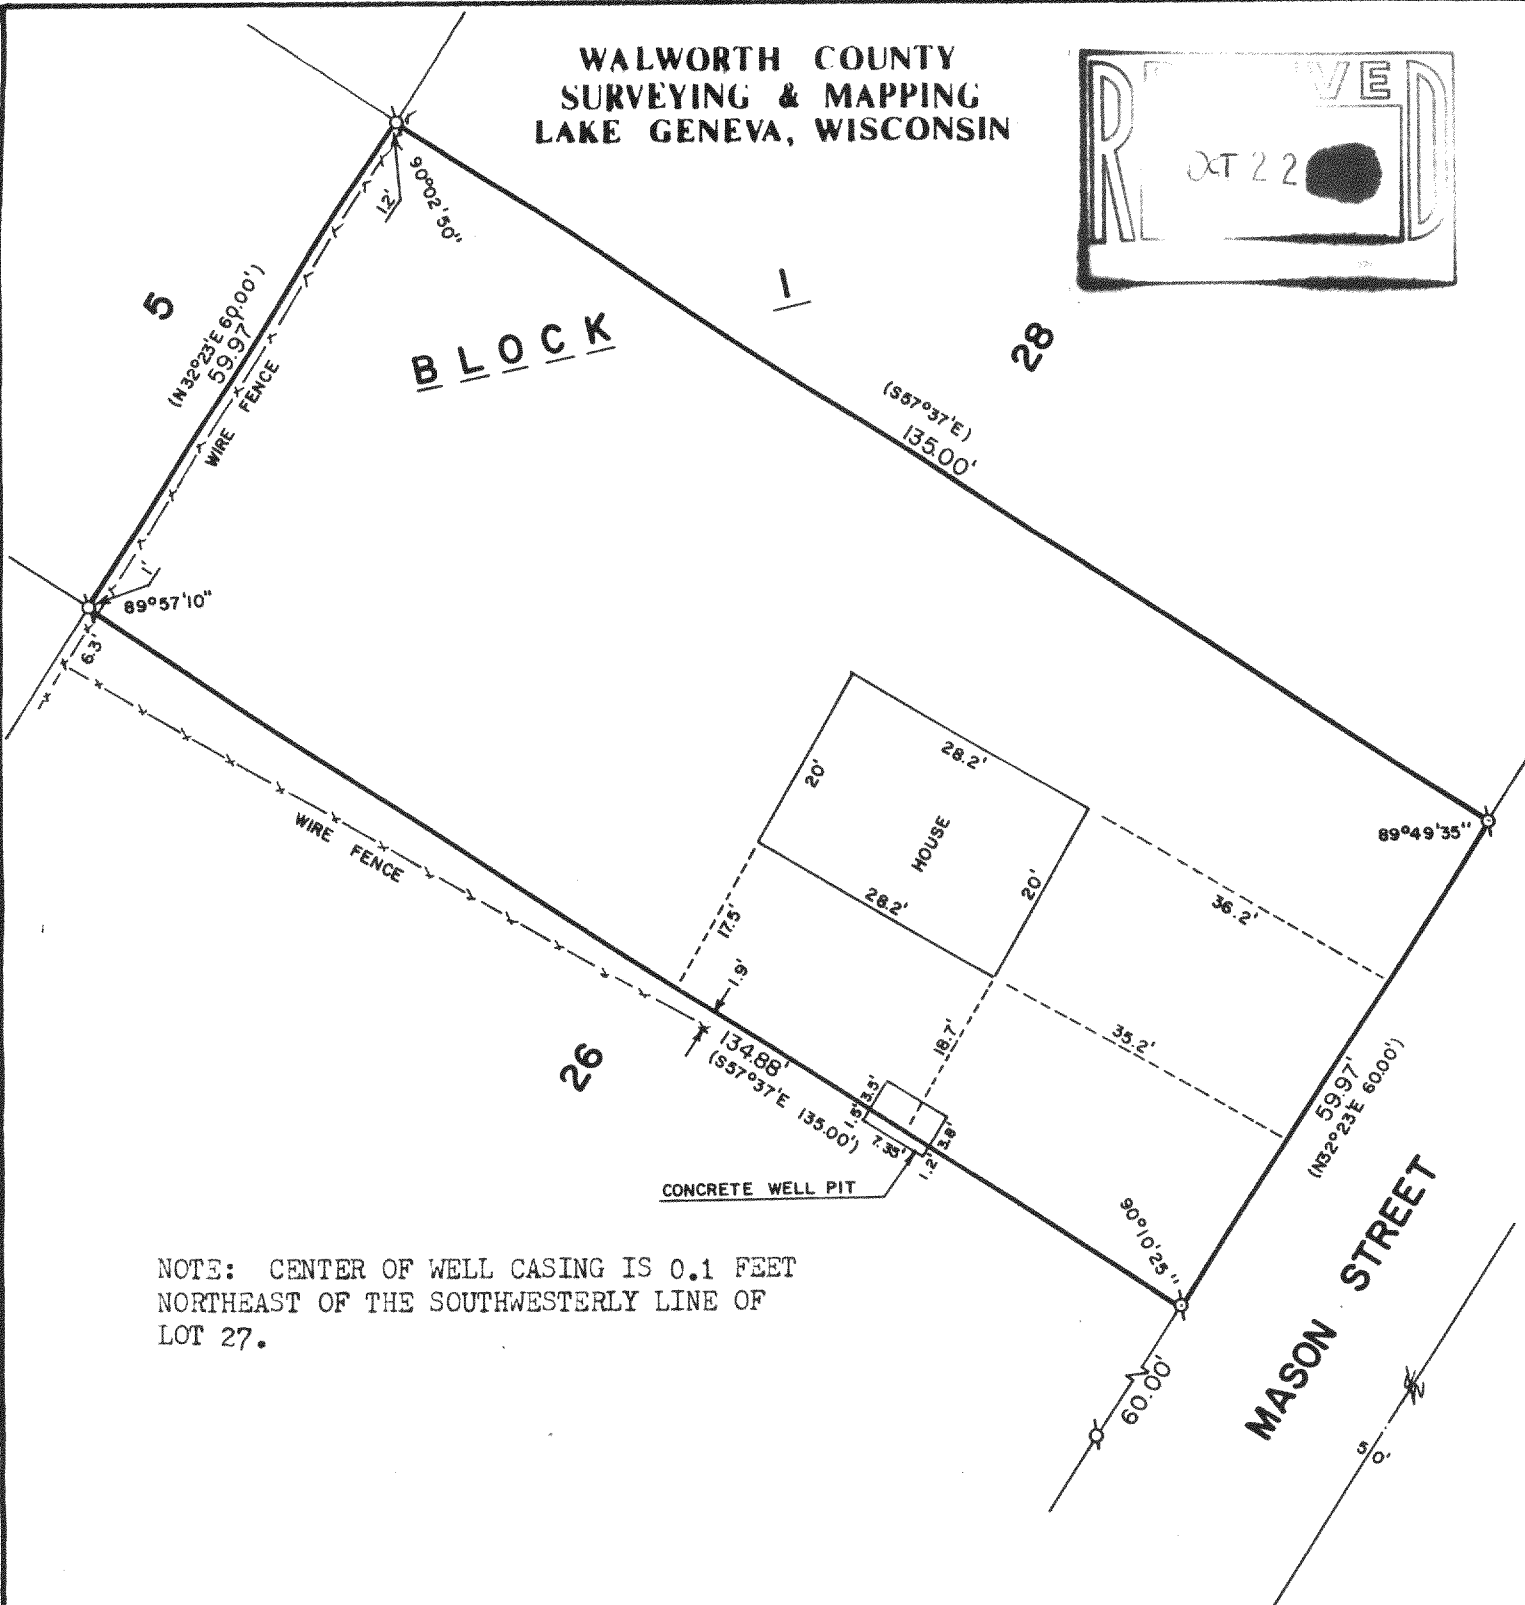


WALWORTH COUNTY
SURVEYING & MAPPING
LAKE GENEVA, WISCONSIN

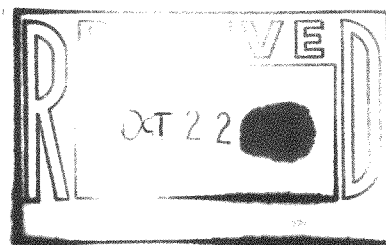


NOTE: CENTER OF WELL CASING IS 0.1 FEET
NORTHEAST OF THE SOUTHWESTERLY LINE OF
LOT 27.

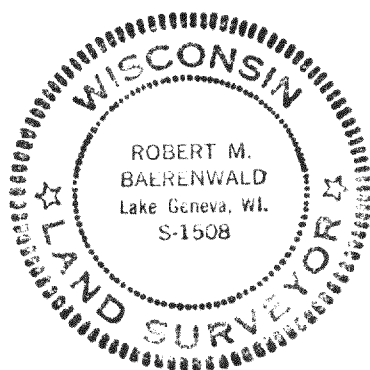

PLAT OF SURVEY OF

LOT 27, BLOCK 1 OF DELMAR SUBDIVISION,
LOCATED IN SECTION 27, T 2 N, R 16 E,
WALWORTH COUNTY, WISCONSIN.

ORDERED BY: MRS. WILLIAM WHALING
37 ORCHARD STREET
HILLSIDE, ILLINOIS 60162

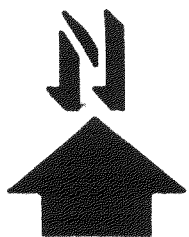

SCALE: 1"=20'

⊕-IRON PIPE FOUND
(-)-RECORDED AS

I, ROBERT M. BAERENWALD, DO HEREBY CERTIFY THAT I
HAVE SURVEYED THE PROPERTY HEREON DESCRIBED ACCORDING
TO THE OFFICIAL RECORDS AND THAT THE PLAT HEREON IS A
CORRECT REPRESENTATION OF THE PROPERTY LINES TO THE
BEST OF MY KNOWLEDGE AND BELIEF.

Robert M. Baerenwald
ROBERT M. BAERENWALD
WISCONSIN REGISTERED LAND SURVEYOR, S-1508

Oct. 26, 1985
DATE JOB NO. 0409