


FOUND CONCRETE MONUMENT 155' NORTH OF THE NORTHEAST CORNER OF SECTION 31.
TOWN 2 NORTH, RANGE 16 EAST

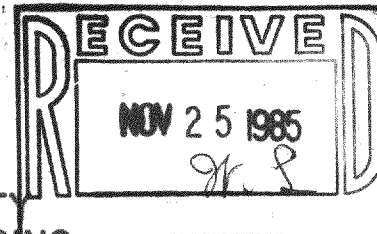

WALWORTH COUNTY
SURVEYING & MAPPING
727 HENRY STREET
LAKE GENEVA, WISCONSIN
414-248-0505

PLAT OF SURVEY OF

A PARCEL OF LAND LOCATED IN LOT 9 OF CHICAGO CLUB, A SUBDIVISION LOCATED IN THE NORTHEAST 1/4 OF SECTION 31, T 2 N, R 16 E, WALWORTH COUNTY, WISCONSIN AND DESCRIBED AS FOLLOWS: COMMENCING AT THE NORTHEAST CORNER OF LOT 9 OF CHICAGO CLUB SUBDIVISION, WHICH SUBDIVISION IS LOCATED IN SECTION 31, TOWNSHIP 2 NORTH, RANGE 16 EAST, WALWORTH COUNTY, WISCONSIN, THENCE SOUTH ALONG THE EAST LINE OF SAID LOT, 90 FEET TO THE PLACE OF BEGINNING; THENCE WEST 64.65 FEET; THENCE SOUTH 101.48 FEET TO A STAKE; THENCE CONTINUING SOUTH 8 FEET TO THE SHORE OF DELAVAN LAKE; THENCE NORTHEASTERLY ALONG SAID SHORE 62.8 FEET TO THE SOUTHEAST CORNER OF SAID LOT 9; THENCE NORTH ALONG THE EAST LINE OF SAID LOT 9, 93.0 FEET TO THE PLACE OF BEGINNING.


NOTE: THE ABOVE DESCRIPTION IS RECORDED AS DOC. NO. 317103, VOLUME 243, PAGES 562, 563 AND 564 OF LEADS, WALWORTH COUNTY, WISCONSIN.

SURVEY ORDERED BY: ROGER E. DUBA
1947 THORNWOOD AVENUE
WILMETTE, ILLINOIS 60091

I, ROBERT M. BAERENWALD, DO HEREBY CERTIFY THAT I HAVE SURVEYED THE PROPERTY HEREON DESCRIBED ACCORDING TO THE OFFICIAL RECORDS AND THAT THE PLAT HEREON IS A CORRECT REPRESENTATION OF THE PROPERTY LINES TO THE BEST OF MY KNOWLEDGE AND BELIEF.

Robert M. Baerenwald
ROBERT M. BAERENWALD
WISCONSIN REGISTERED LAND SURVEYOR, S-1508

DATE *July 30, 1985* JOB NO. 0294
REVISED: OCT. 1, 1985

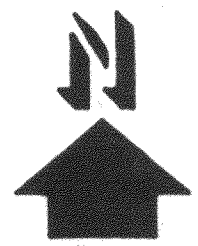

SCALE: 1"=10'

LEGEND

⊙ - IRON PIPE FOUND
() - RECORDED AS

