



DUNHAM SURVEYING, S.C.
SURVEYING & SUBDIVIDING
DELAVAN, WISCONSIN 53115

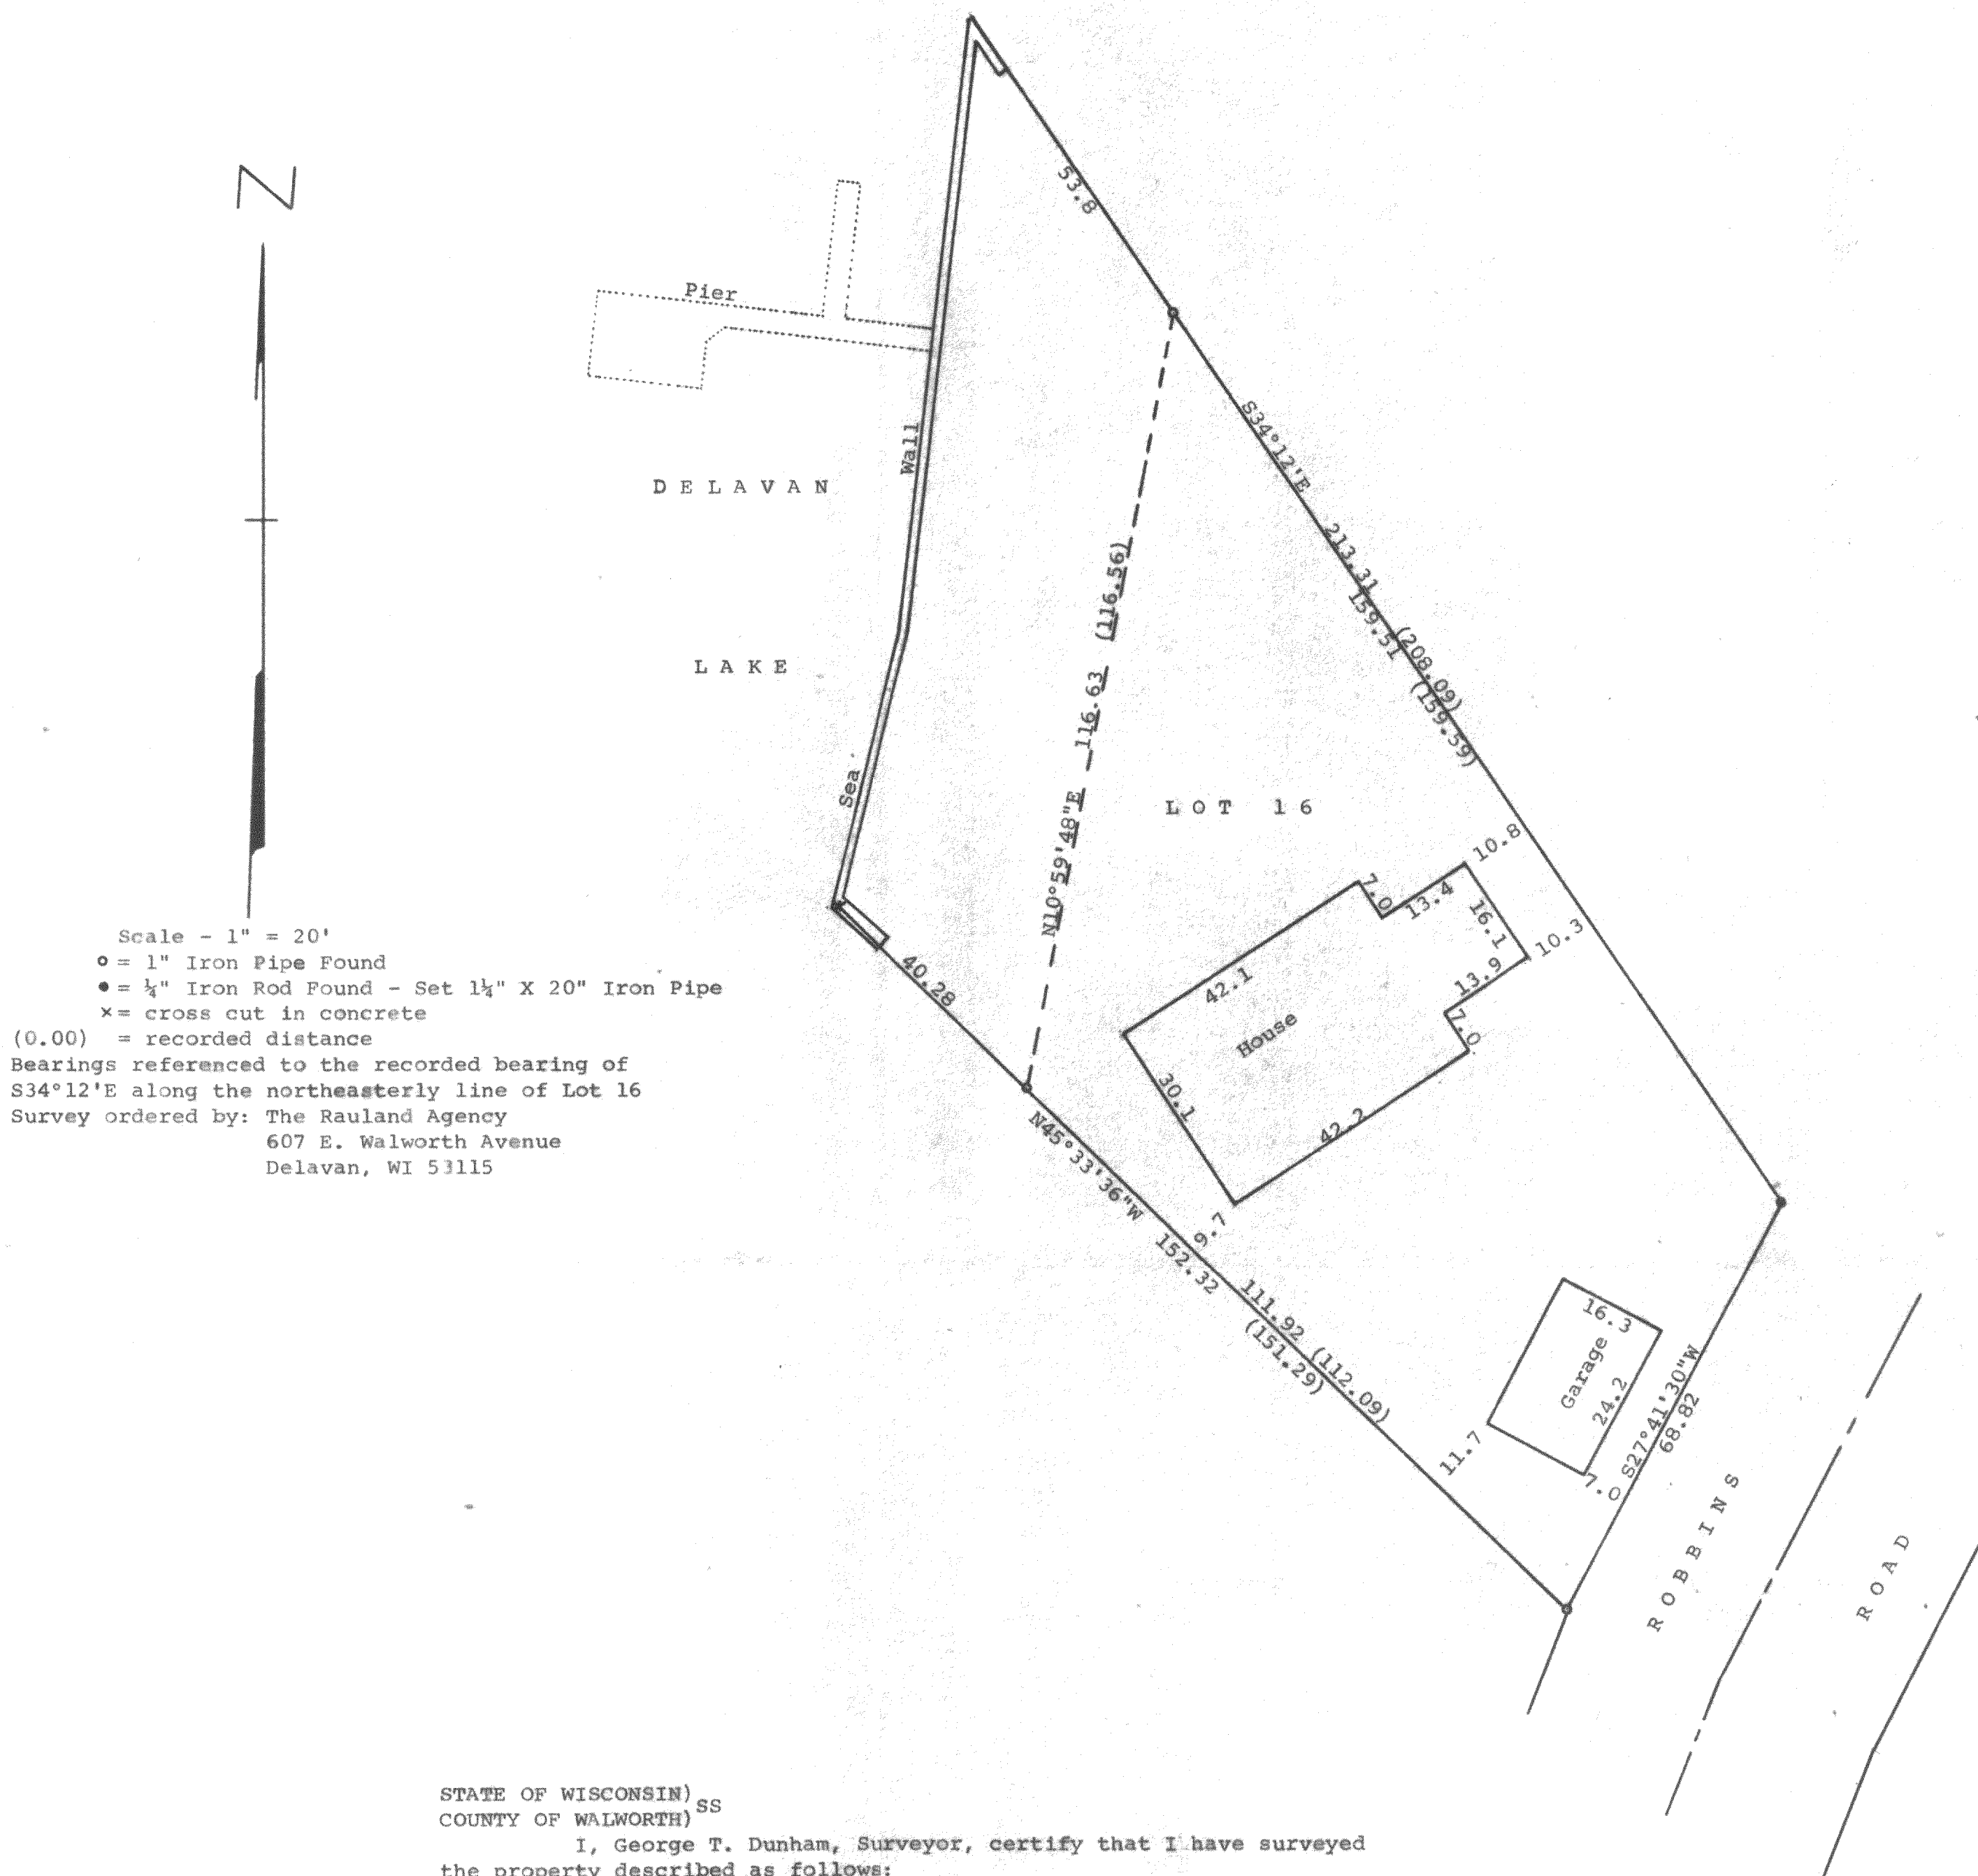

STATE OF WISCONSIN) SS
COUNTY OF WALWORTH)
I, George T. Dunham, Surveyor, certify that I have surveyed
the property described as follows:
Lot 16 in Block 1 of Sunny Dell Subdivision located in Fractional
Section 32, T 2 N, R 16 E, Walworth County, Wisconsin,
and that the map shown above is a true representation thereof and
shows the size and location of the property, its exterior boundaries,
the location of boundary fences, apparent easements, roadways and
visible encroachments, if any, and that I have surveyed the property
hereon described according to the official records to the best of my
knowledge and belief.
May 17, 1985

George T. Dunham
George T. Dunham, Surveyor

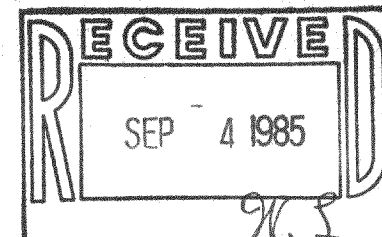