



DUNHAM SURVEYING, S.C.
SURVEYING & SUBDIVIDING
DELAVAN, WISCONSIN 53115

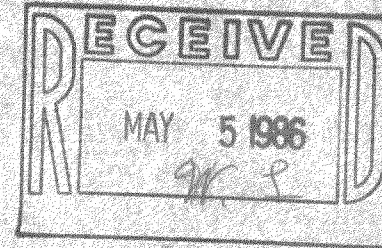

Scale - 1" = 20'
 • = 1" Iron Pipe Found
 x = 3/4" Iron Pipe Found
 o = 3/4" X 24" Iron Pipe Set
 (0.00) = Recorded Distance
 Bearings are referenced to the south-easterly line of Inlet Shore Drive, recorded bearing of N28°30'E
 Survey ordered by: Brian W. Riemer
 Attorney at Law
 601 E. Walworth Avenue
 Delavan, WI 53115

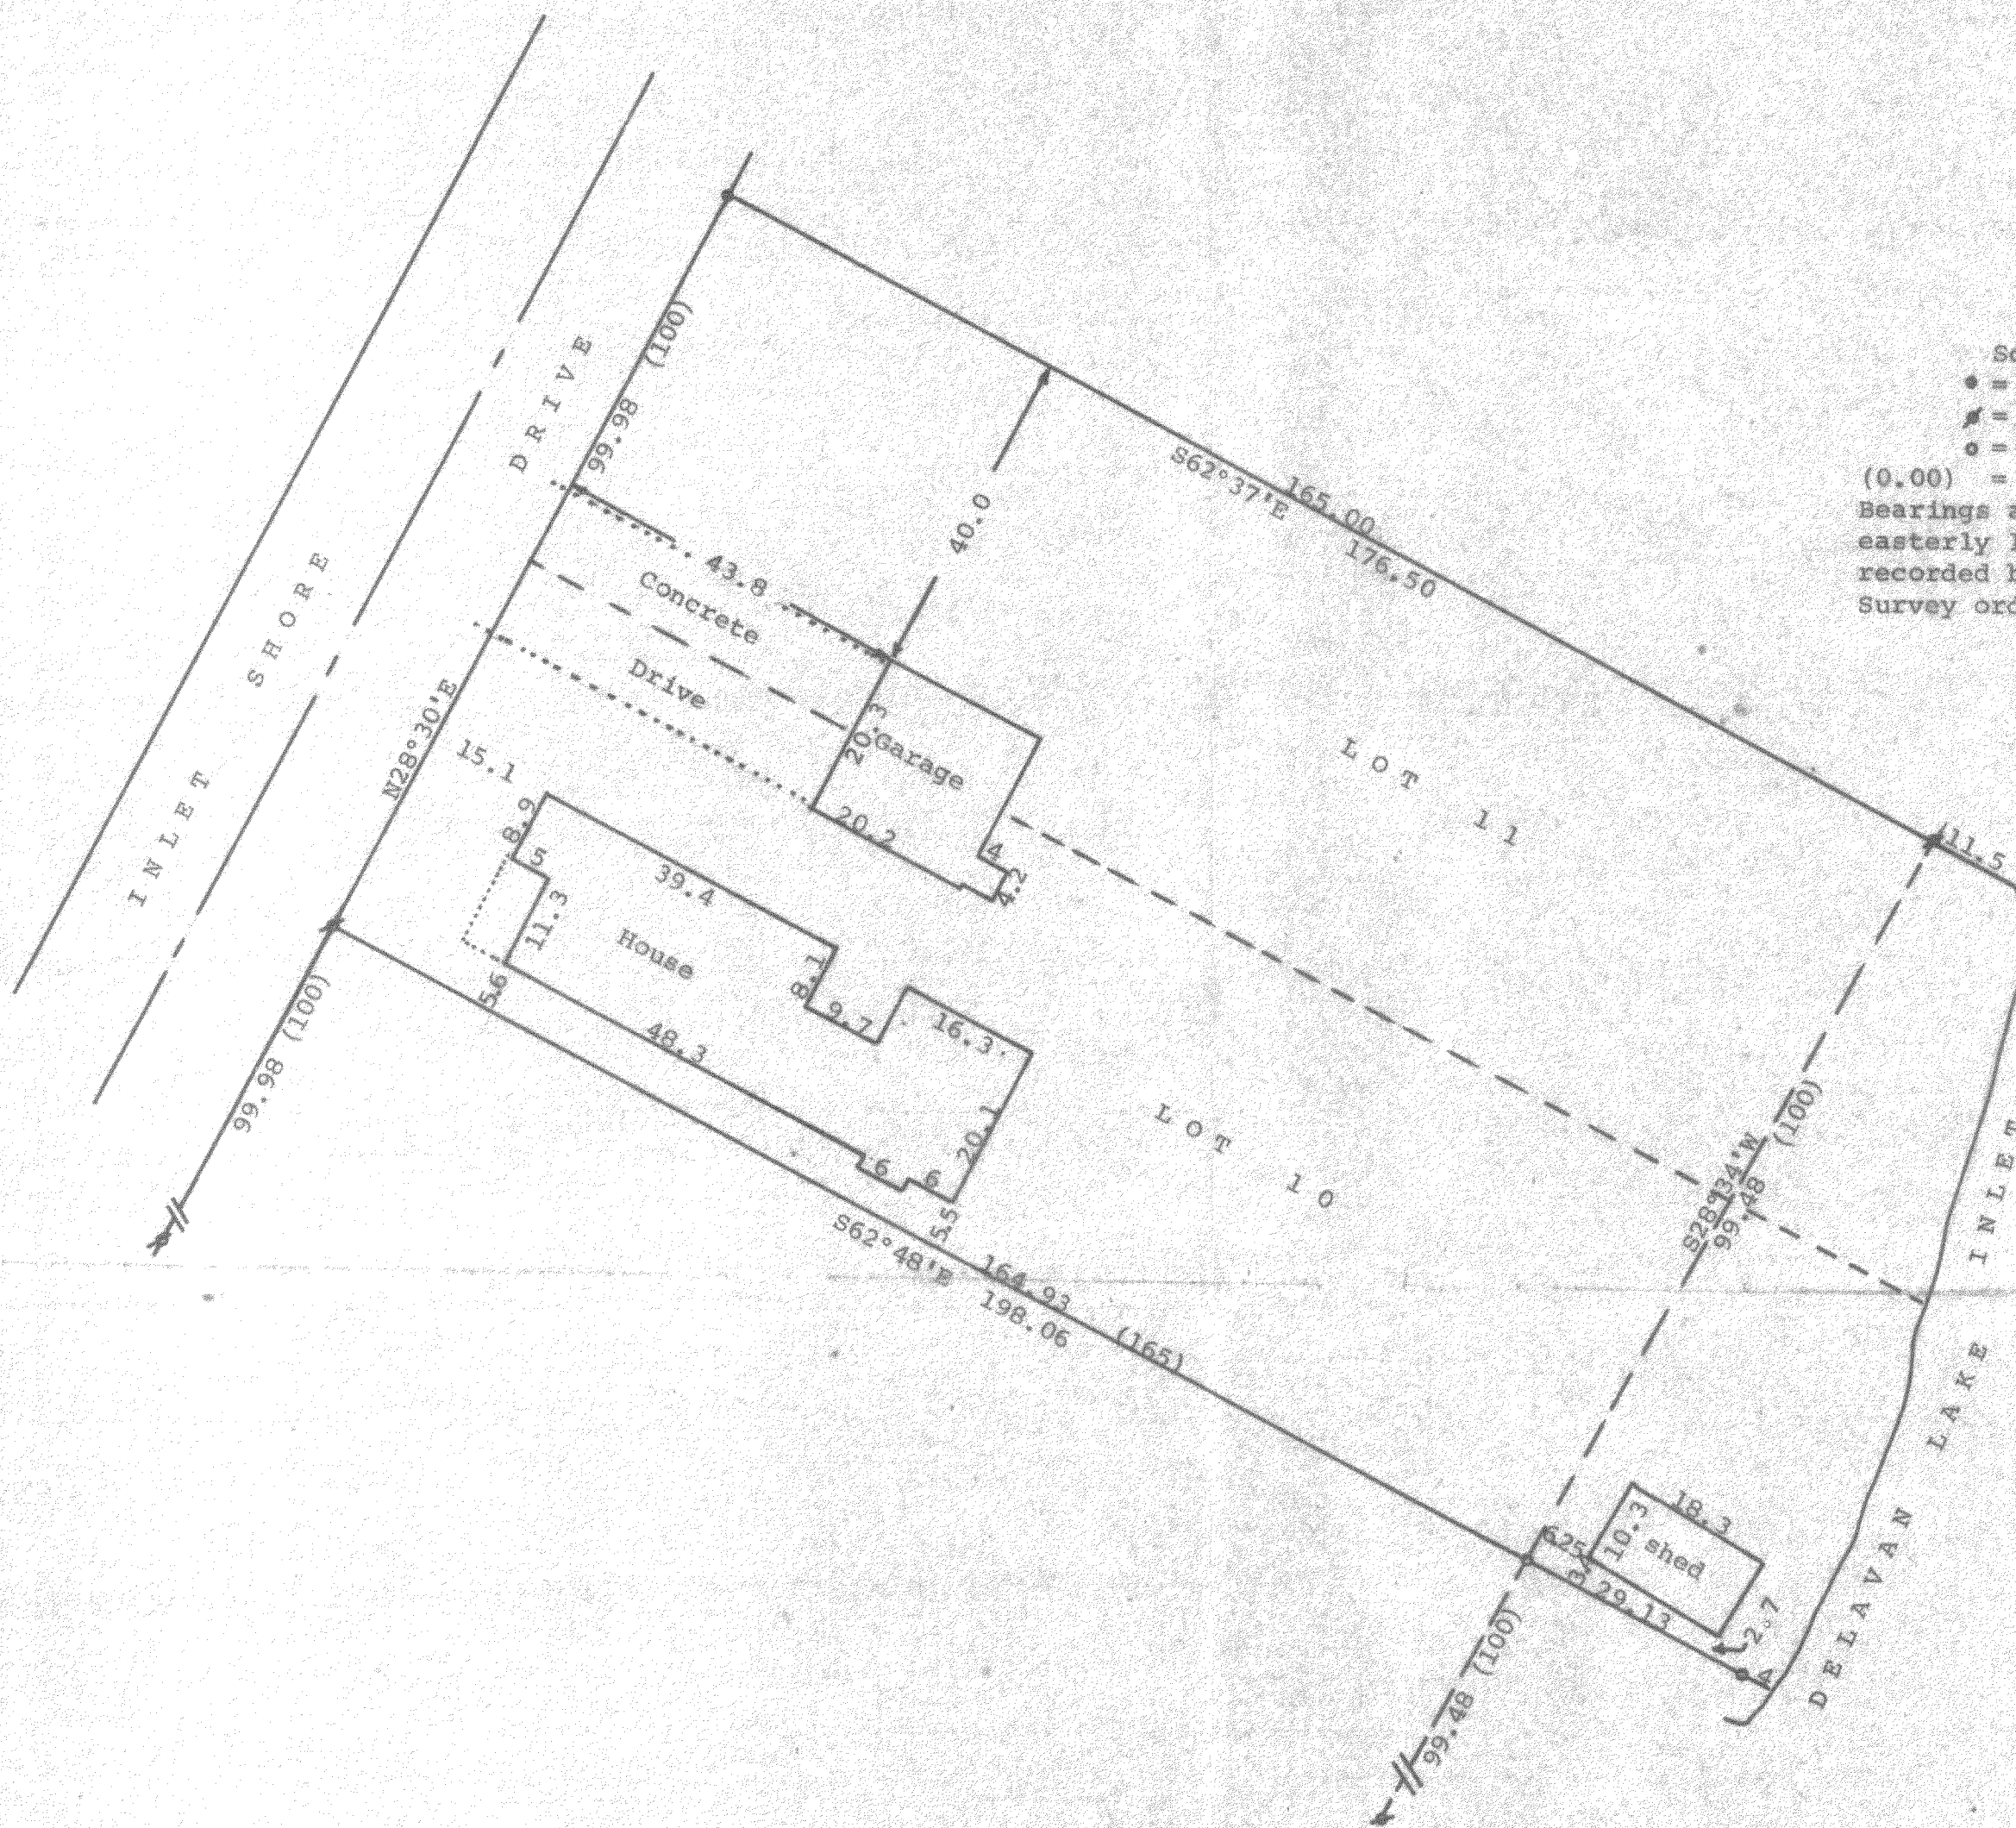

STATE OF WISCONSIN) SS
 COUNTY OF WALWORTH)

I, George T. Dunham, Surveyor, certify that I have surveyed the property described as follows:

Lots 10 and 11 in Block 1 of Inlet Oaks Subdivision, located in Section 22, T 2 N, R 16 E, Walworth County, Wisconsin, and that the above map is a true representation thereof and shows the size and location of the property, its exterior boundaries, the location of all visible structures and dimensions of all principal buildings thereon, boundary fences, apparent easements, roadways and visible encroachments, if any, and that I have surveyed the property hereon described according to the official records, to the best of my knowledge and belief.

January 24, 1986

George T. Dunham
 George T. Dunham, Surveyor

