
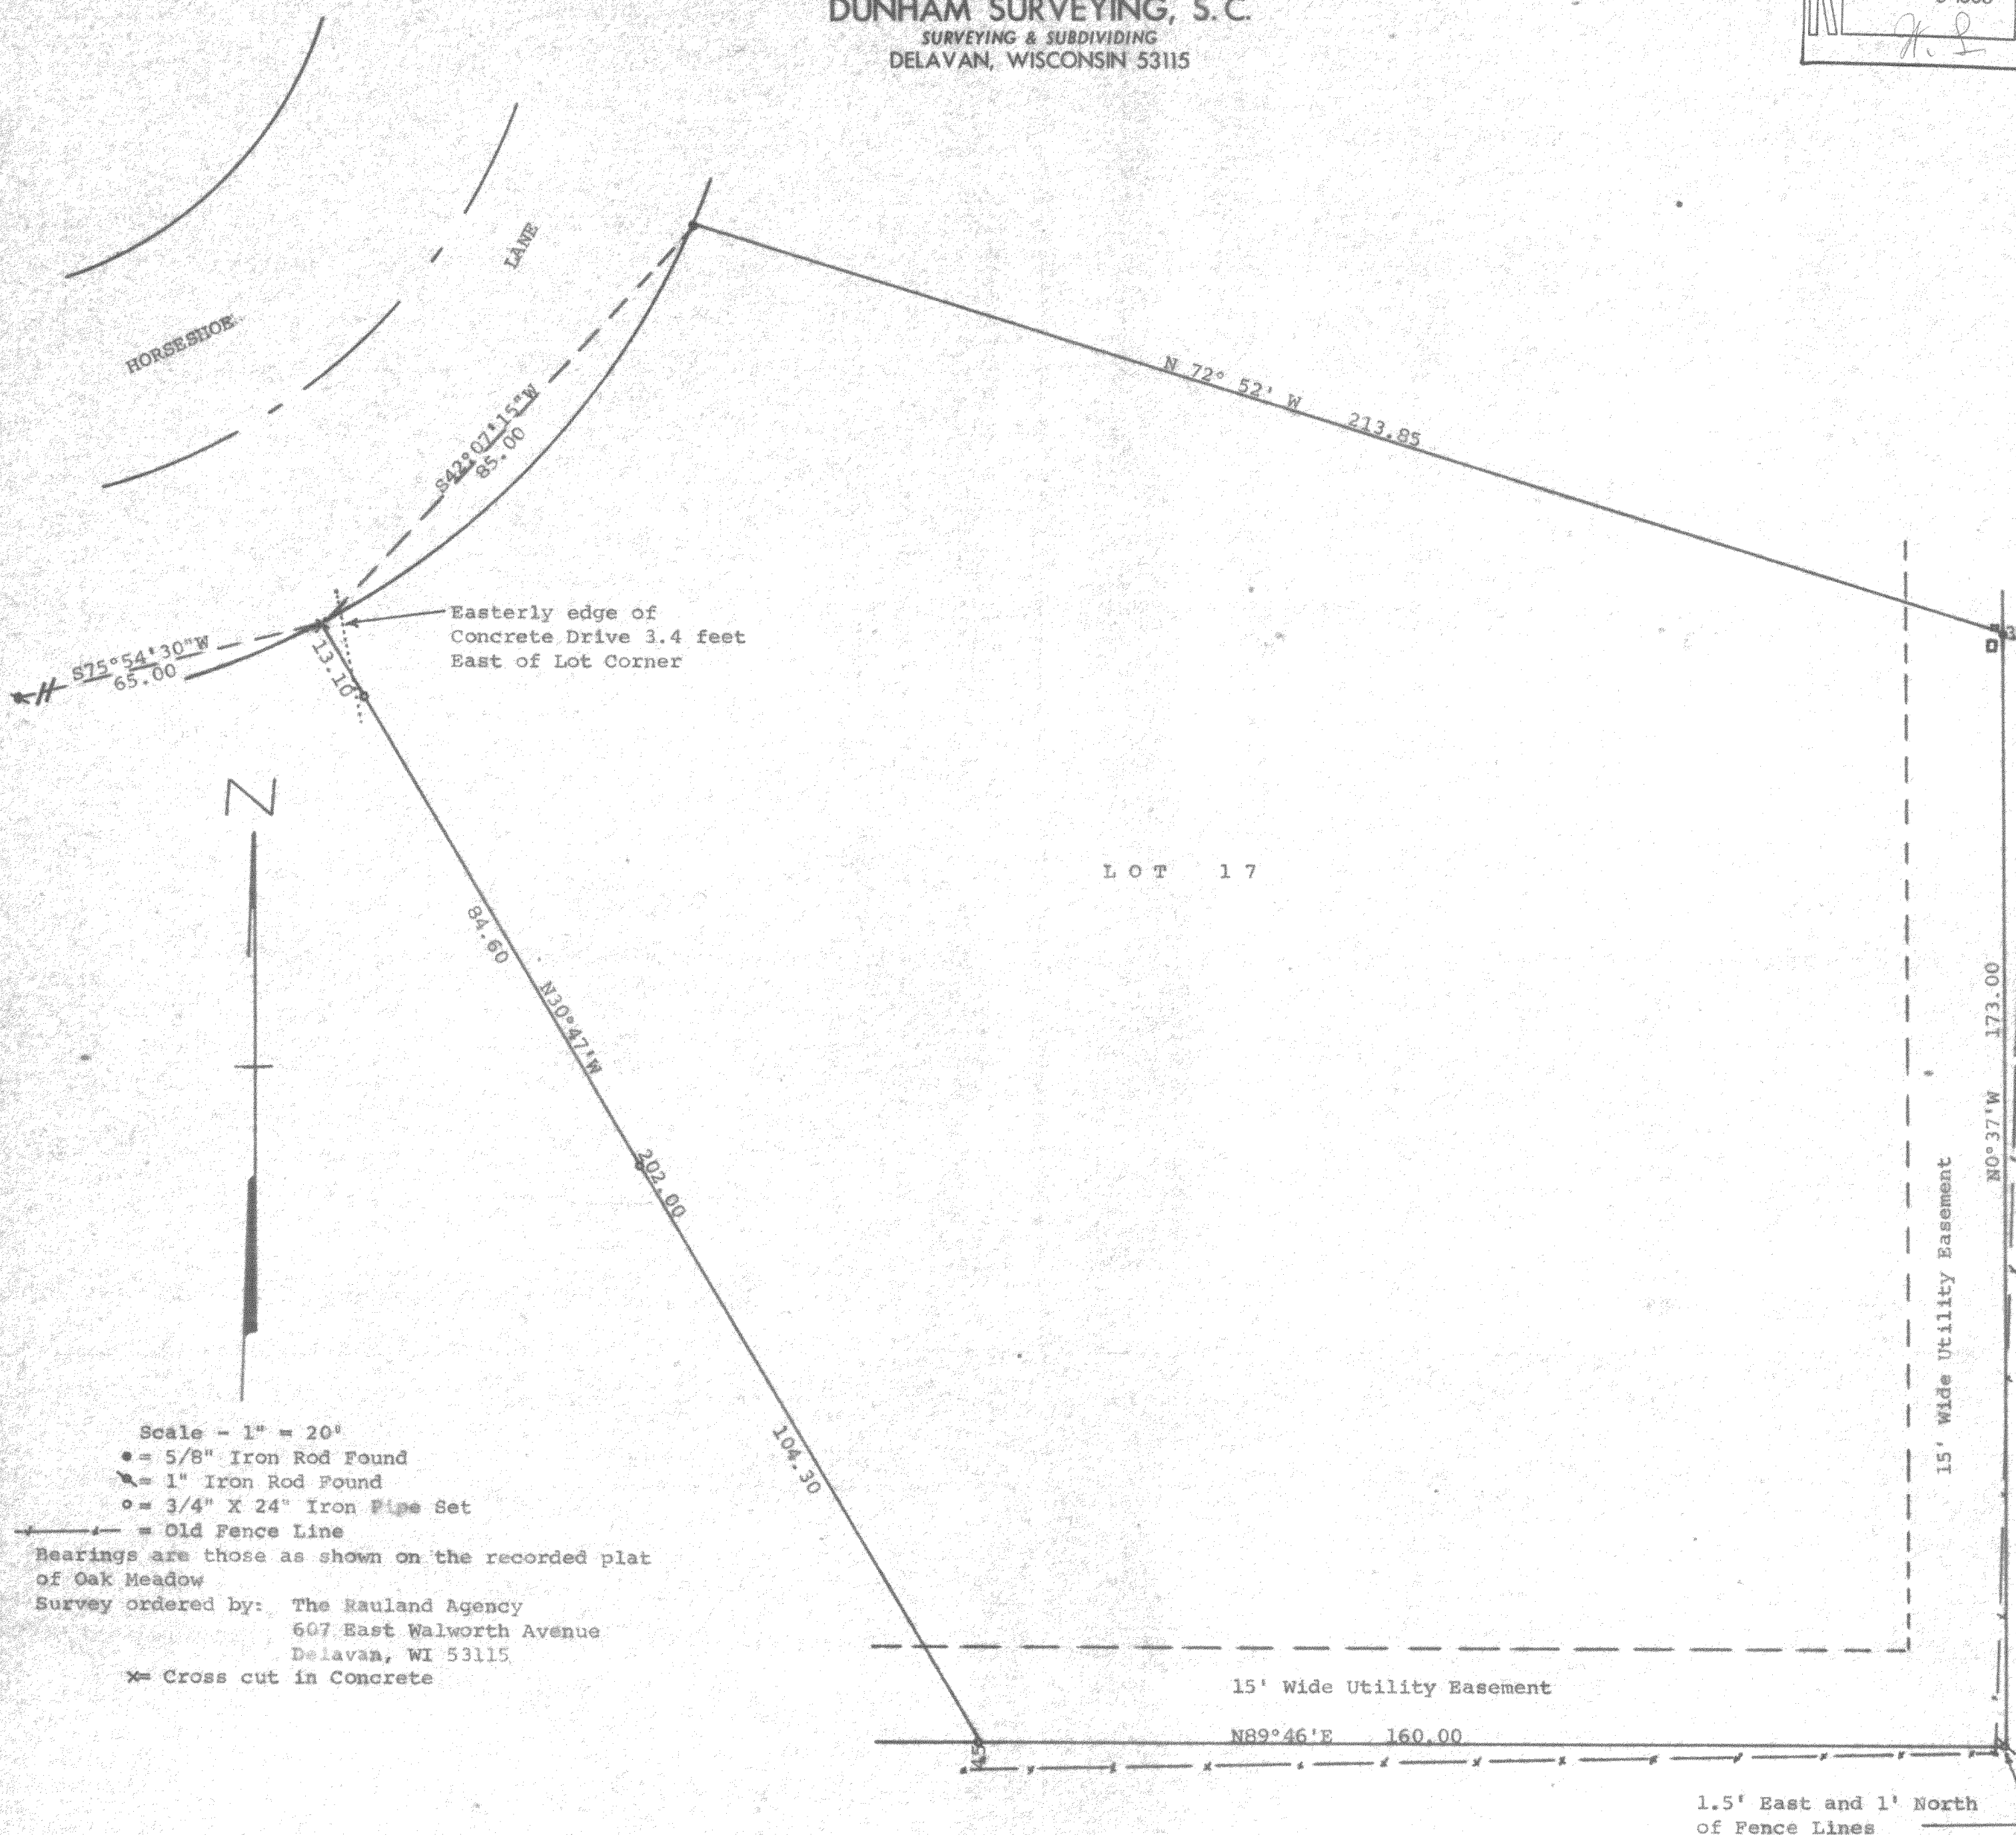


DUNHAM SURVEYING, S.C.
SURVEYING & SUBDIVIDING
DELAVER, WISCONSIN 53115

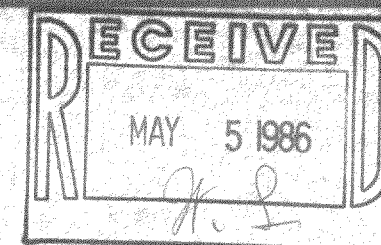

Scale - 1" = 20'
• = 5/8" Iron Rod Found
— = 1" Iron Rod Found
○ = 3/4" X 24" Iron Pipe Set
— = Old Fence Line
Bearings are those as shown on the recorded plat of Oak Meadow
Survey ordered by: The Rauland Agency
607 East Walworth Avenue
Delavan, WI 53115
X = Cross cut in Concrete

STATE OF WISCONSIN) ss
COUNTY OF WALWORTH)

I, George T. Dunham, Surveyor, certify that I have surveyed the property described as follows:

Lot 17 in Oak Meadow Subdivision, located in the Northeast 1/4 of Section 29, T 2 N, R 16 E, Walworth County, Wisconsin and that the above map is a true representation thereof and shows the size and location of the property, its exterior boundaries, the location of all visible structures and dimensions of all principal buildings thereon, boundary fences, apparent easements, roadways and visible encroachments, if any, and that I have surveyed the property hereon described according to the official records, to the best of my knowledge and belief.

April 9, 1986

George T. Dunham
George T. Dunham, Surveyor

