
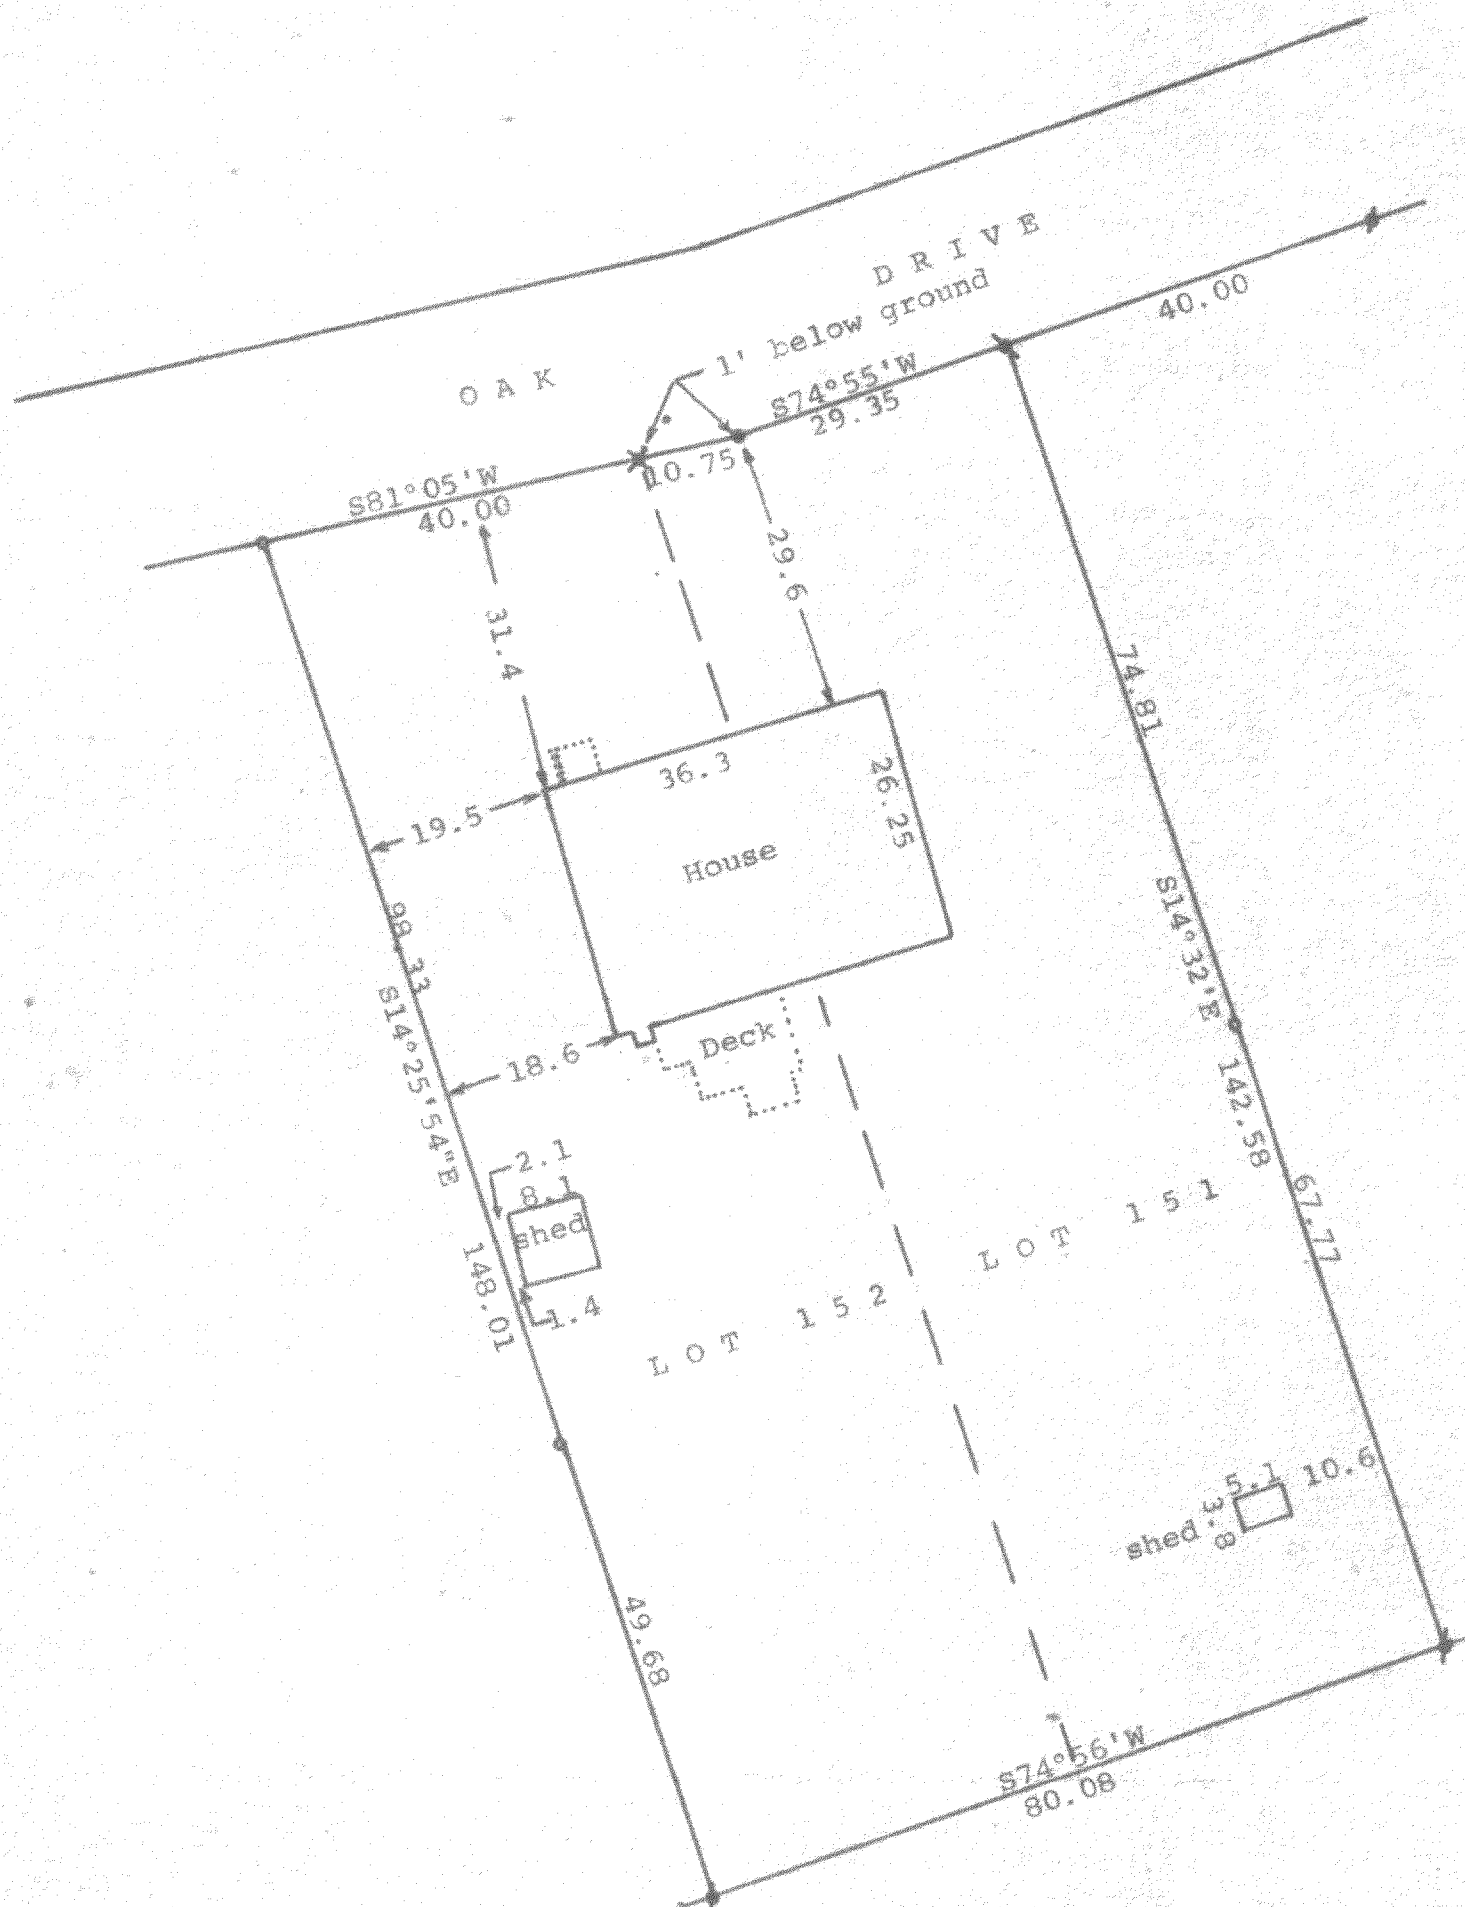


DUNHAM SURVEYING, S. C.
SURVEYING & SUBDIVIDING
DELAVER, WISCONSIN 53115

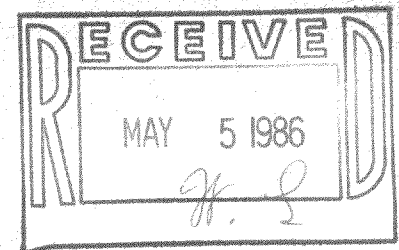

Scale - 1" = 20'
 • = 3/4" X 24" Iron Pipe Set
 • = Concrete Monument Found
 / = 1/2" Square Iron Rod Found
 X = 1 1/4" Iron Pipe Found
 Survey ordered by: Century 21 Skandia Realty Inc
 312 South 7th Street
 Delavan, WI 53115
 X = 1 1/4" X 24" iron Pipe Set
 Bearings referenced to the assumed bearing of
 S74°55'W along the northerly line of Lot 151

STATE OF WISCONSIN) SS
 COUNTY OF WALWORTH)

I, George T. Dunham, Surveyor, certify that I have surveyed
 the property described as follows:

Lots 151 and 152 of Krumhaar's 2nd Addition to Ravenswood,
 a subdivision located in Section 31, T 2 N, R 16 E, Walworth
 County, Wisconsin;

and that the above map is a true representation thereof and shows the
 size and location of the property, its exterior boundaries, the location
 of all visible structures and dimensions of all principal buildings
 thereon, boundary fences, apparent easements, roadways and visible
 encroachments, if any, and that I have surveyed the property hereon
 described according to the official records, to the best of my knowledge
 and belief.

April 9, 1986

George T. Dunham
 George T. Dunham, Surveyor

