


RECEIVED
MAY 5 1986
J. L.



March 25, 1986

George T. Dunham
George T. Dunham, Surveyor

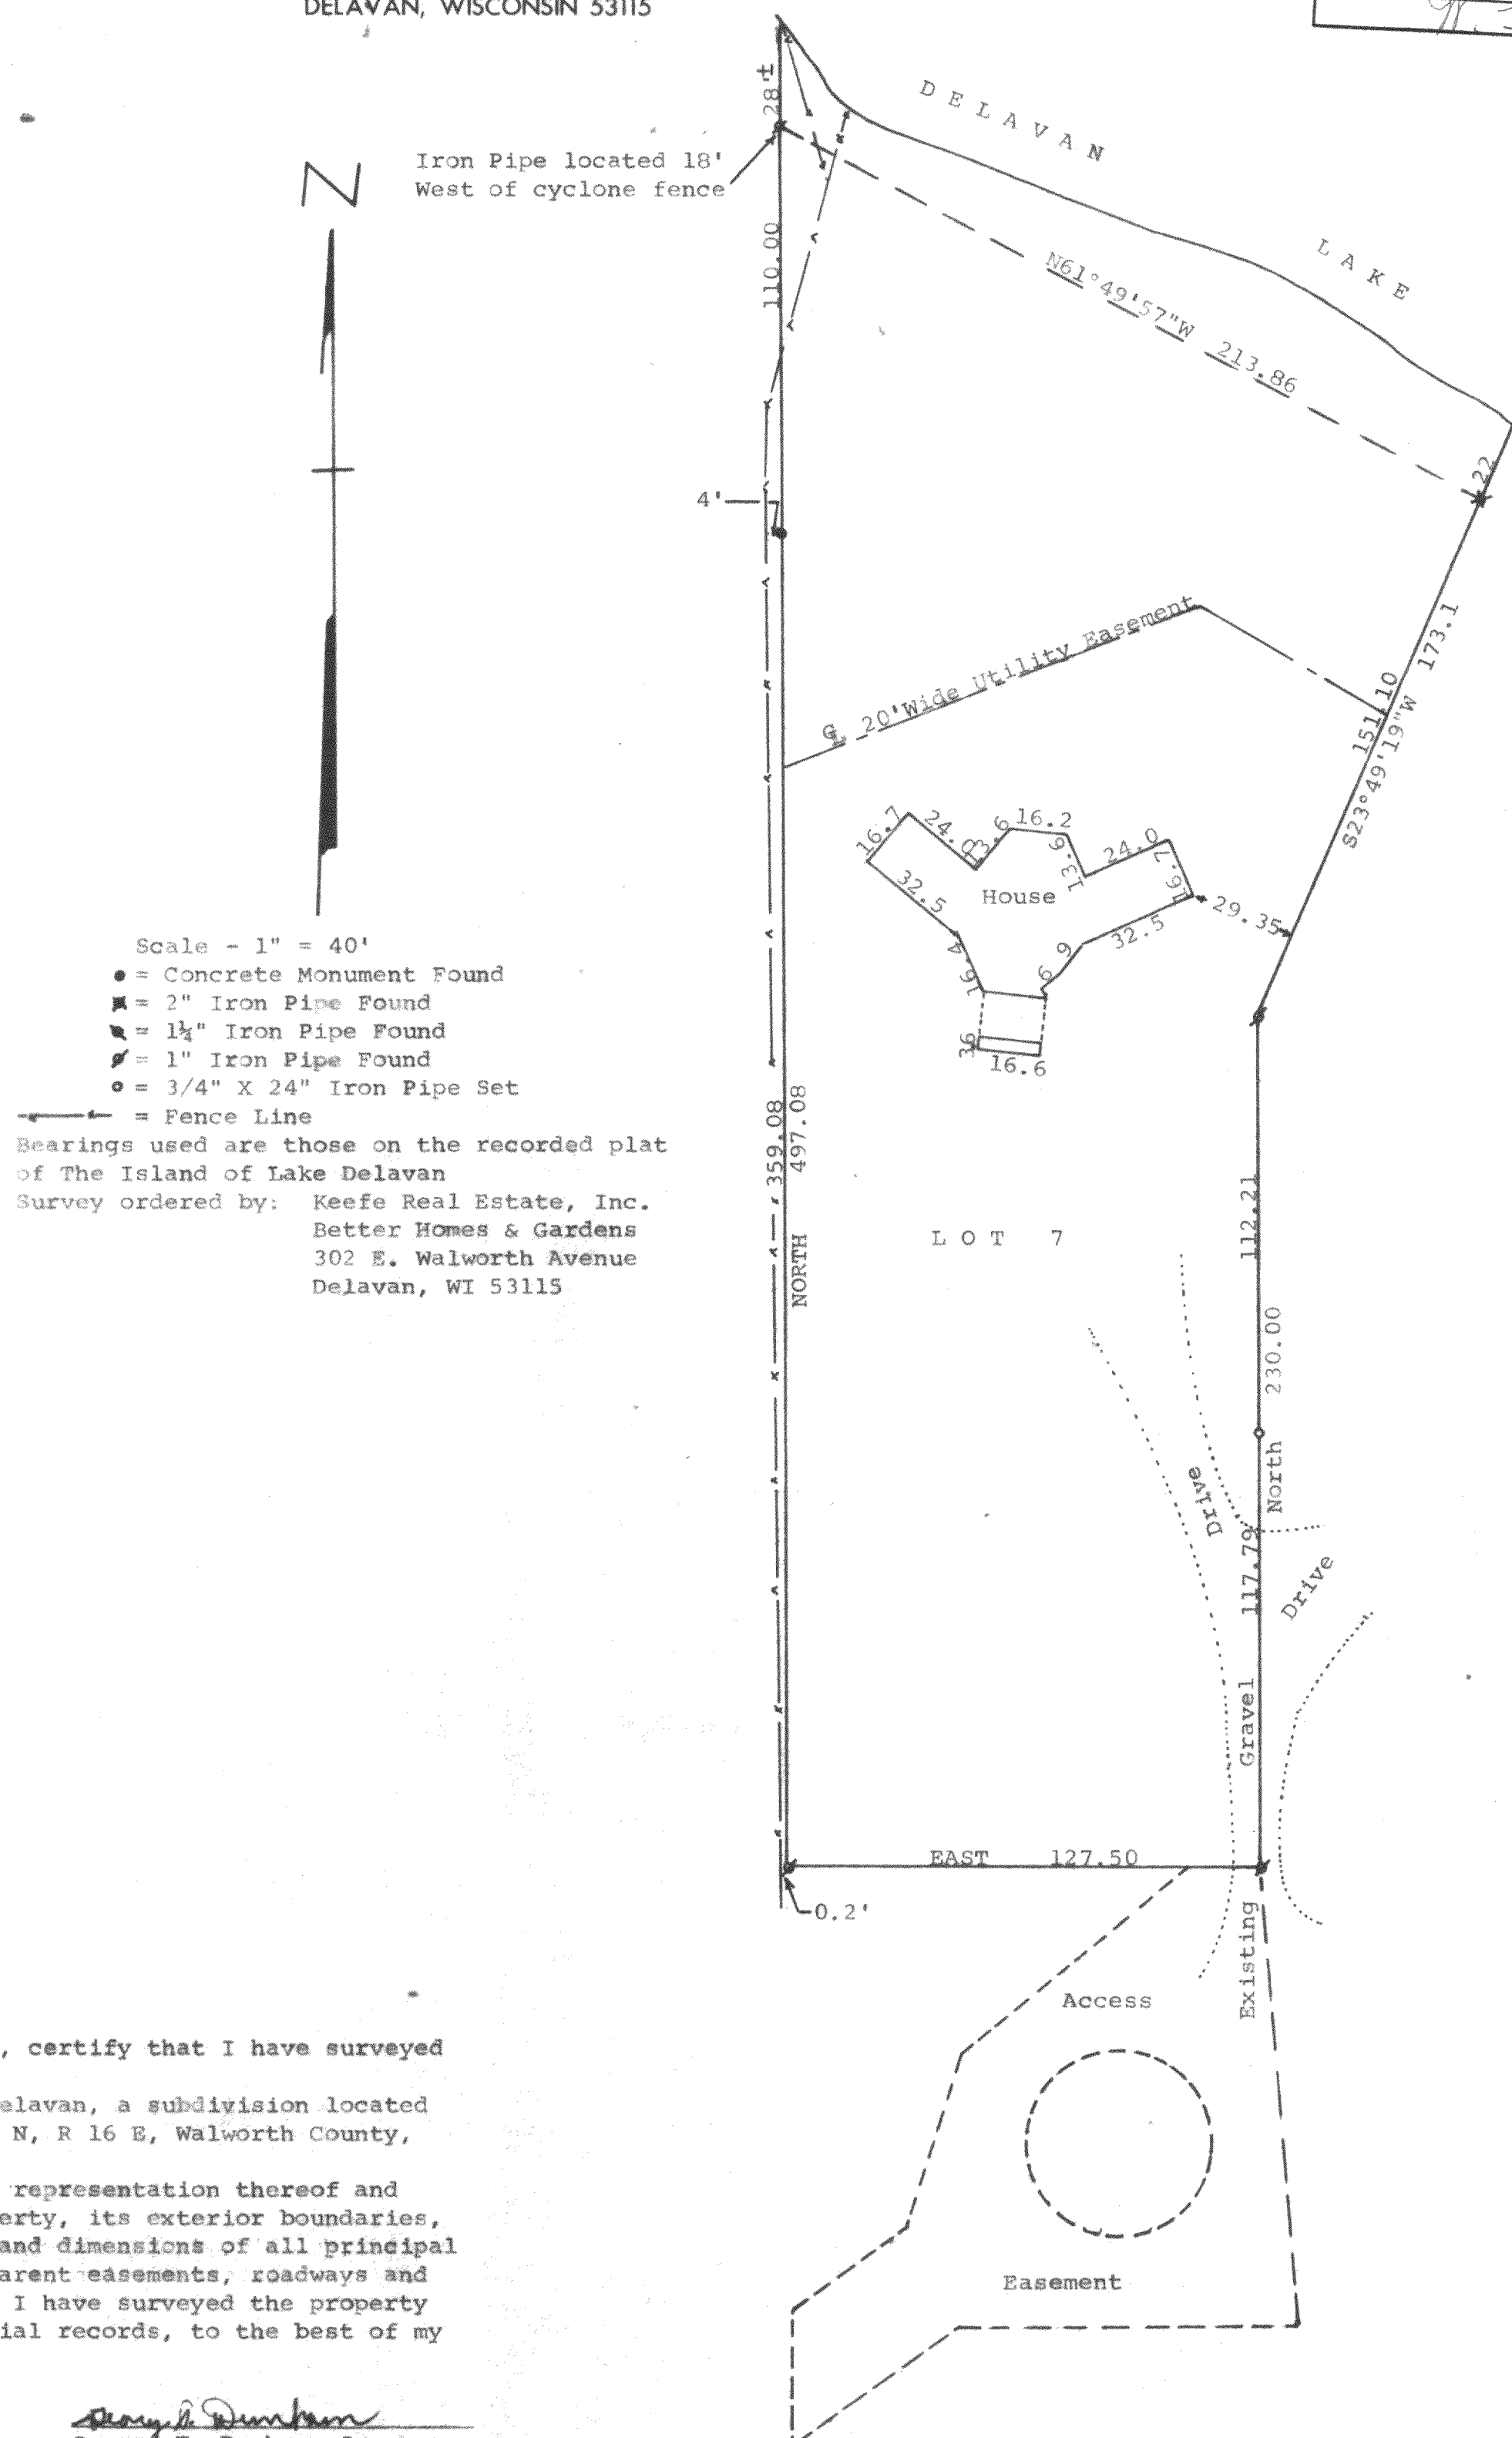