
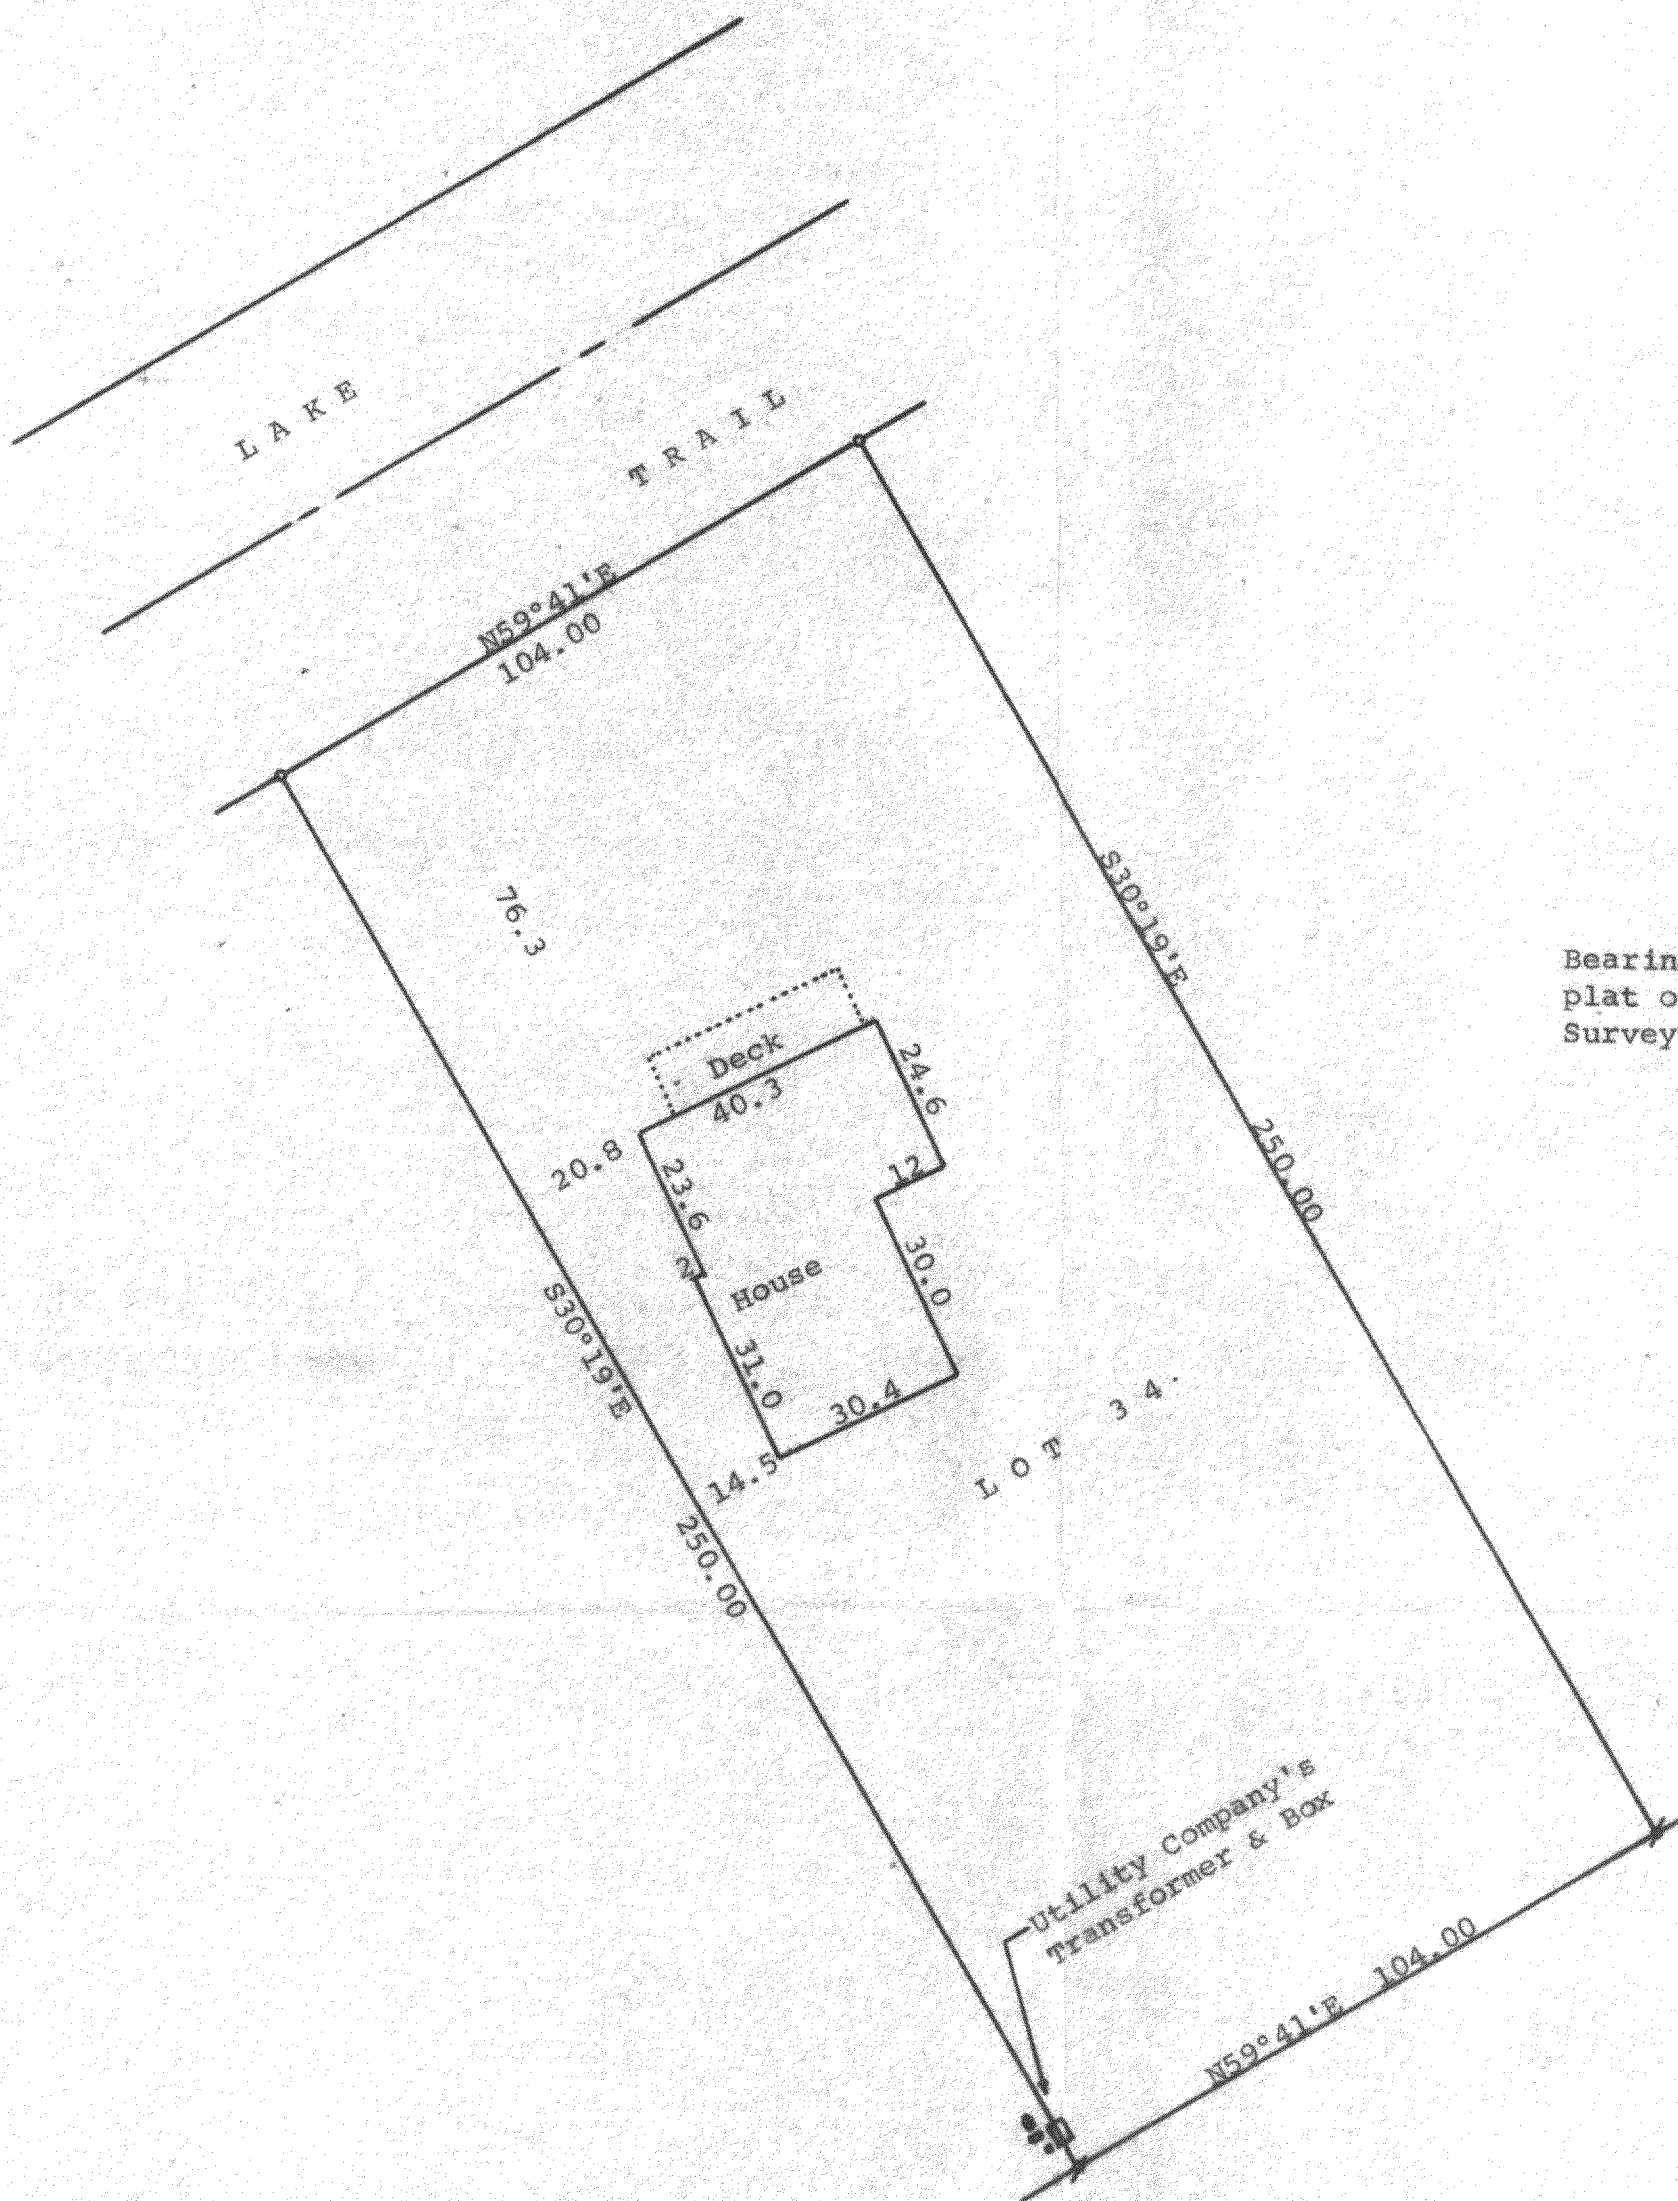


DUNHAM SURVEYING, S. C.
SURVEYING & SUBDIVIDING
DELAVER, WISCONSIN 53115

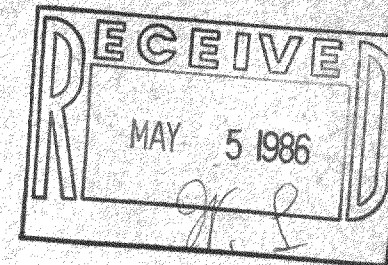

Scale - 1" = 30'

• = 1" Iron Pipe Found
• = 1 1/4" Iron Pipe Found

Bearings used are those as shown on the recorded plat of First Addition to Lakewood Estates

Survey ordered by: Kathleen Dragel
1823 Lake Trail
Delavan, WI 53115

STATE OF WISCONSIN)
COUNTY OF WALWORTH)

I, George T. Dunham, Surveyor, certify that I have surveyed the property described as follows:

Lot 34 in First Addition to Lakewood Estates, a subdivision located in Section 21, T 2 N, R 16 E, Walworth County, Wisconsin, and that the map shown above is a true representation thereof and shows the size and location of the property, its exterior boundaries, the location of all visible structures and dimensions of all principal buildings thereon, boundary fences, apparent easements, roadways and visible encroachments, if any, and that I have surveyed the property hereon described according to the official records, to the best of my knowledge and belief.
February 14, 1986

George T. Dunham
George T. Dunham, Surveyor

