

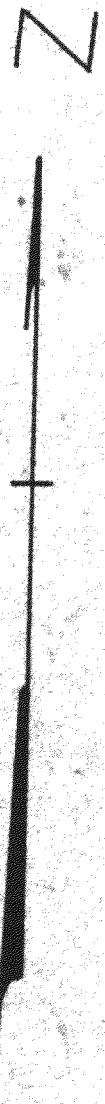


DUNHAM SURVEYING, S.C.
SURVEYING & SUBDIVIDING
DELAVAN, WISCONSIN 53115

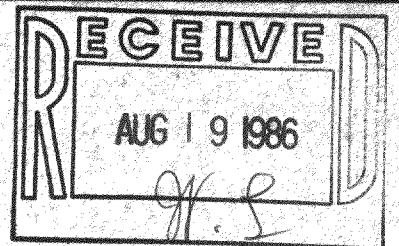

Scale - 1" = 20'
 / = 1/2" Iron Pipe Found
 \ = 3/4" Iron Pipe Found
 o = 3/4" Iron Pipe Set
 (0.00) = recorded distance

Bearings referenced to the previously recorded bearing of N65°38'E along the northwesterly line of Highland Drive
 Survey ordered by: Keefe Real Estate, Inc.
 Better Homes & Gardens
 302 East Walworth Avenue
 Delavan, WI 53115

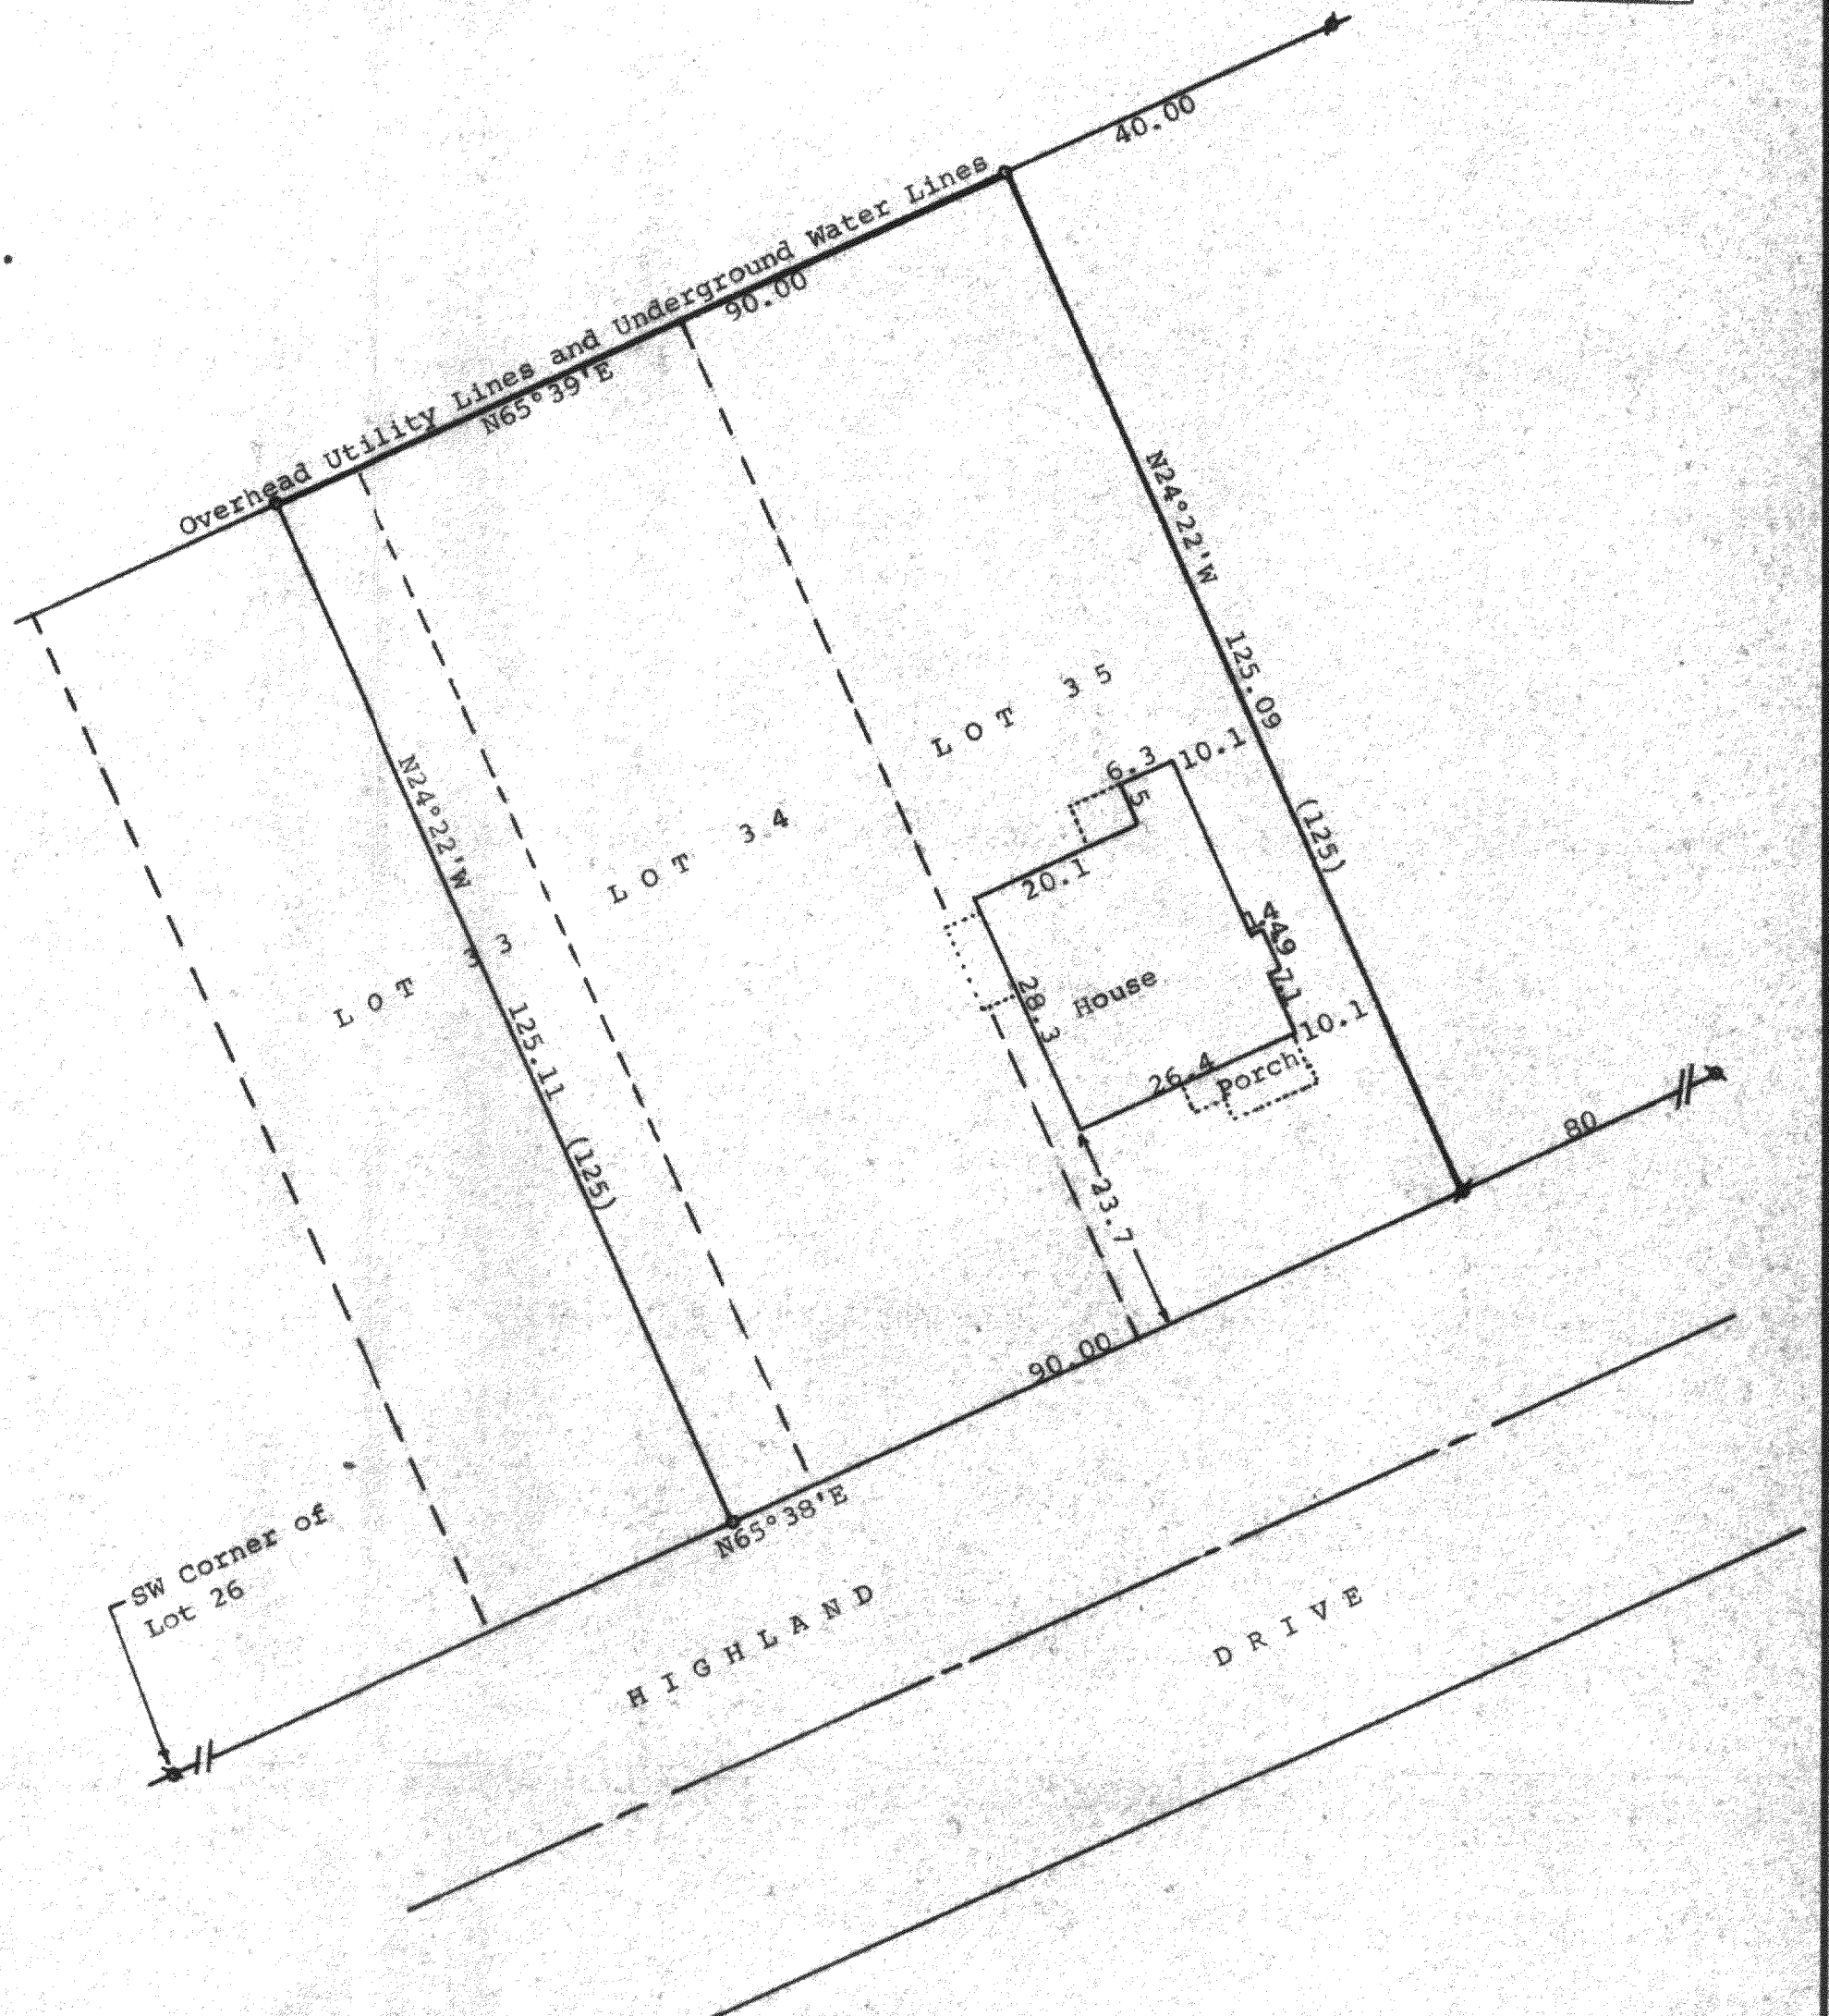

STATE OF WISCONSIN) SS
 COUNTY OF WALWORTH)

I, George T. Dunham, Surveyor, certify that I have surveyed the property described as follows:

The Easterly 10 feet of Lot 33, Lot 34 and Lot 35, Block 15 of Delavan Lake View Crest, a subdivision located in the North 1/2 of Section 31, T 2 N, R 16 E, Walworth County, Wisconsin, and that the map shown above is a true representation thereof and shows the size and location of the property, its exterior boundaries, the location of all visible structures and dimensions of all principal buildings thereon, boundary fences, apparent easements, roadways and visible encroachments, if any, and that I have surveyed the property hereon described according to the official records, to the best of my knowledge and belief.
 September 26, 1984

George T. Dunham
 George T. Dunham, Surveyor

