



DUNHAM SURVEYING, S.C.  
SURVEYING & SUBDIVIDING  
DELAVER, WISCONSIN 53115

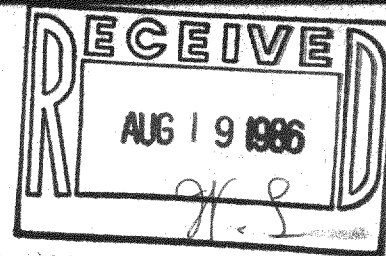

N

Scale - 1" = 20'  
• = 3/4" Iron Pipe Found  
• = 1" Iron Pipe Set  
Bearings used are those  
of record  
Survey ordered for:  
Biggan, Cowan, Marquardt  
& Lundberg  
Suite 2810  
180 N. LaSalle Street  
Chicago, IL 60601

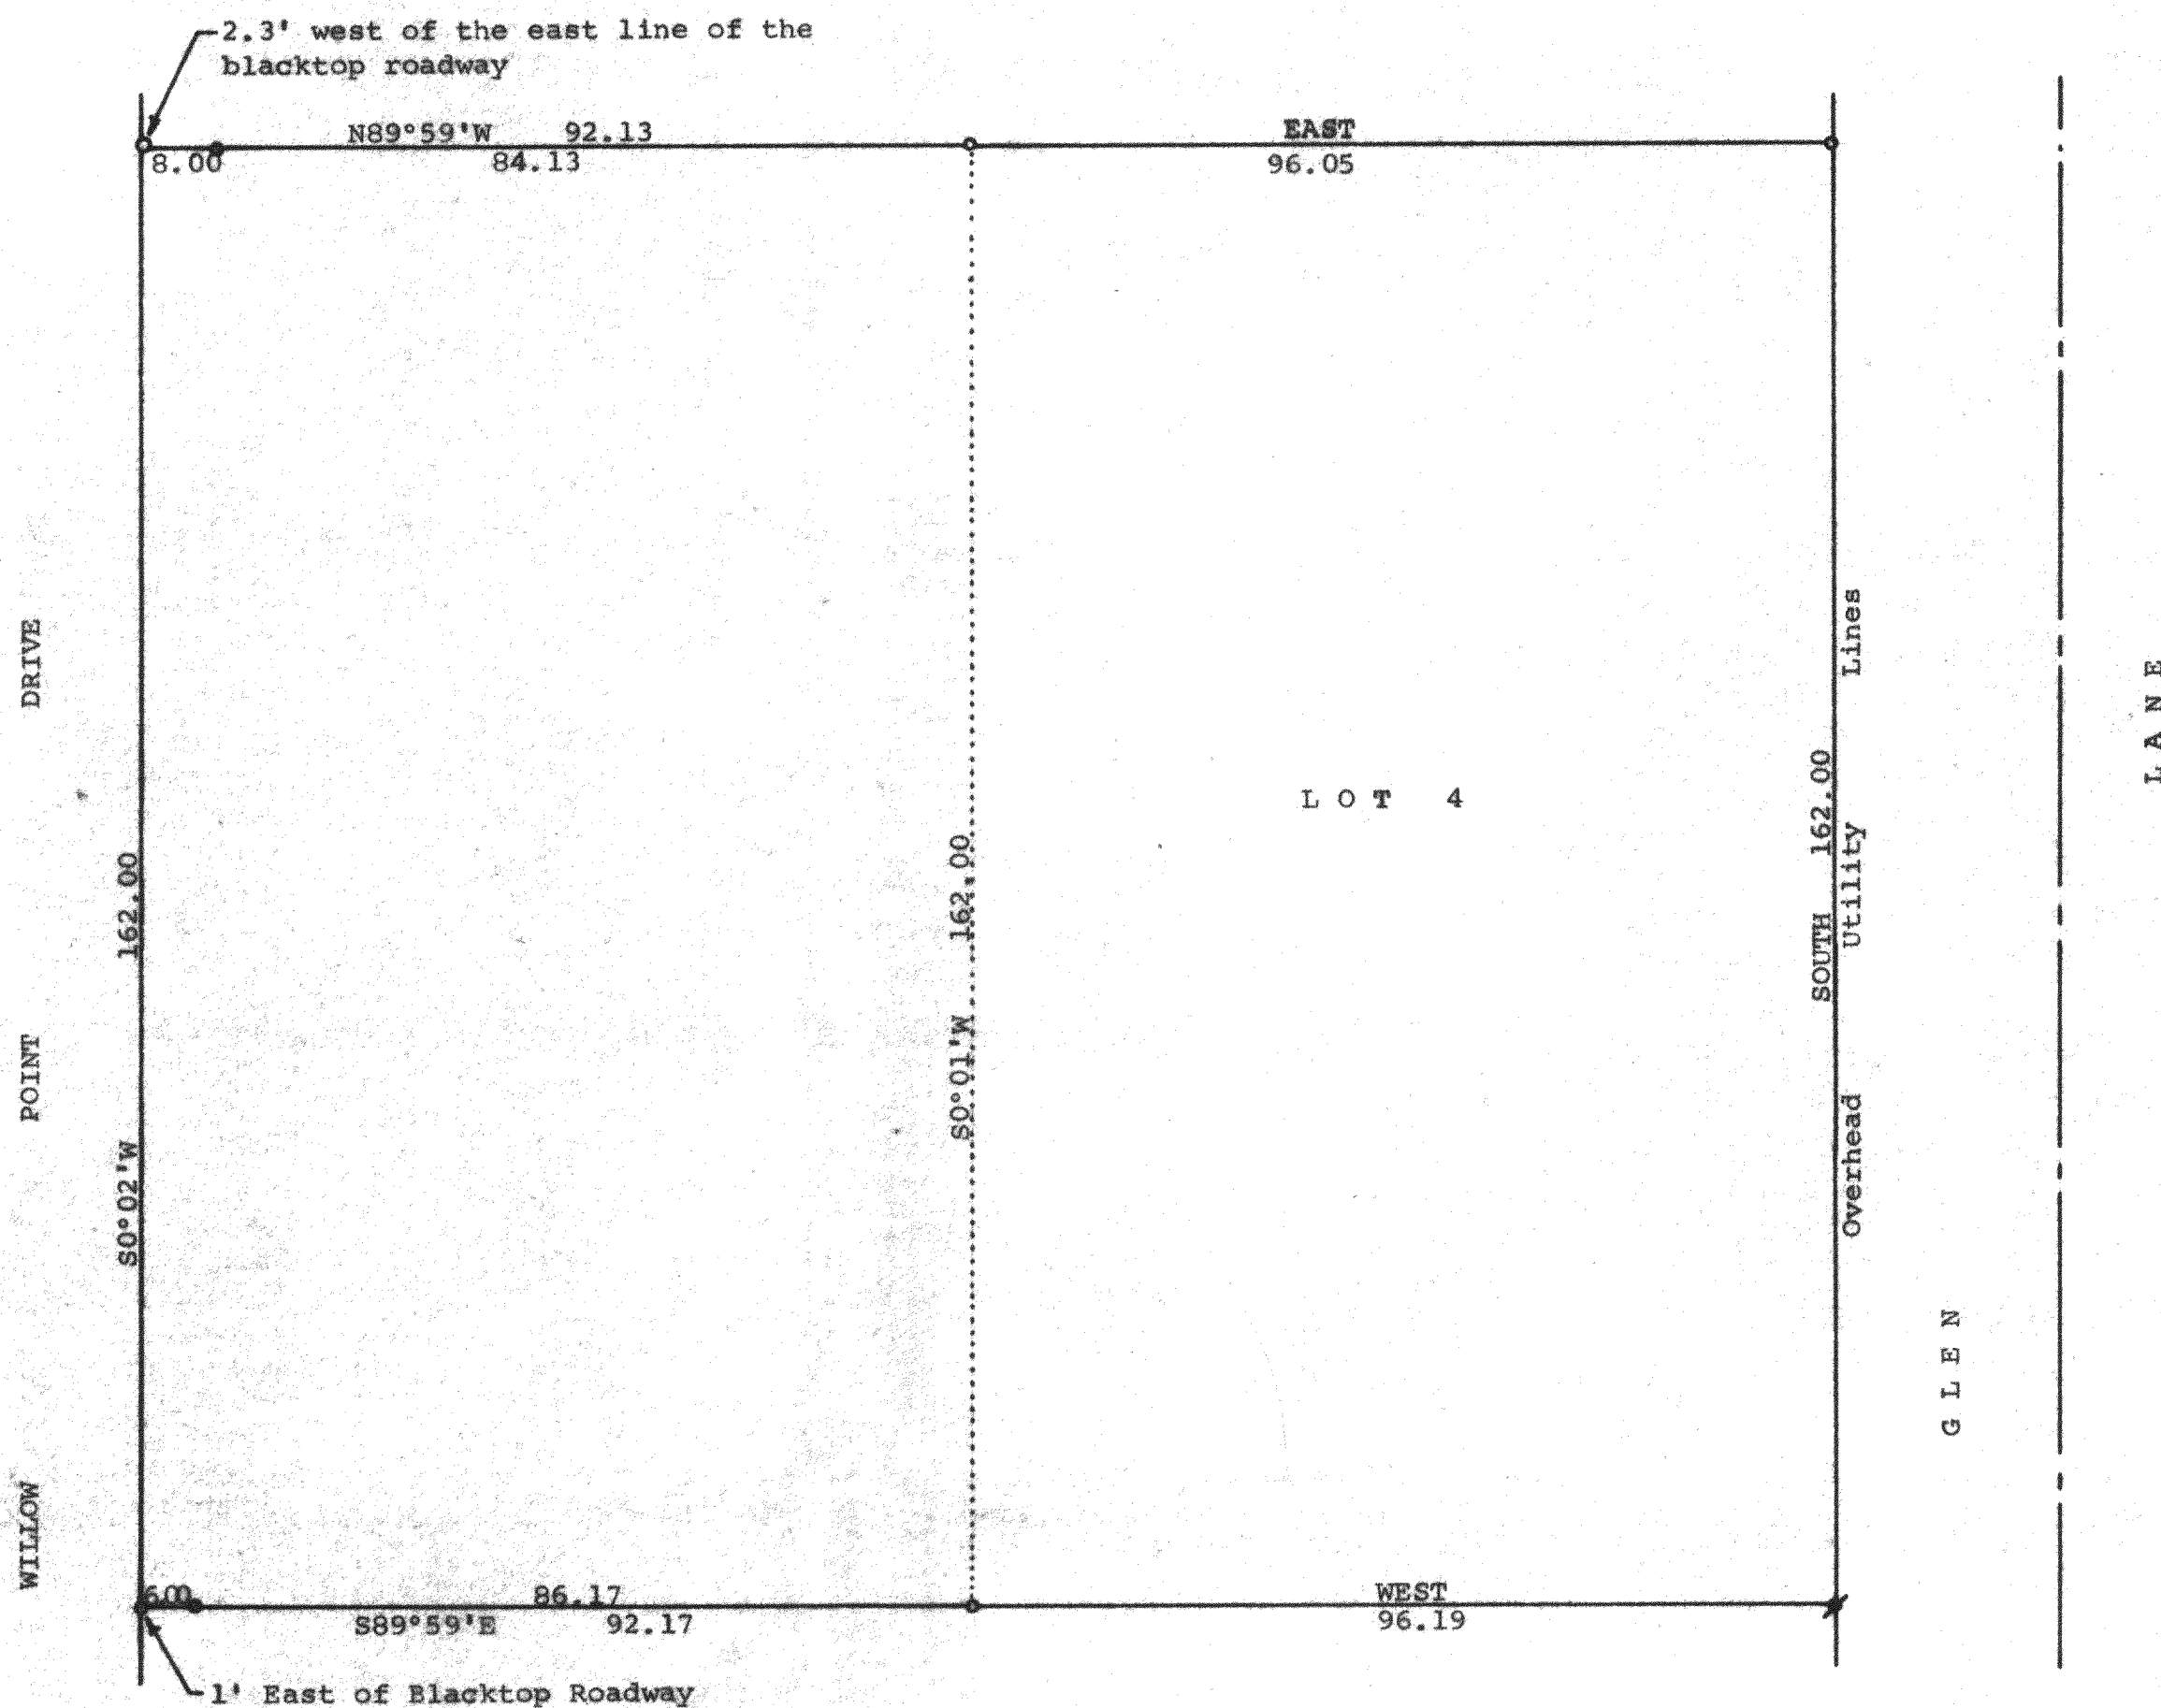

STATE OF WISCONSIN)  
COUNTY OF WALWORTH)

I, George T. Dunham, Surveyor, certify that I have surveyed the  
property described as follows:

A parcel of land located in the Southeast 1/4 of Section 29, T 2 N,  
R 16 E, Walworth County, Wisconsin, described as follows: Beginning  
at the southwest corner of Lot 4 of the Re-Subdivision of Lots 1 & 3 of  
Glen Eyrie; thence N0°01'E along the west line of said Lot 4, 162.00  
feet; thence N89°59'W 92.13 feet to the east line of Willow Point  
Drive; thence S0°02'W along said east line 162.00 feet; thence S89°59'E  
92.17 feet to the place of beginning.

ALSO Lot 4 of the Re-Subdivision of Lots 1 & 3 of Glen Eyrie, a subdivision  
located in the Town of Delavan, Walworth County, Wisconsin,  
and that the map shown above is a true representation thereof and shows the  
size and location of the property, its exterior boundaries, the location  
of all visible structures and dimensions of all principal buildings thereon,  
boundary fences, apparent easements, roadways and visible encroachments, if  
any, and that I have surveyed the property hereon described according to  
the official records, to the best of my knowledge and belief.

August 29, 1984

*George T. Dunham*  
George T. Dunham, Surveyor

