


DUNHAM SURVEYING, S.C.
SURVEYING & SUBDIVIDING
DELAVER, WISCONSIN 53115

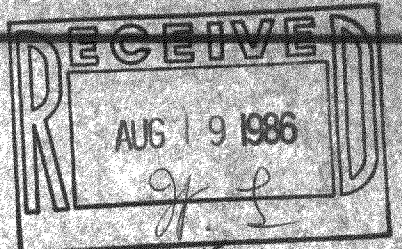

Detail Scale 1" = 30'
O = Iron Pipe Set

STATE OF WISCONSIN)
COUNTY OF WALWORTH)

I, James M. Dunham, Surveyor, certify that I have surveyed the property described as follows,


The East 1/2 of Lot 7 of the Subdivision of the Southeast Fractional 1/4 of Section 28 and the Northeast Fractional 1/4 of Section 33, T2N, R16E, Walworth County, Wisconsin, and that the above map is a true representation thereof and shows the size and location of the property, its exterior boundaries, the location of all visible structures and dimensions of all principal buildings thereon, boundary fences, apparent easements, roadways and visible encroachments, if any.

This survey is made for the use of the present owners of the property, and also those who purchase, mortgage, or guarantee the title thereto within one (1) year from date hereof.
February 18, 1982.

James M. Dunham
James M. Dunham, Surveyor

I, George T. Dunham, Surveyor, certify that I have relocated the iron pipes as shown hereon and that I have surveyed the property hereon described according to the official records, to the best of my knowledge and belief, and the plat shown hereon is a true representation thereof.
June 19, 1986

George T. Dunham
George T. Dunham, Surveyor

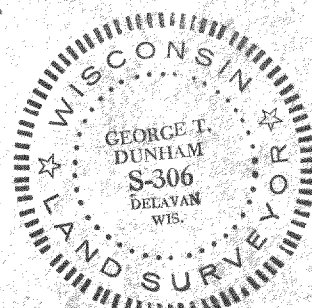

Scale - 1" = 100'
P = Iron Pipe Bound
O = Iron Pipe Set
(0.00) = Recorded Distance

NOTE: Bearings referenced to the centerline of highway as recorded on plat of subdivision.

Owner: Miller Upton
Delavan, WI 53115

P = 1" Iron Pipe Found 6/19/86
O = 1 1/2" Iron Pipe Found "
A = 3/4" Iron Pipe Found "

0.5' West of Remains of Fence Line.

0.8' West of Fence Line.

On Remains of Old Fence Line.

6.0' North of end of East-West Fence Line and on Remains of Old North-South Fence Line.

N. end of cyclone type fence

See detail for house location.
0.3' West of new fence line

1.0' West of Fence Line.

East 1/2 of Lot 7

5.12 Acres

0.9' East of Fence.

On Fence Line.

On fence line

Near Remains of Old North-South Fence Line.