


RECEIVED
AUG 19 1986
JH. L

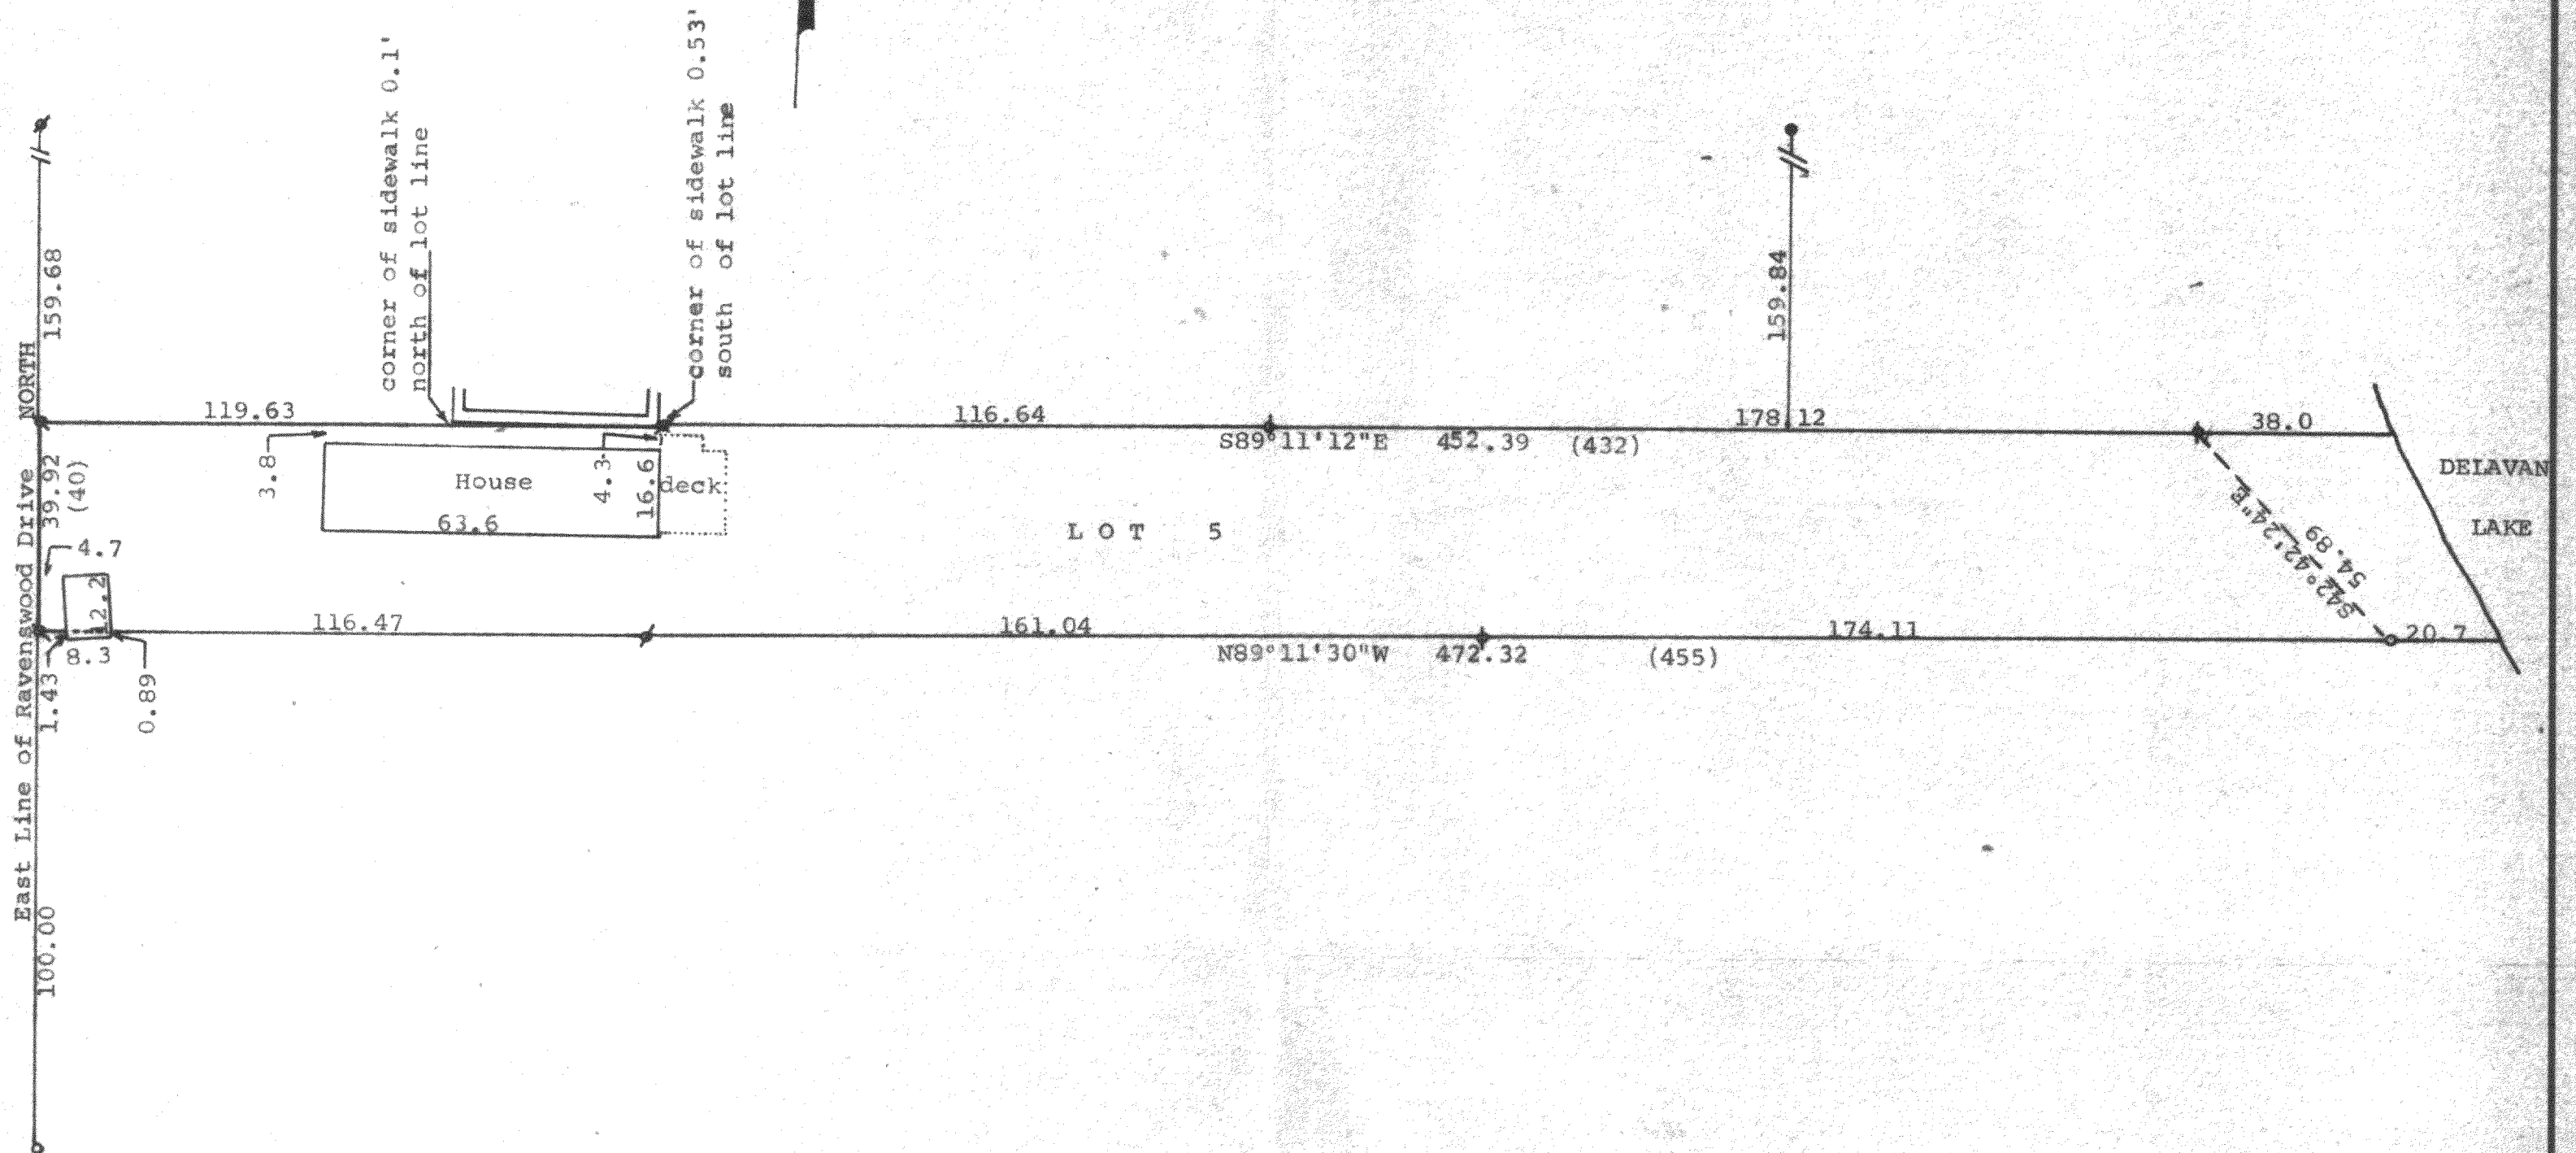

I, George T. Dunham, Surveyor, certify that I have surveyed the property described as follows:
 Lot 5 in Ravenswood, a subdivision located in Fractional Section 31, T 2 N, R 16 E, Walworth County, Wisconsin,
 and that the above plat is a true representation thereof and shows the size and location of the property, its exterior boundaries, the location of all visible structures and dimensions of all principal buildings thereon, boundary fences, apparent easements, roadways and visible encroachments, if any, and that I have surveyed the property hereon described according to the official records, to the best of my knowledge and belief.
 May 29, 1986

George T. Dunham
George T. Dunham, Surveyor

