
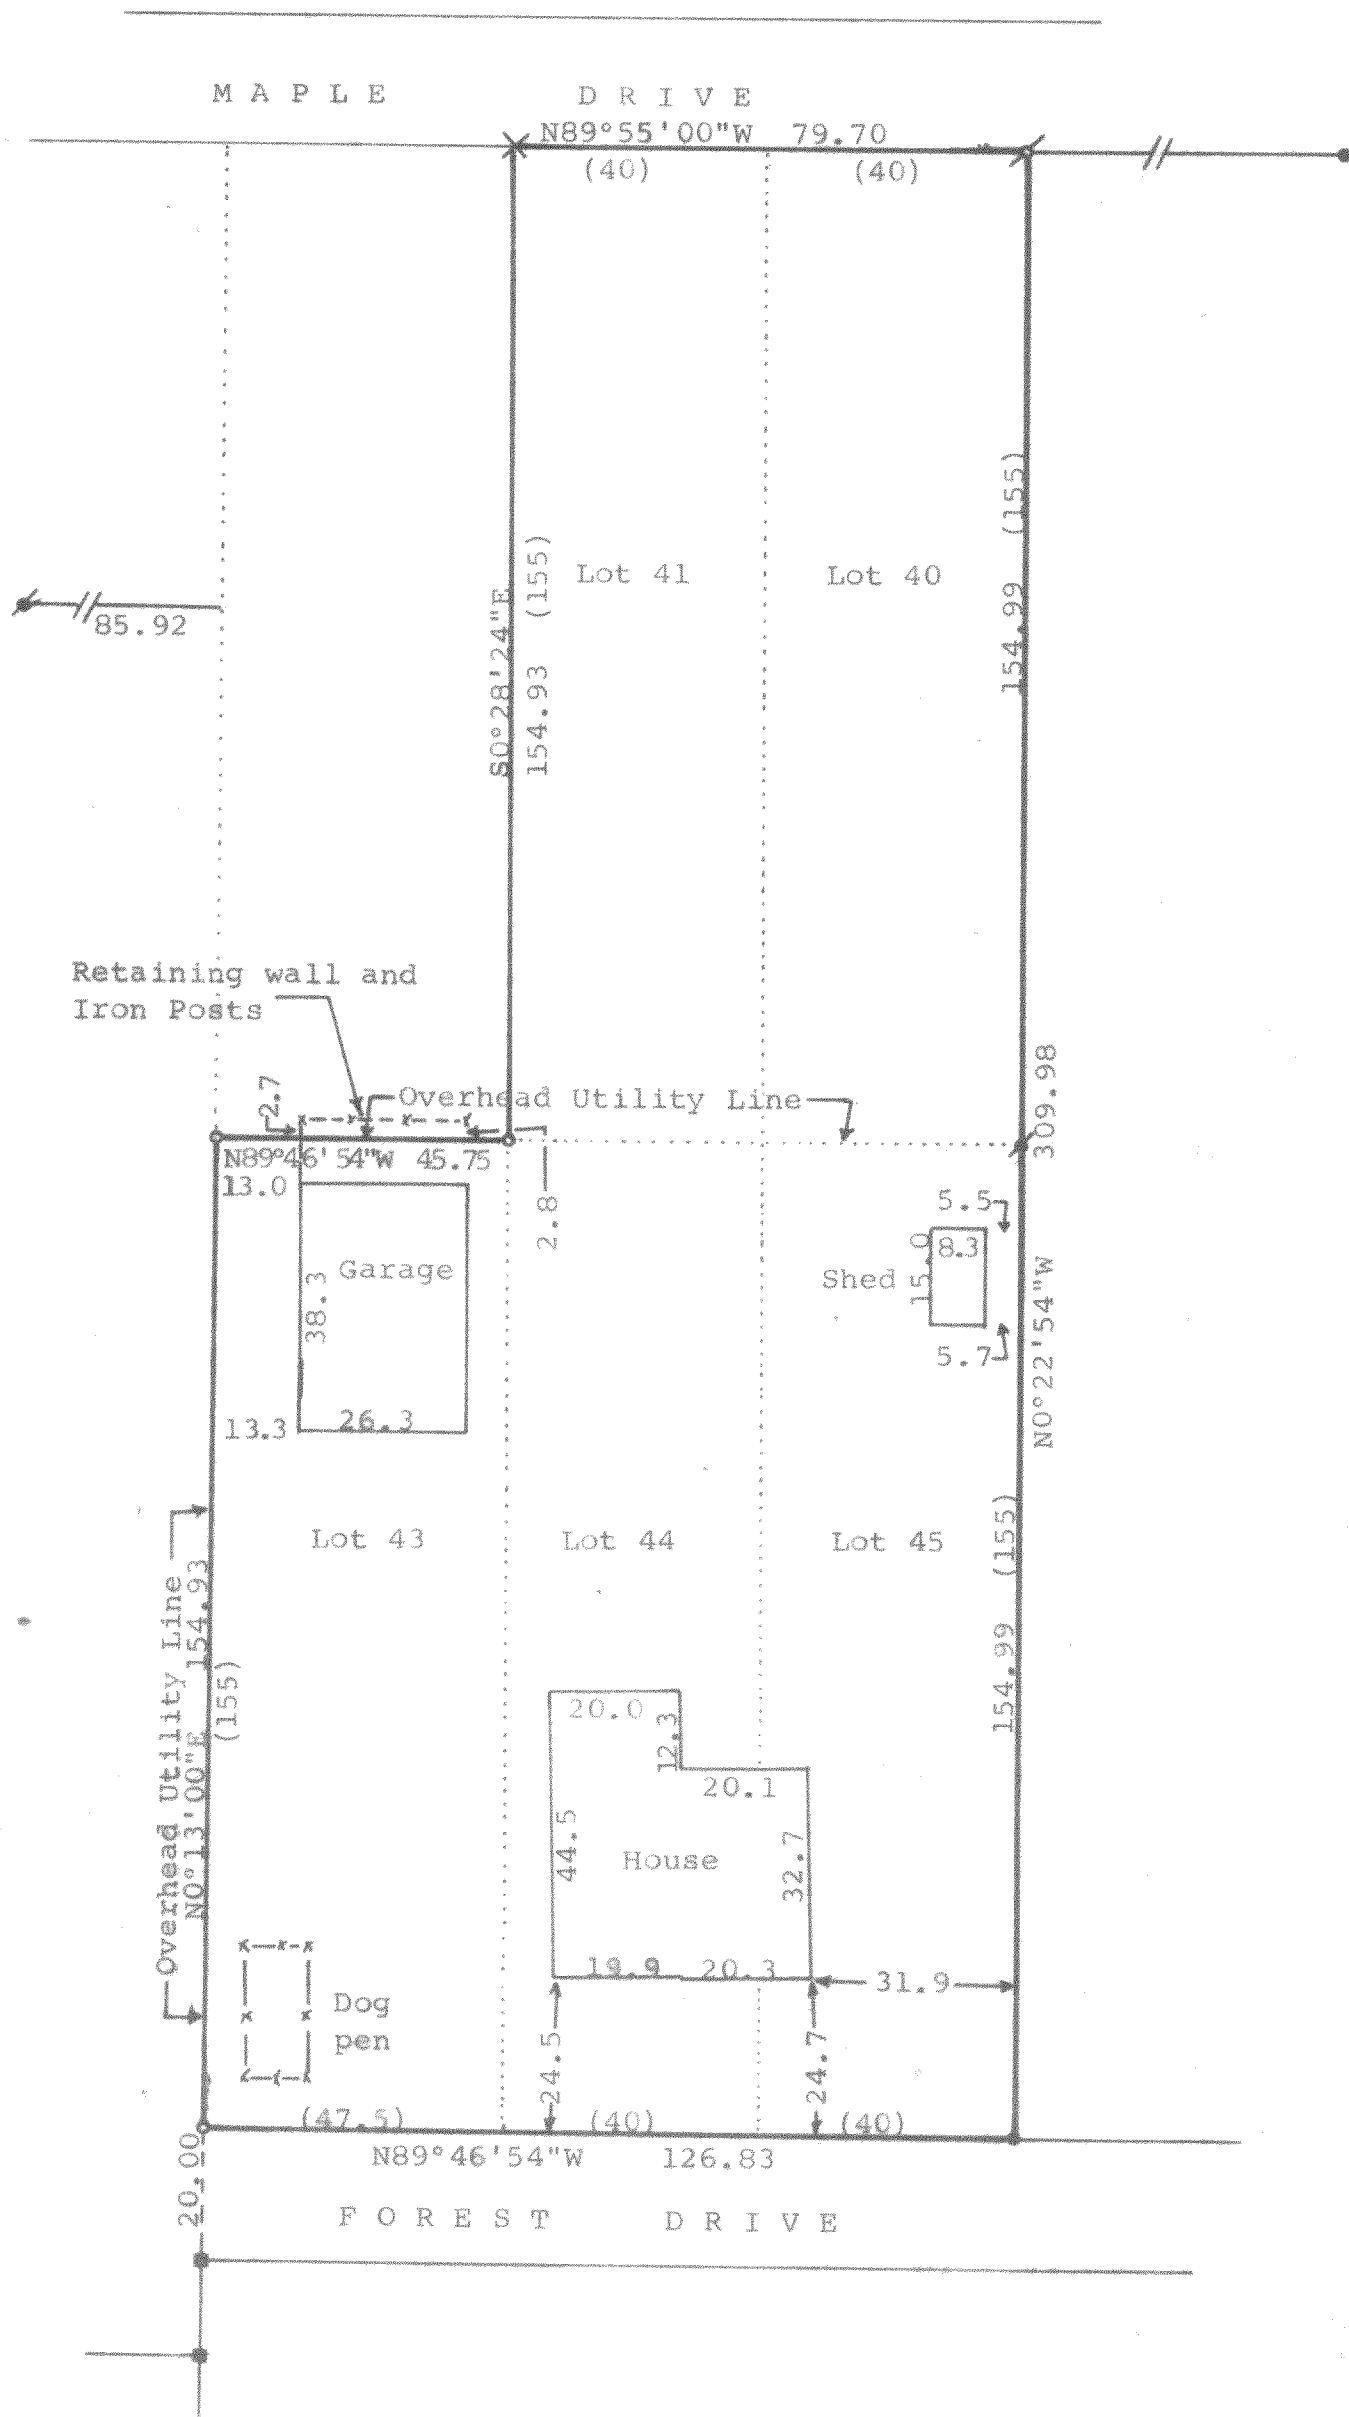


DUNHAM SURVEYING, S.C.
SURVEYING & SUBDIVIDING
DELAVER, WISCONSIN 53115

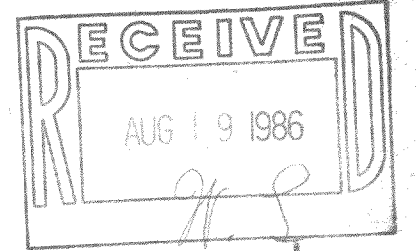

Scale - 1" = 30'

X = Cross, in Concrete

• = 1/2" Dia. Iron Rod Found

— = 1" Dia. Iron Pipe Found

○ = 3/4" Dia. Iron Pipe Set

— = Bent Iron Rod Found Reset with 3/4" Dia. Iron Pipe

■ = Concrete Monument Found

(00) = Recorded Distance

Survey ordered by:
Keefe Real Estate Inc.
Better Homes & Gardens
302 E. Walworth Ave.
Delavan, Wisconsin 53115

Bearings are referenced to the Westerly line of Lot 43.
Bearing of N0°13'E taken from those of record.

Note: Concrete driveway not located due to snow cover.

STATE OF WISCONSIN)
COUNTY OF WALWORTH) SS

I, James M. Dunham, Surveyor, certify that I have surveyed the property described as follows,
Lots 40, 41, 43, 44 and 45 of Krumhaar's Addition to Ravenswood a subdivision located in Section 31, T 2 N, R 16 E, Walworth County, Wisconsin,

and that the plat shown hereon is a true representation thereof and shows the size and location of the property, its exterior boundaries, the location of all visible structures and dimensions of all principal buildings thereon, boundary fences, apparent easements, roadways and visible encroachments, if any, and that I have surveyed the property hereon described according to the official records, to the best of my knowledge and belief.
January 22, 1985

James M. Dunham
James M. Dunham, Surveyor

