


DUNHAM SURVEYING, S.C.
SURVEYING & SUBDIVIDING
DELAVAN, WISCONSIN 53115

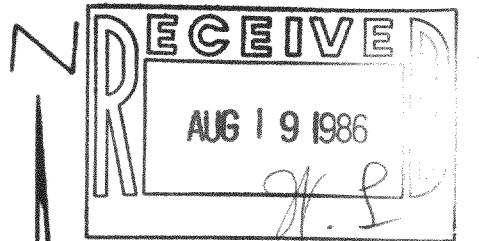


Scale - 1" = 10'

X = 60 Penny Spike on NW side of
60" Willow Tree - in root
P = 3/4" Iron Pipe Found
Q = 1" Iron Pipe Found

Bearings referenced to the northeasterly line
Lot 28 with the assumed bearing of N49°54'W

Owner: Martin Miller
2328 Lake Shore Drive
Delavan, WI 53115

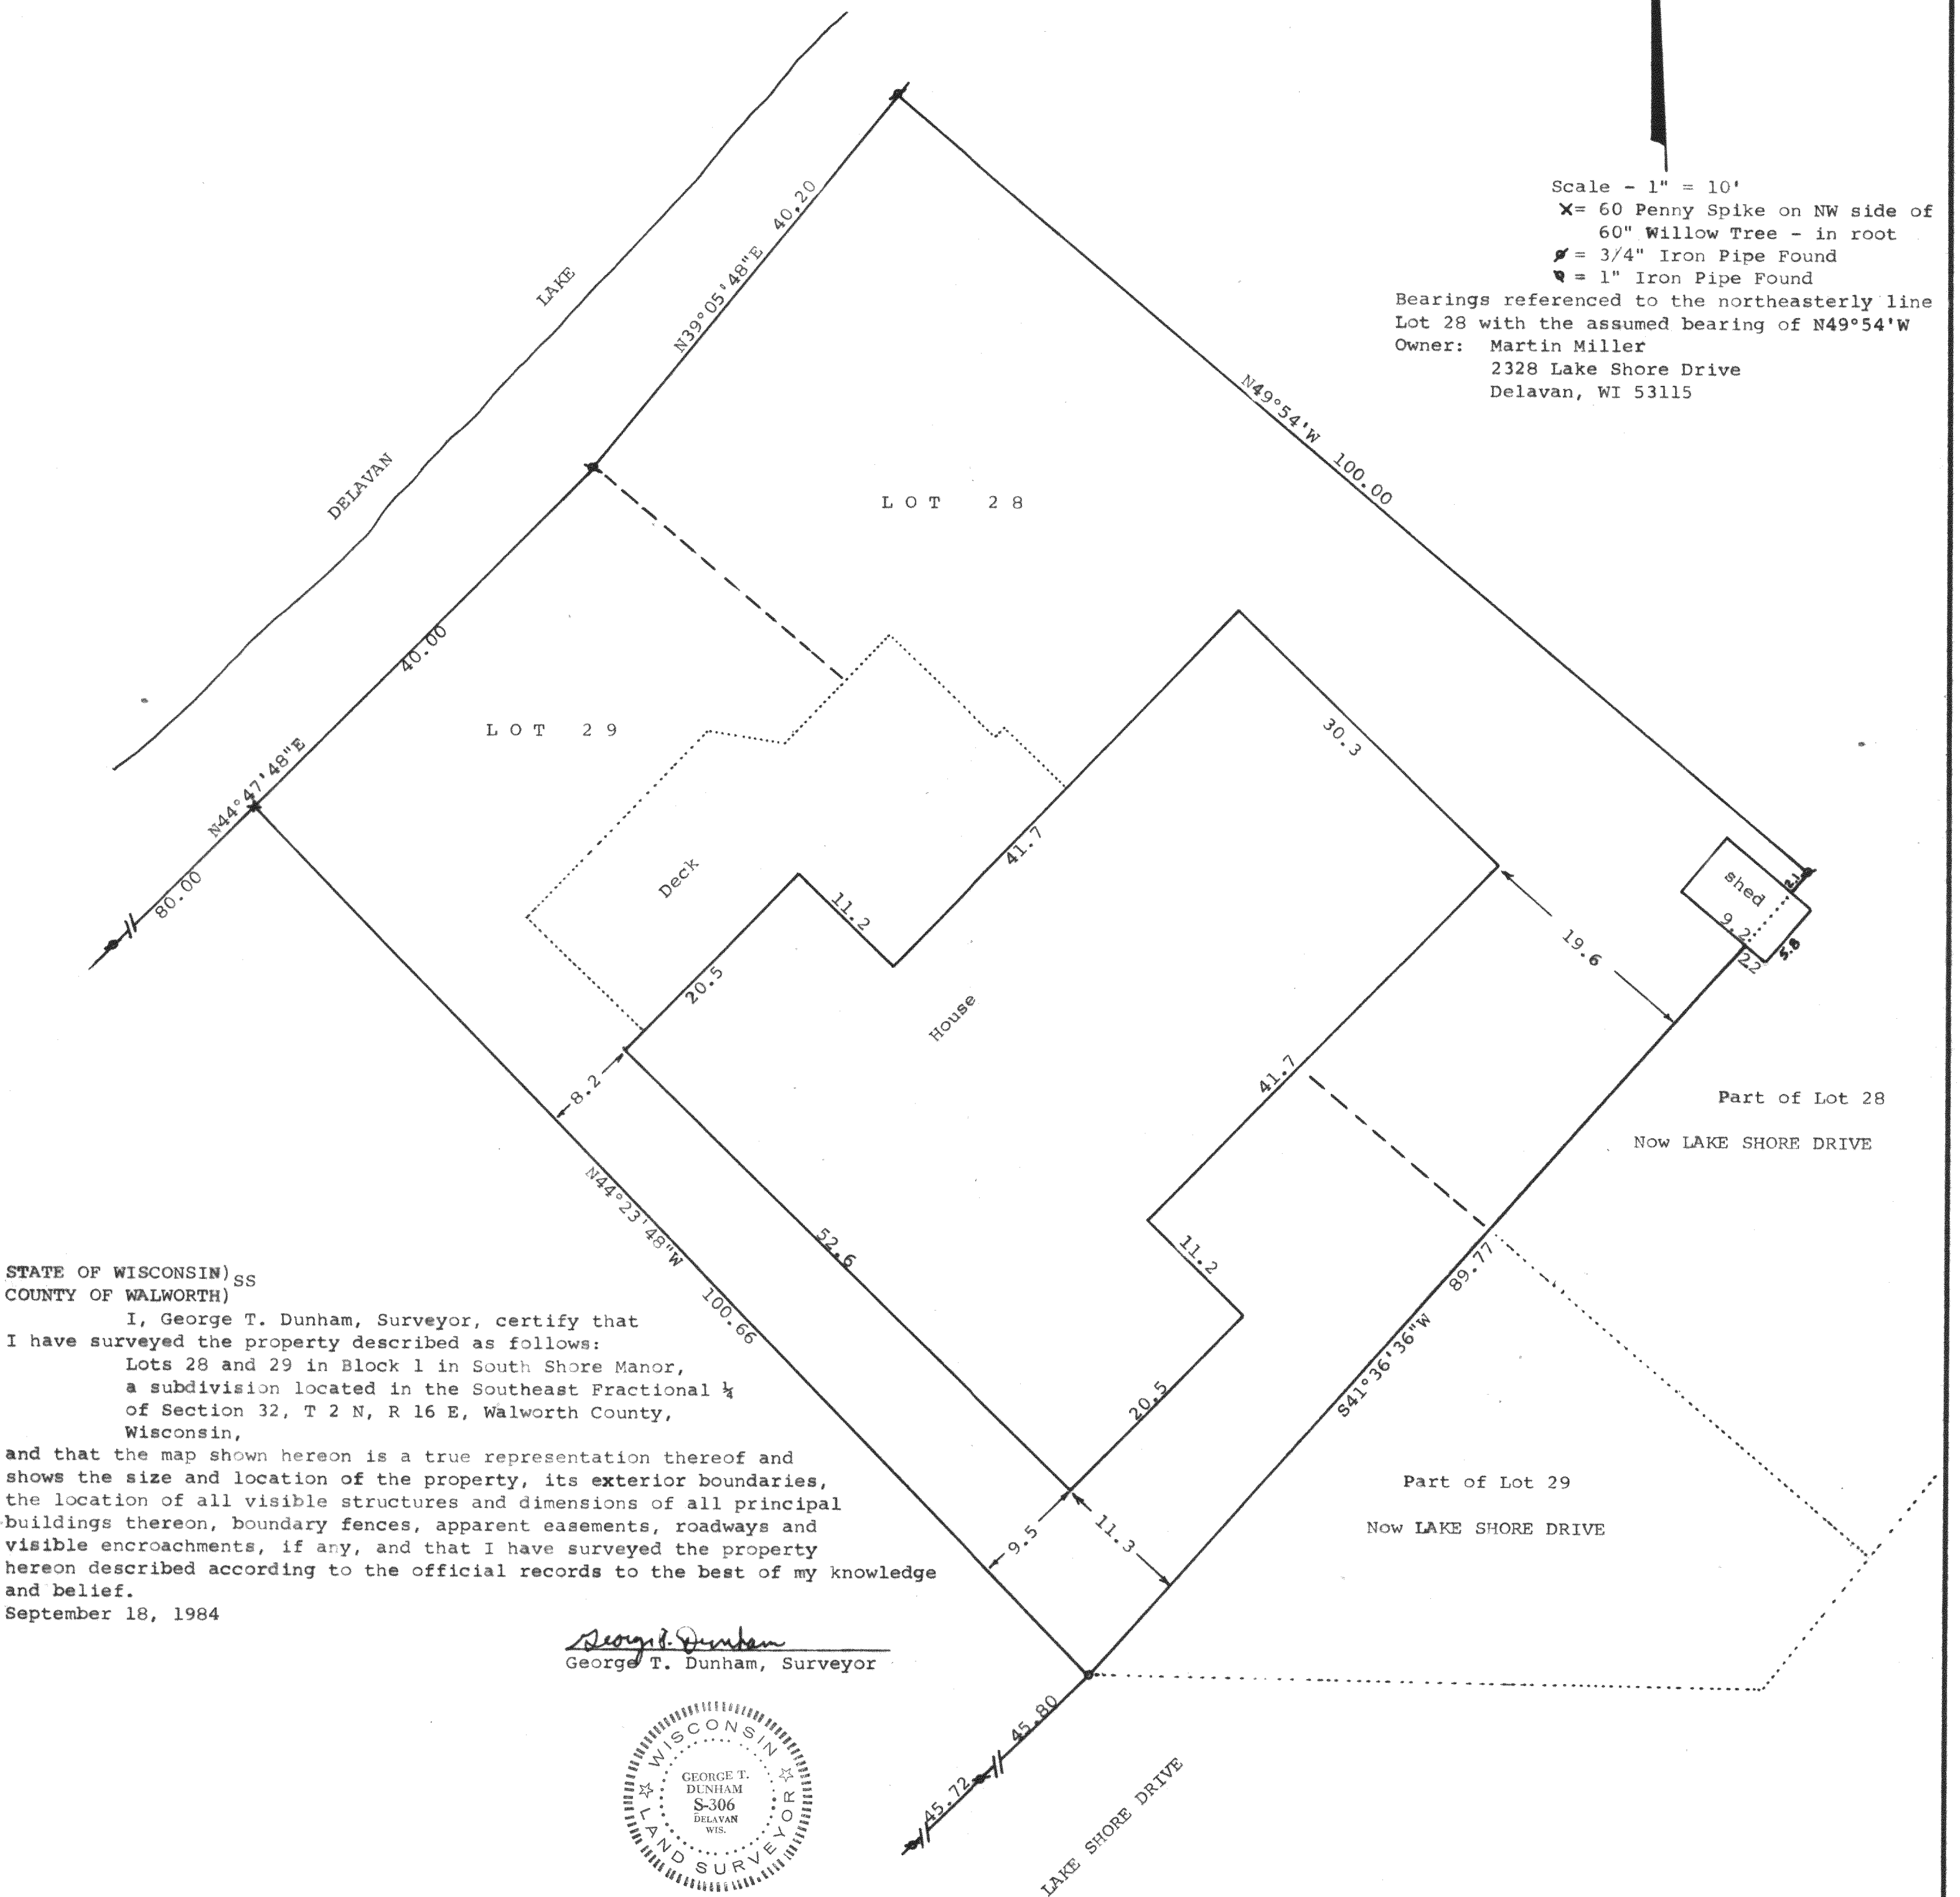

STATE OF WISCONSIN)SS
COUNTY OF WALWORTH)

I, George T. Dunham, Surveyor, certify that
I have surveyed the property described as follows:

Lots 28 and 29 in Block 1 in South Shore Manor,
a subdivision located in the Southeast Fractional 1/4
of Section 32, T 2 N, R 16 E, Walworth County,
Wisconsin,

and that the map shown hereon is a true representation thereof and
shows the size and location of the property, its exterior boundaries,
the location of all visible structures and dimensions of all principal
buildings thereon, boundary fences, apparent easements, roadways and
visible encroachments, if any, and that I have surveyed the property
hereon described according to the official records to the best of my knowledge
and belief.

September 18, 1984

George T. Dunham
George T. Dunham, Surveyor

