
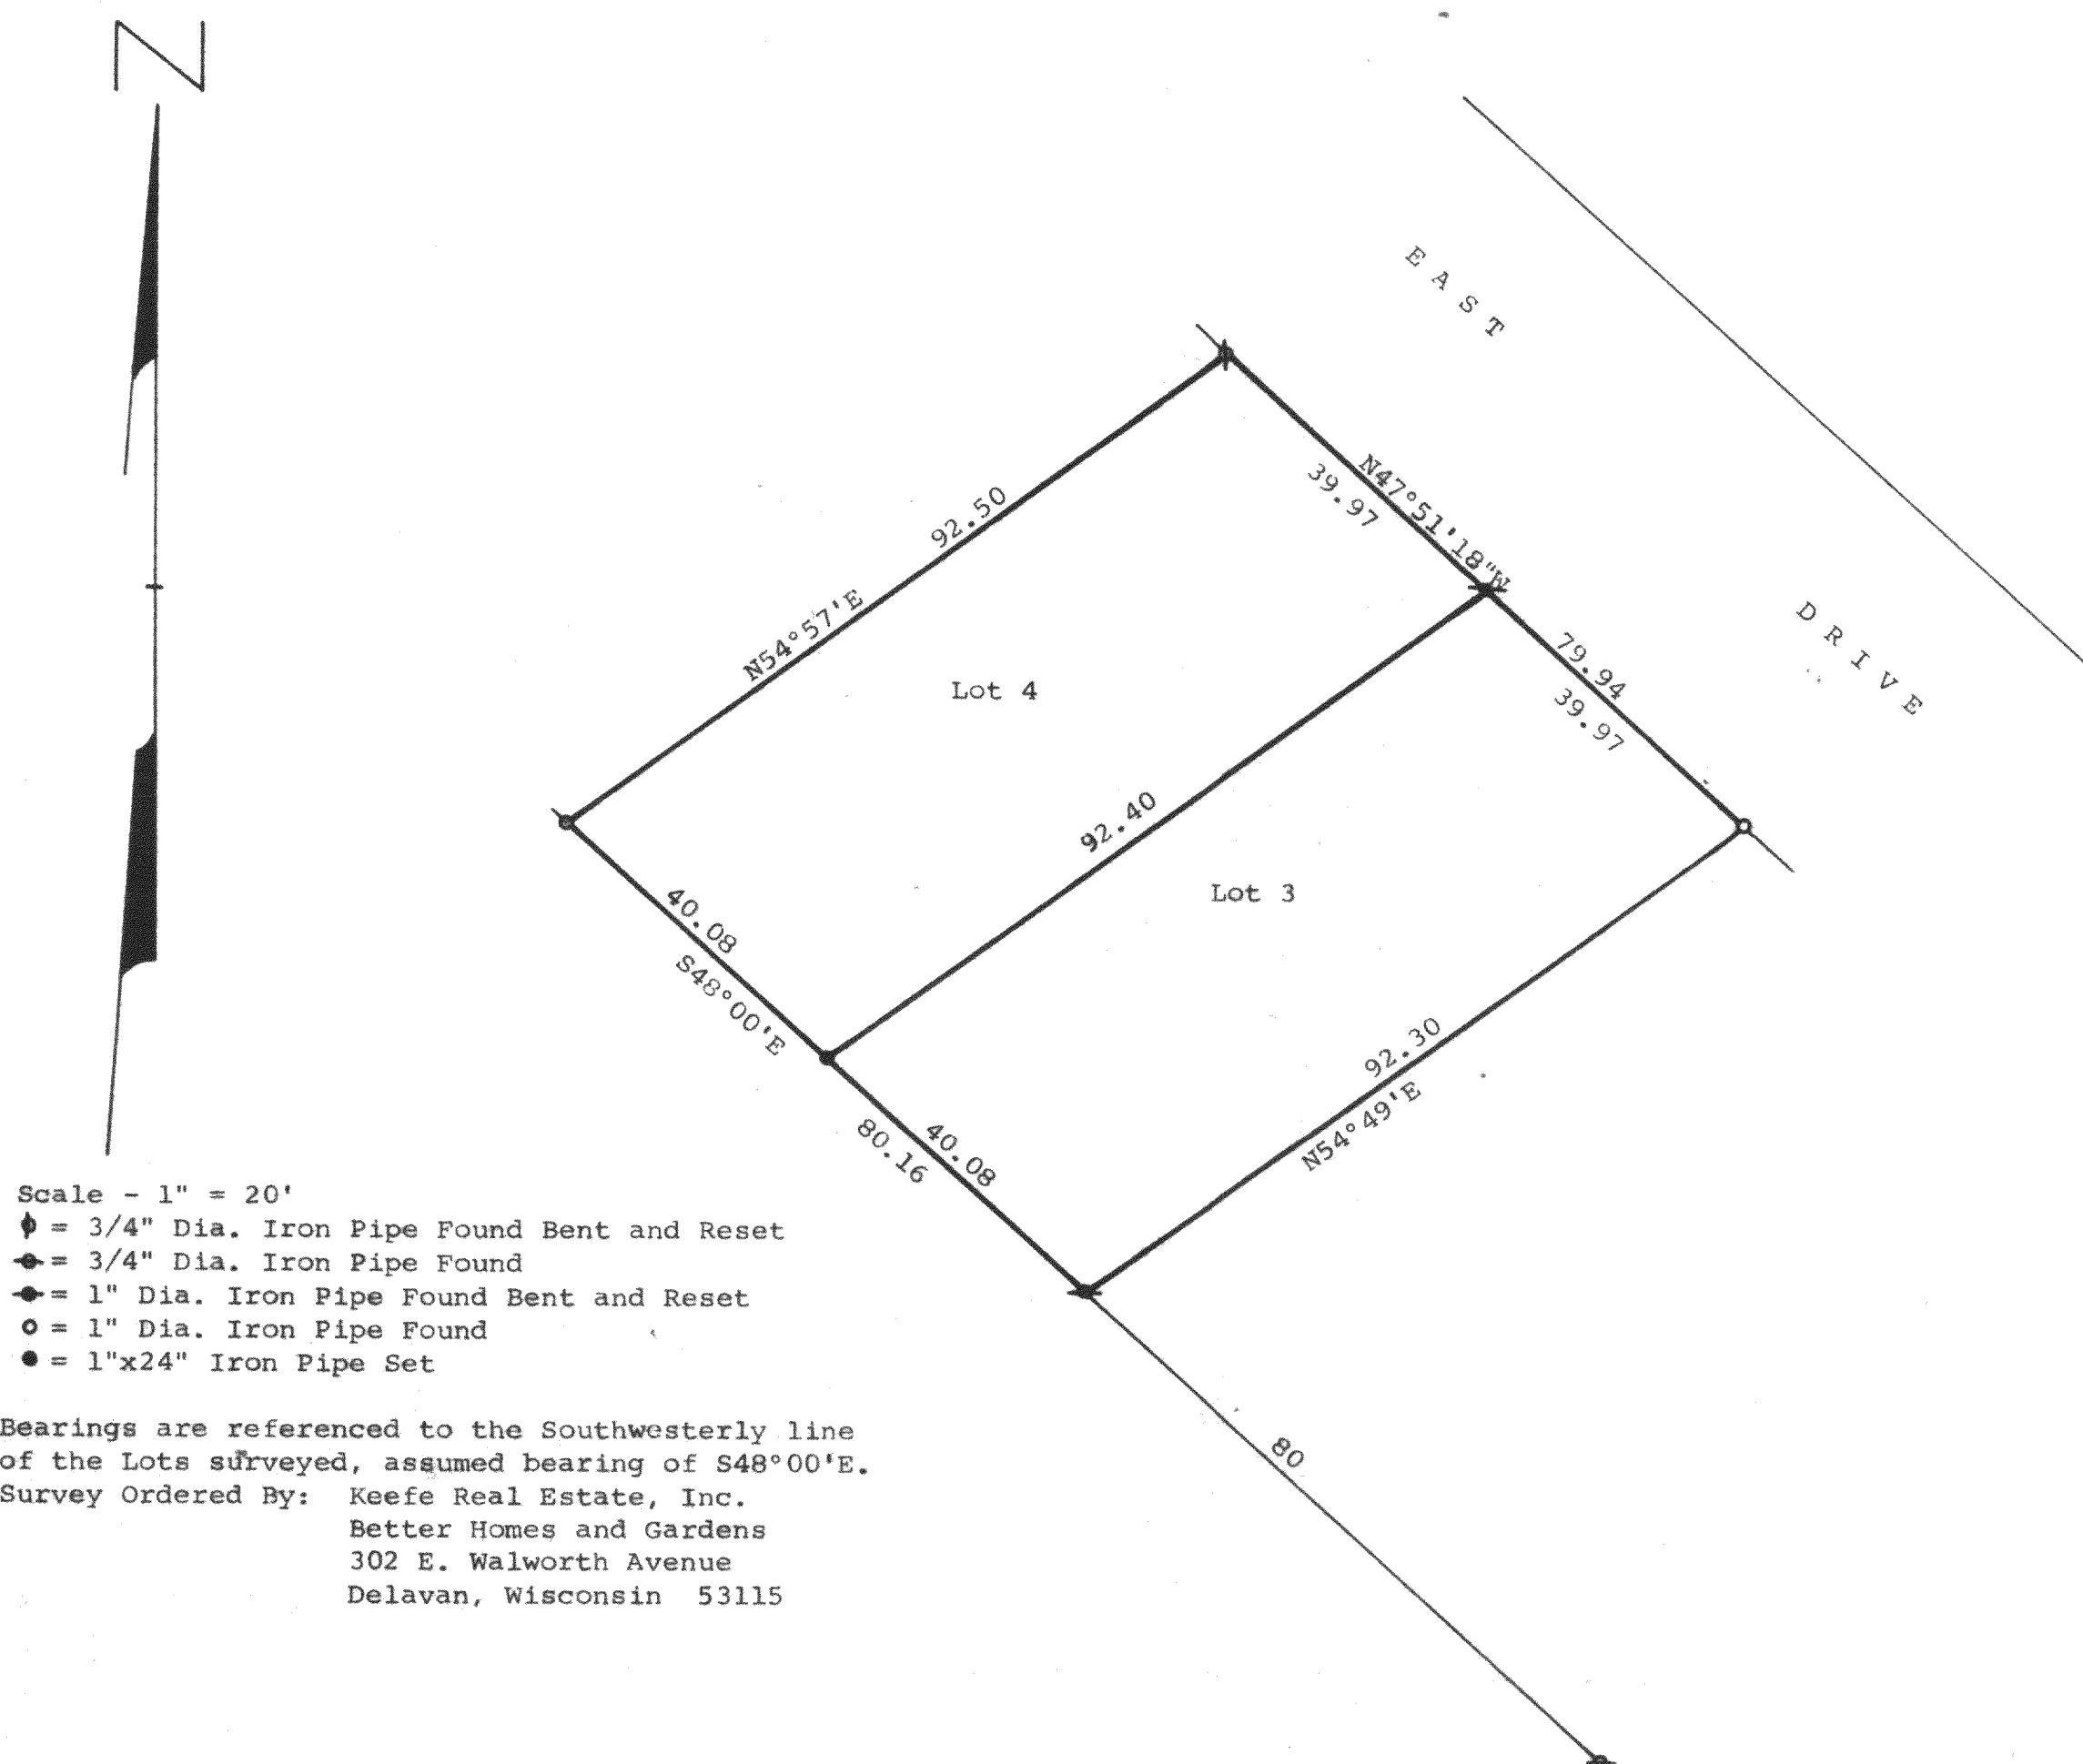


DUNHAM SURVEYING, S.C.
SURVEYING & SUBDIVIDING
DELAVAN, WISCONSIN 53115

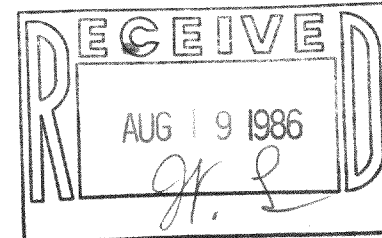

Scale - 1" = 20'
 ◆ = 3/4" Dia. Iron Pipe Found Bent and Reset
 ● = 3/4" Dia. Iron Pipe Found
 ◆ = 1" Dia. Iron Pipe Found Bent and Reset
 ● = 1" Dia. Iron Pipe Found
 ● = 1"x24" Iron Pipe Set

Bearings are referenced to the Southwesterly line of the Lots surveyed, assumed bearing of S48°00'E.
 Survey Ordered By: Keefe Real Estate, Inc.
 Better Homes and Gardens
 302 E. Walworth Avenue
 Delavan, Wisconsin 53115

STATE OF WISCONSIN)
 COUNTY OF WALWORTH) ss

I, George T. Dunham, Surveyor, certify that I have surveyed the property described as follows,

Lots 3 and 4, Block 7 in South Shore Manor, a subdivision located in the Southeast Fractional 1/4 of Section 32, T 2 N, R 16 E, Walworth County, Wisconsin,

and that the map shown above is a true representation thereof and shows the size and location of the property, its exterior boundaries, the location of all visible structures and dimensions of all principal buildings thereon, boundary fences, apparent easements, roadways and visible encroachments, if any, and that I have surveyed the property hereon described according to the official records to the best of my knowledge and belief.
 July 14, 1986.

George T. Dunham
 George T. Dunham, Surveyor

