



ABELL
SURVEYING & MAPPING
DELAVER, WISCONSIN 53115
414-728-6737

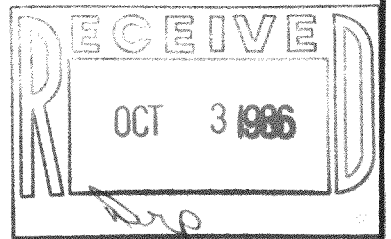

PLAT OF SURVEY OF

THE SOUTHWESTERLY 40 FEET OF LOT 5
AND THE NORTHEASTERLY 35 FEET OF LOT 6,
BAILEY SUBDIVISION, T2N,R16E, WALWORTH
COUNTY, WISCONSIN.

ORDERED BY: THE RAULAND AGENCY
607 E. WALWORTH AVE.
DELAVER, WI 53115

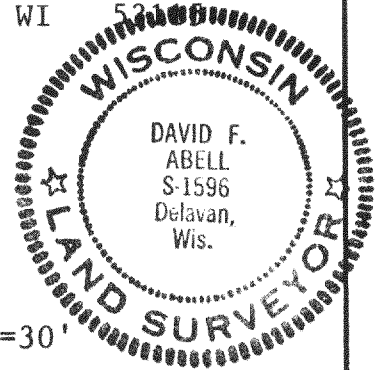

SCALE - 1"=30'

LEGEND

- ♂ - IRON PIPE FOUND
- - CONCRETE MONUMENT FOUND
- () - RECORDED AS

NOTE: THERE IS A CHAIN LINK FENCE
WHICH RUNS JUST SOUTH OF THE SOUTH LINE
OF THIS PROPERTY. THE FENCE BELONGS
TO THE PEOPLE TO THE SOUTH.

I HEREBY CERTIFY THAT I HAVE SURVEYED THE
ABOVE DESCRIBED PROPERTY AND THAT THE
ABOVE MAP IS A TRUE REPRESENTATION THERE-
OF AND SHOWS THE SIZE AND LOCATION OF THE
PROPERTY, ITS EXTERIOR BOUNDARIES, THE
LOCATION OF ALL PRINCIPAL BUILDINGS THERE-
ON, BOUNDARY FENCES, APPARENT EASEMENTS,
ROADWAYS, AND VISIBLE ENCROACHMENTS, IF
ANY, TO THE BEST OF MY KNOWLEDGE AND BE-
LIEF.

THIS SURVEY IS MADE FOR THE USE OF THE
PRESENT OWNERS OF THE PROPERTY, AND ALSO
THOSE WHO PURCHASE, MORTGAGE, OR GUARANTEE
THE TITLE THERETO WITHIN ONE (1) YEAR
FROM DATE HEREOF.

David F. Abell

DAVID F. ABELL
WISCONSIN REGISTERED LAND SURVEYOR, S-1596

DATE Sept. 2, 1986 JOB NUMBER - 86042

