


of  
Lot 28 of Oak Meadow Subdivision, Located in the  
Northeast  $\frac{1}{4}$  of Section 29, T2N, R16E, Town of  
Delavan, Walworth County, Wisconsin.

Jensen Surveying & Mapping S.C.  
45 S. Wisconsin St. P.O. Box 322  
Elkhorn, Wisconsin. 53121  
(414) 723-3434



AUGUST 1, 86

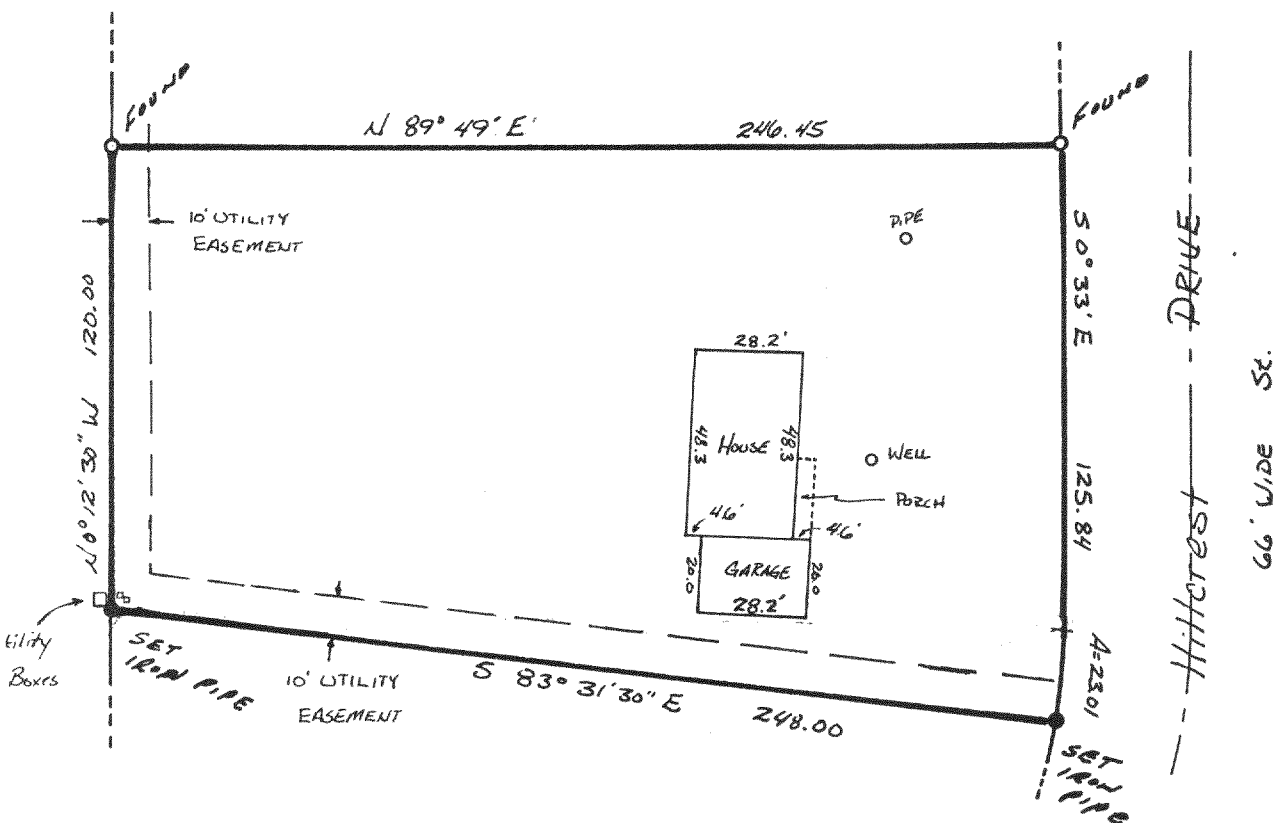

I= 5030'20"  
R= 239.44  
A= 23.01  
C= 23.00  
CHB= S 2°12'10" W

Note: This survey plat is not  
certified unless signed  
and sealed in red ink.

I, Thomas P.A. Jensen, Wisconsin Registered Land Surveyor, do hereby certify that this survey was performed by me, or under my direction, in full compliance with the owner's/agent's instructions and chapter A-E 5 of the Wisconsin Administrative Code "Minimum Standards For Property Surveys"; and that this map is an accurate representation thereof to the best of my knowledge and belief.

216-880