


RECEIVED  
MAR 5 1967



George T. Dunham  
George T. Dunham, Surveyor

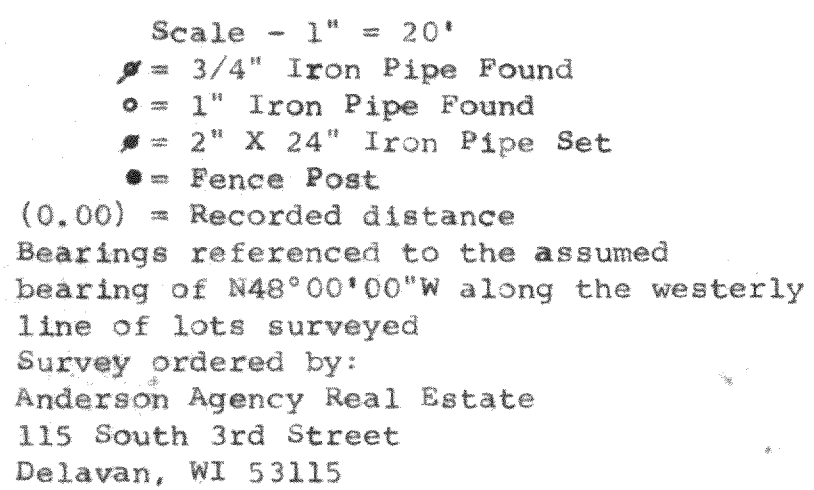