
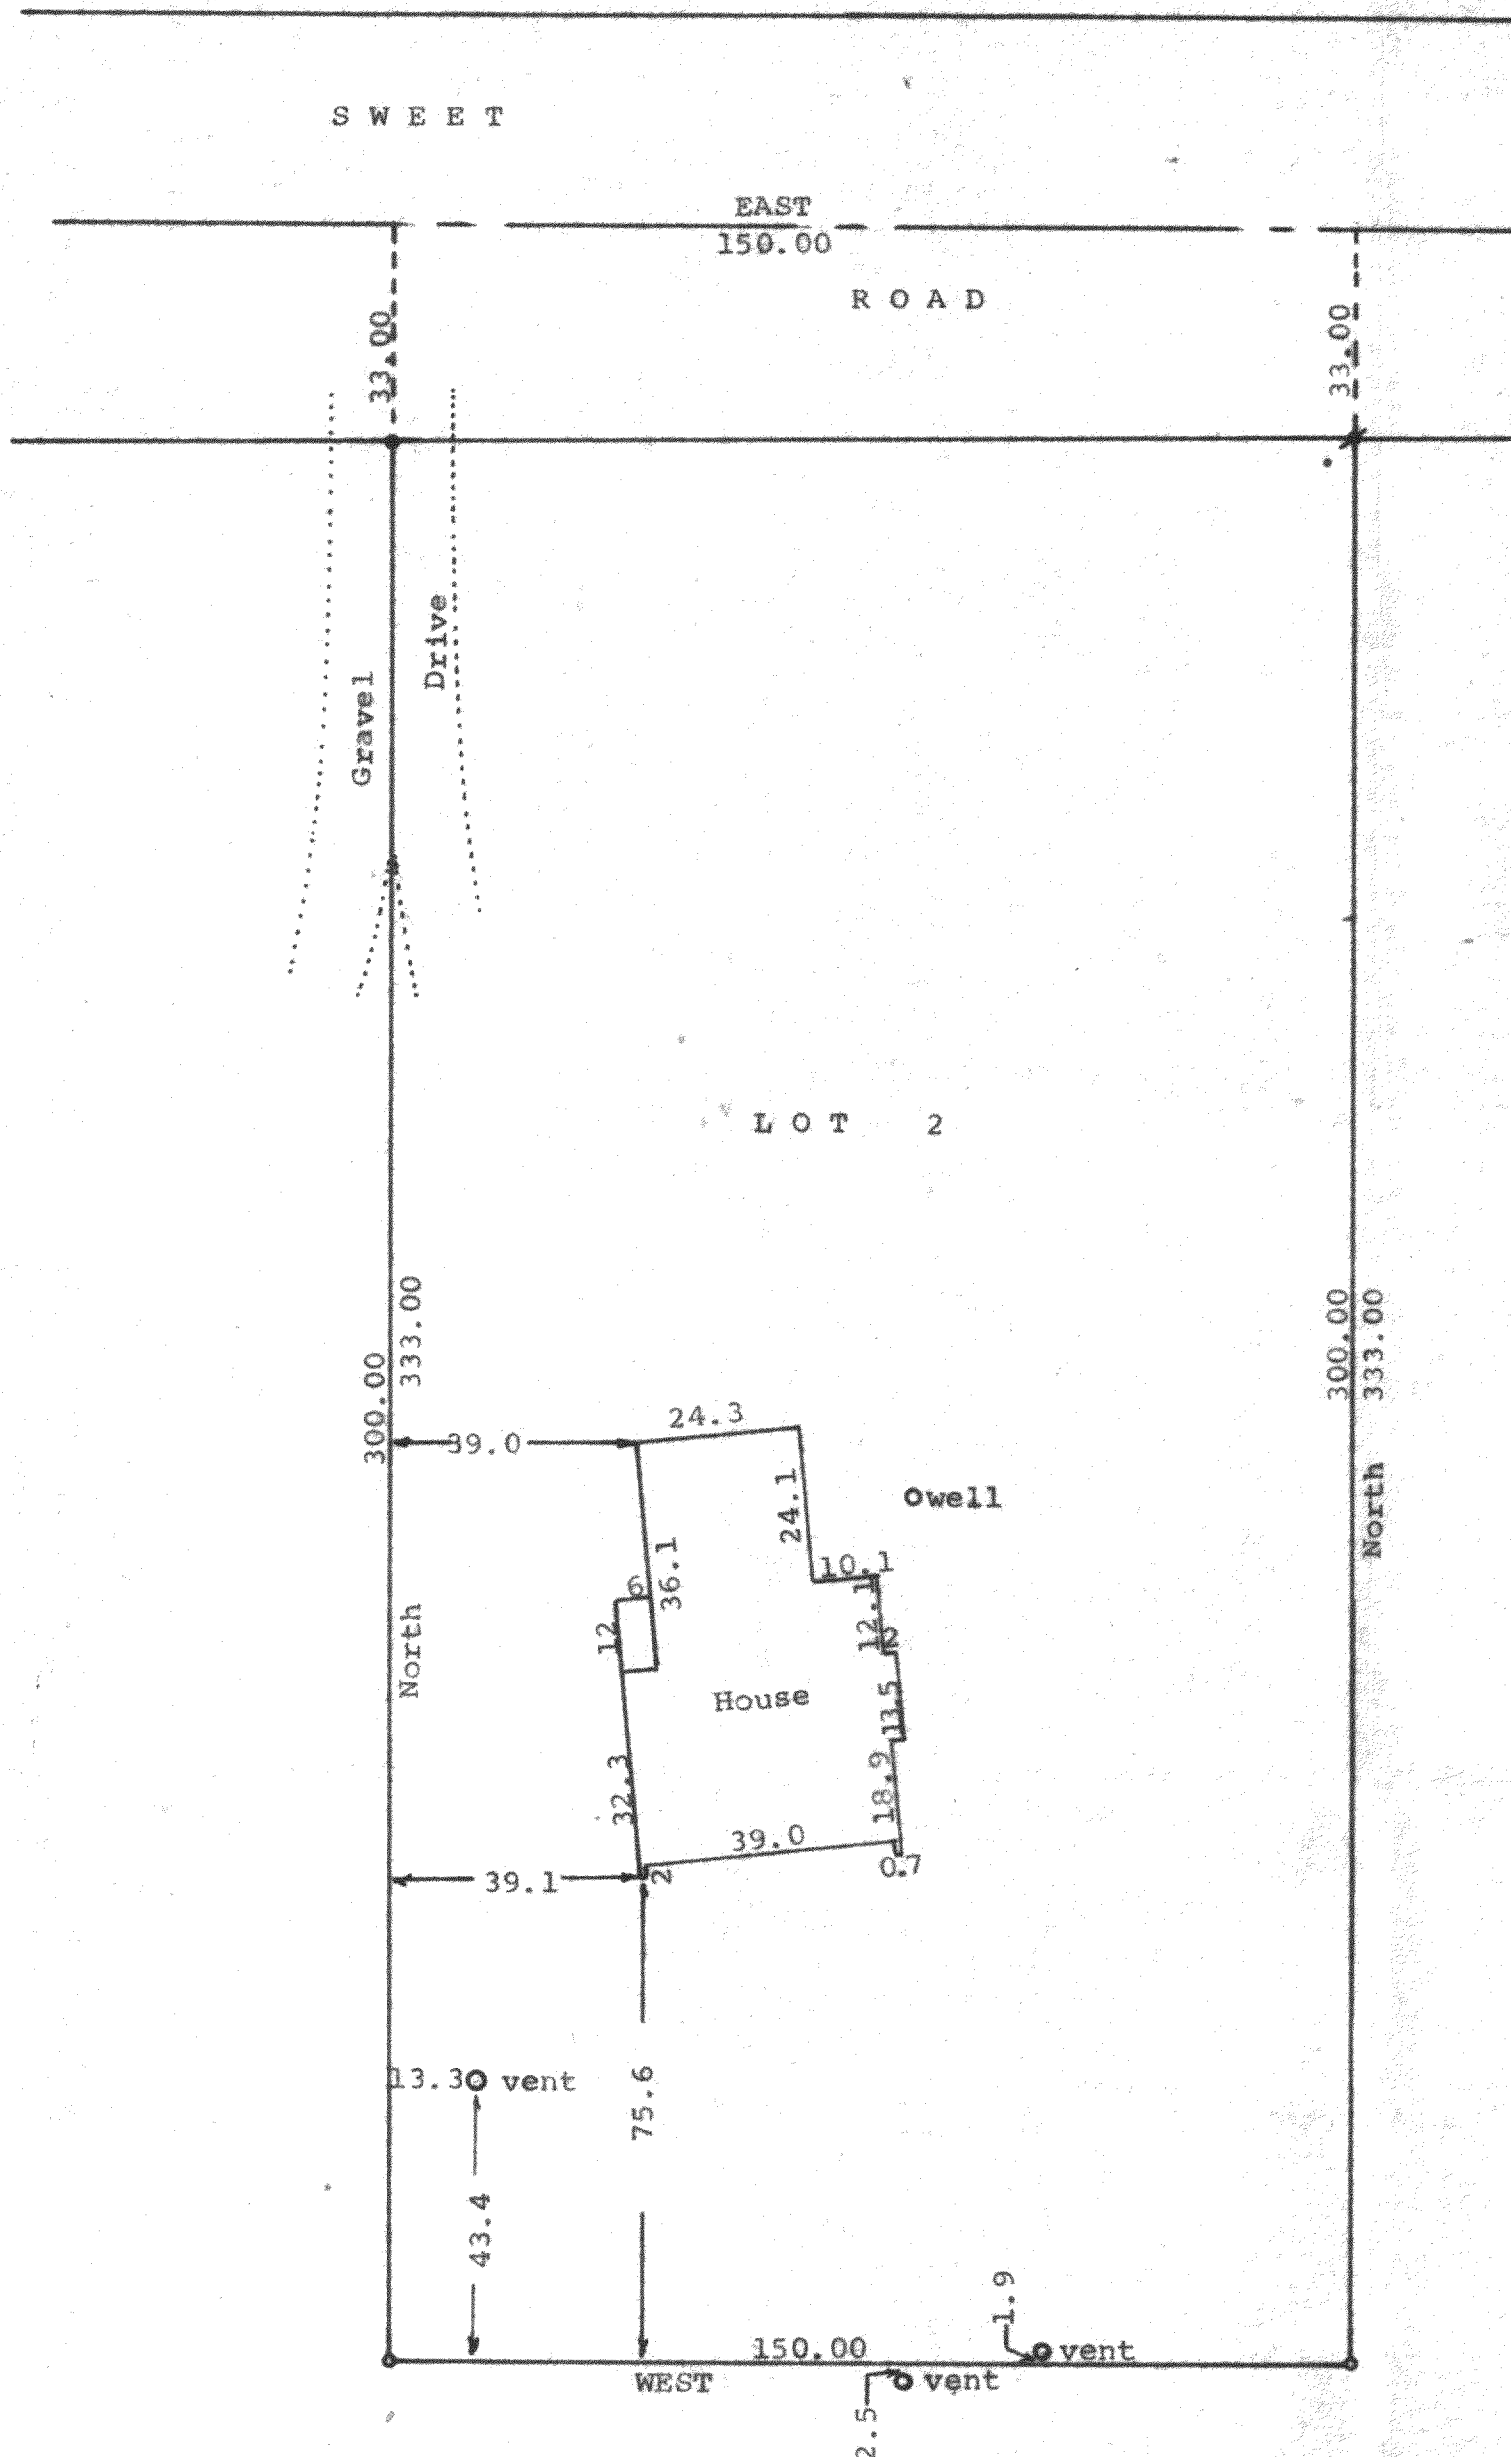


DUNHAM SURVEYING, S.C.
SURVEYING & SUBDIVIDING
DELAVAN, WISCONSIN 53115

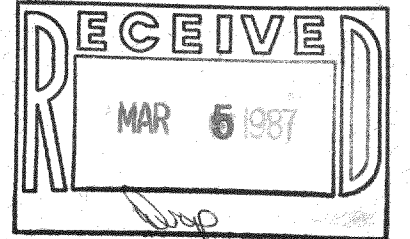

Scale - 1" = 30'
 • = 3/4" Iron Pipe Found
 / = 1" Iron Pipe Found
 • = 1" Iron Pipe Found under 1.2' of gravel
 Bearings used are those of record
 Owners: Dale W. & Karen M. Kjensrud
 Sweet Road
 Delavan, WI 53115

STATE OF WISCONSIN) SS
 COUNTY OF WALWORTH)

I, George T. Dunham, Surveyor, certify that I have surveyed the property described as follows:

Lot No. 2 of Certified Survey No. 914 recorded March 23, 1979 in the Office of the Register of Deeds for Walworth County, Wisconsin in Volume 4 of Certified Surveys at Page 146 as Document No. 44943. Said land being located in the Northwest 1/4 of Section 31, T 2 N, R 16 E, Walworth County, Wisconsin,

and that the map shown hereon is a correct representation thereof and shows the size and location of the property, its exterior boundaries, the location of all visible structures and dimensions of all principal buildings thereon, boundary fences, apparent easements, roadways and visible encroachments, if any, and that I have surveyed the property hereon described, according to the official records, to the best of my knowledge and belief.
 December 16, 1986

George T. Dunham
 George T. Dunham, Surveyor

