
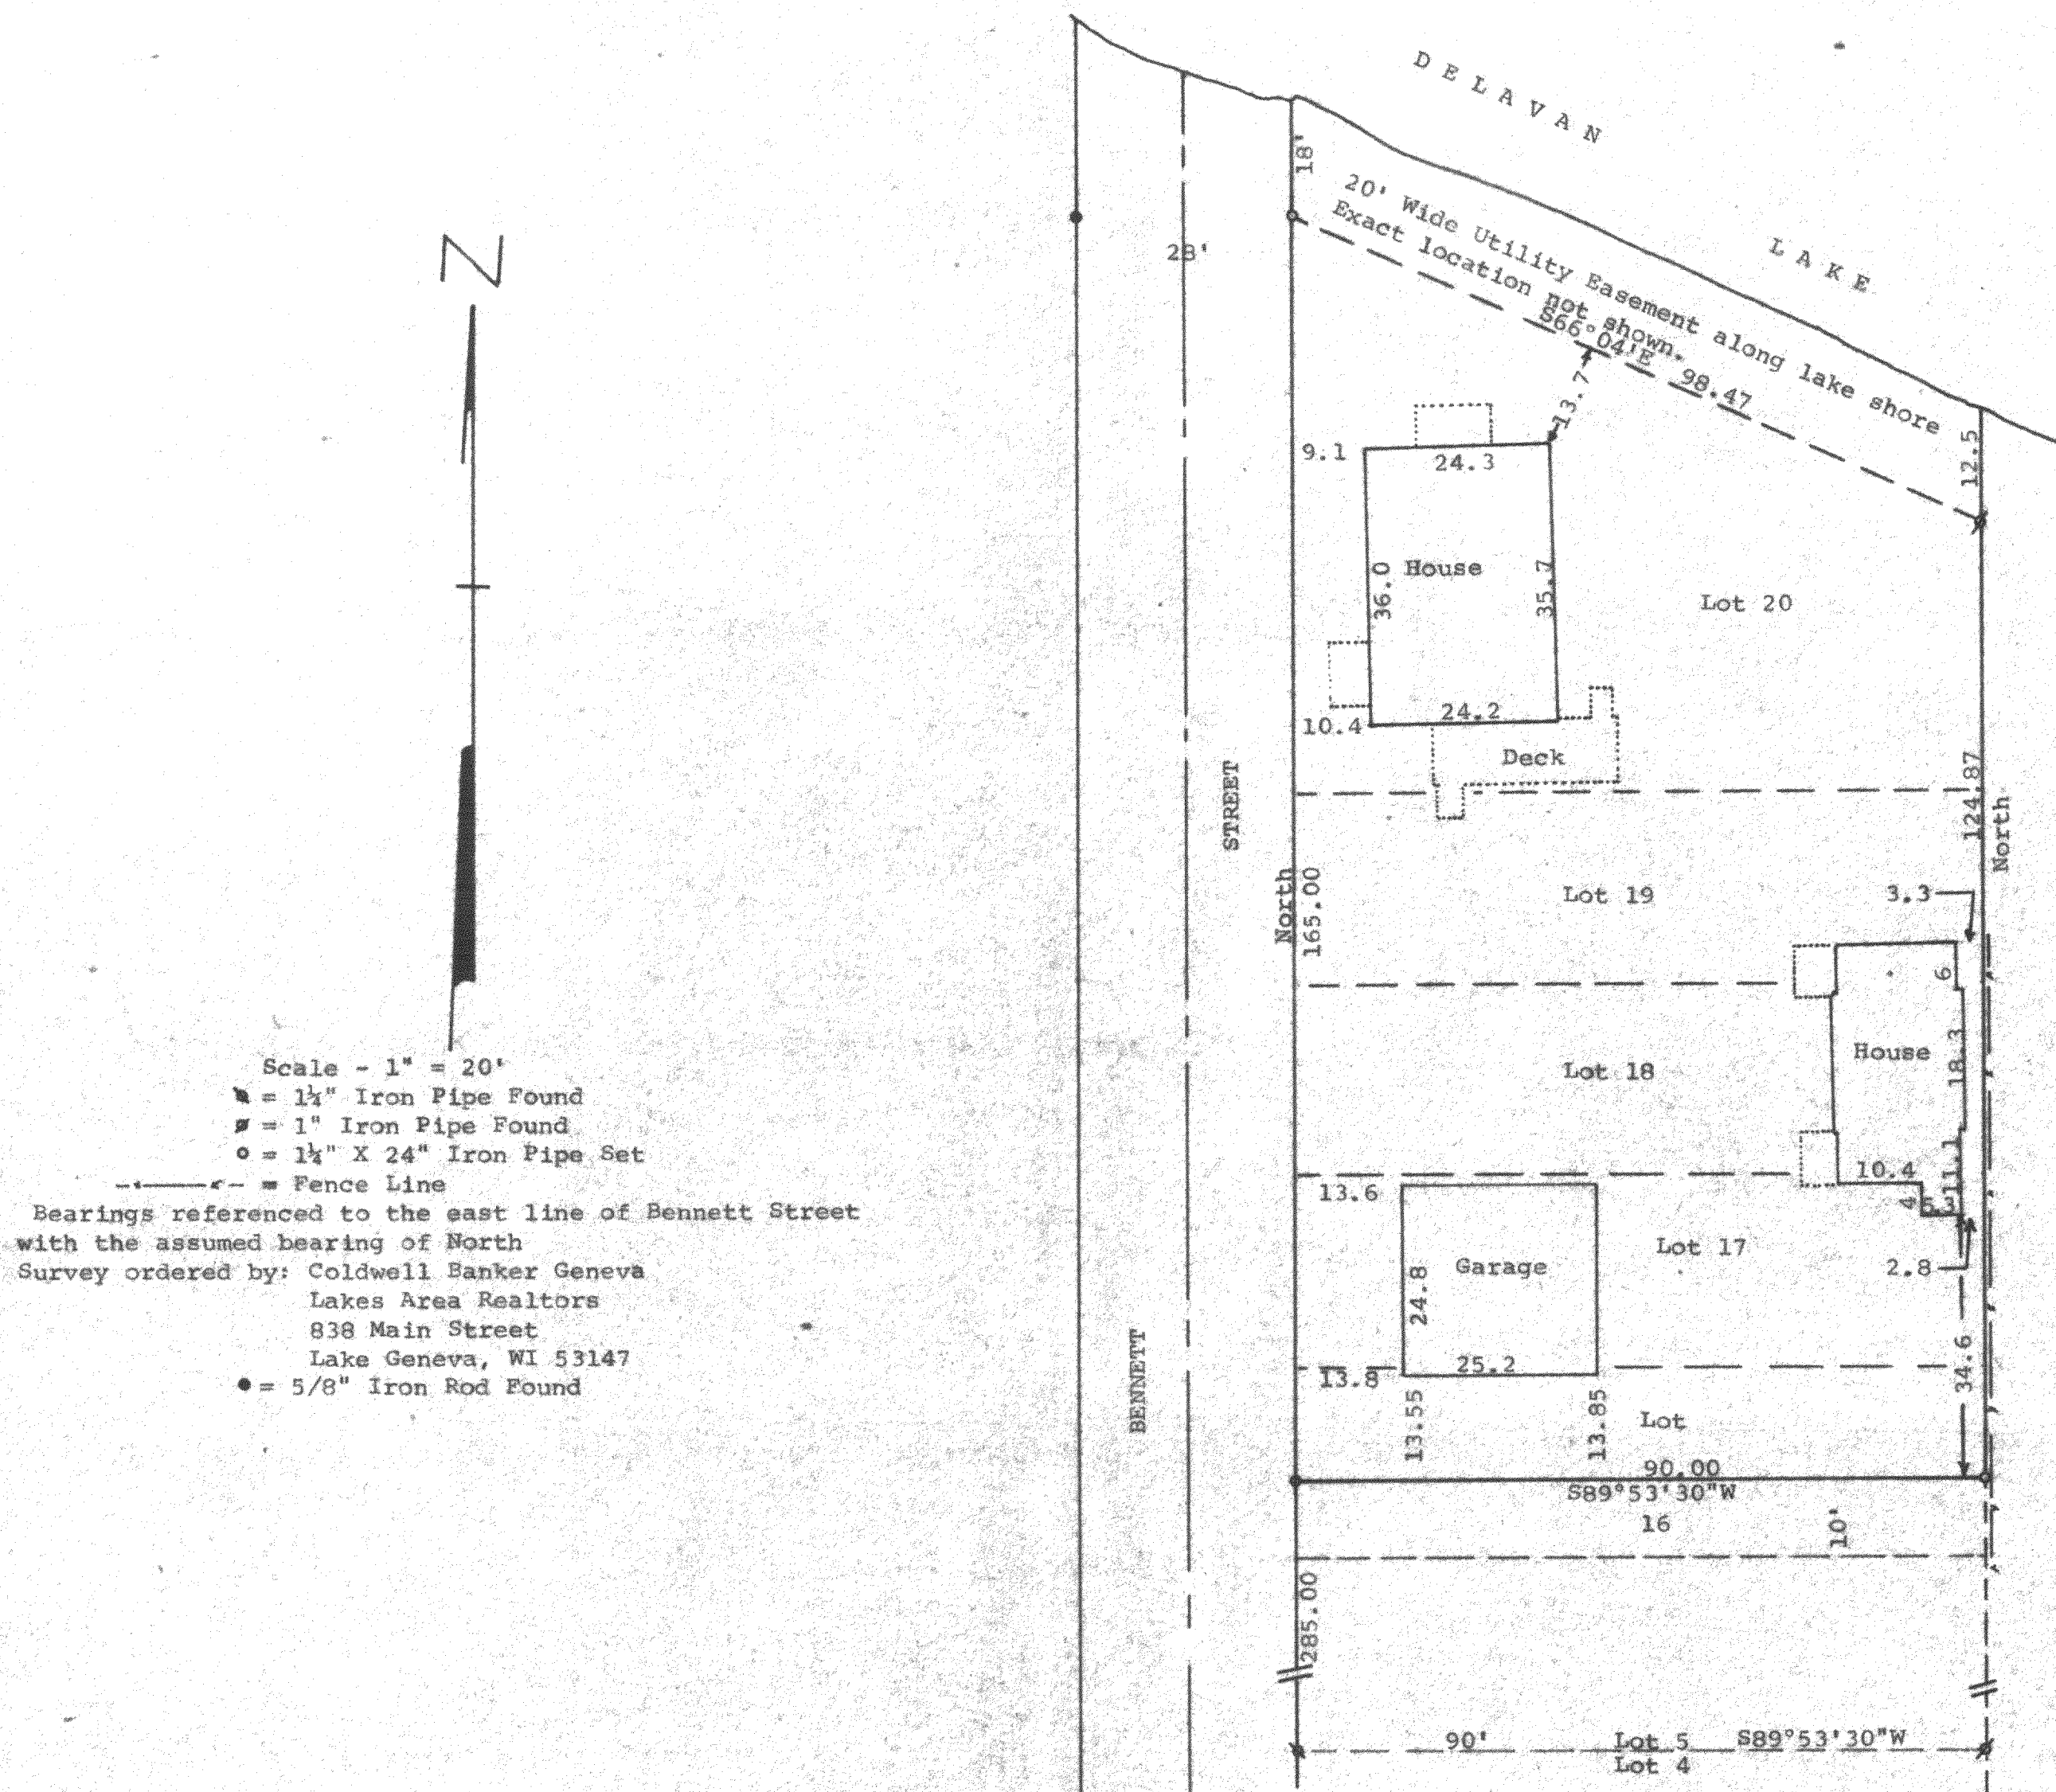


DUNHAM SURVEYING, S.C.
SURVEYING & SUBDIVIDING
DELAVER, WISCONSIN 53115

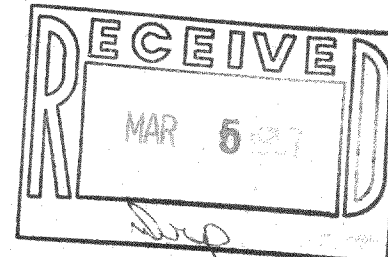

STATE OF WISCONSIN)
COUNTY OF WALWORTH) SS

I, George T. Dunham, Surveyor, certify that I have surveyed the property described as follows:

Lots 16, 17, 18, 19, and 20, Block 1 of Robbins Subdivision located in Section 32, T 2 N, R 16 E, Walworth County, Wisconsin, EXCEPTING therefrom the South 10.00 feet of said Lot 16, Subject to easements, of record.

and that the map shown above is a true representation thereof and shows the size and location of the property, its exterior boundaries, the location of all visible structures and dimensions of all principal buildings thereon, boundary fences, apparent easements, roadways and visible encroachments, if any, and that I have surveyed the property hereon described according to the official records, to the best of my knowledge and belief.

December 4, 1986

George T. Dunham
George T. Dunham, Surveyor

