
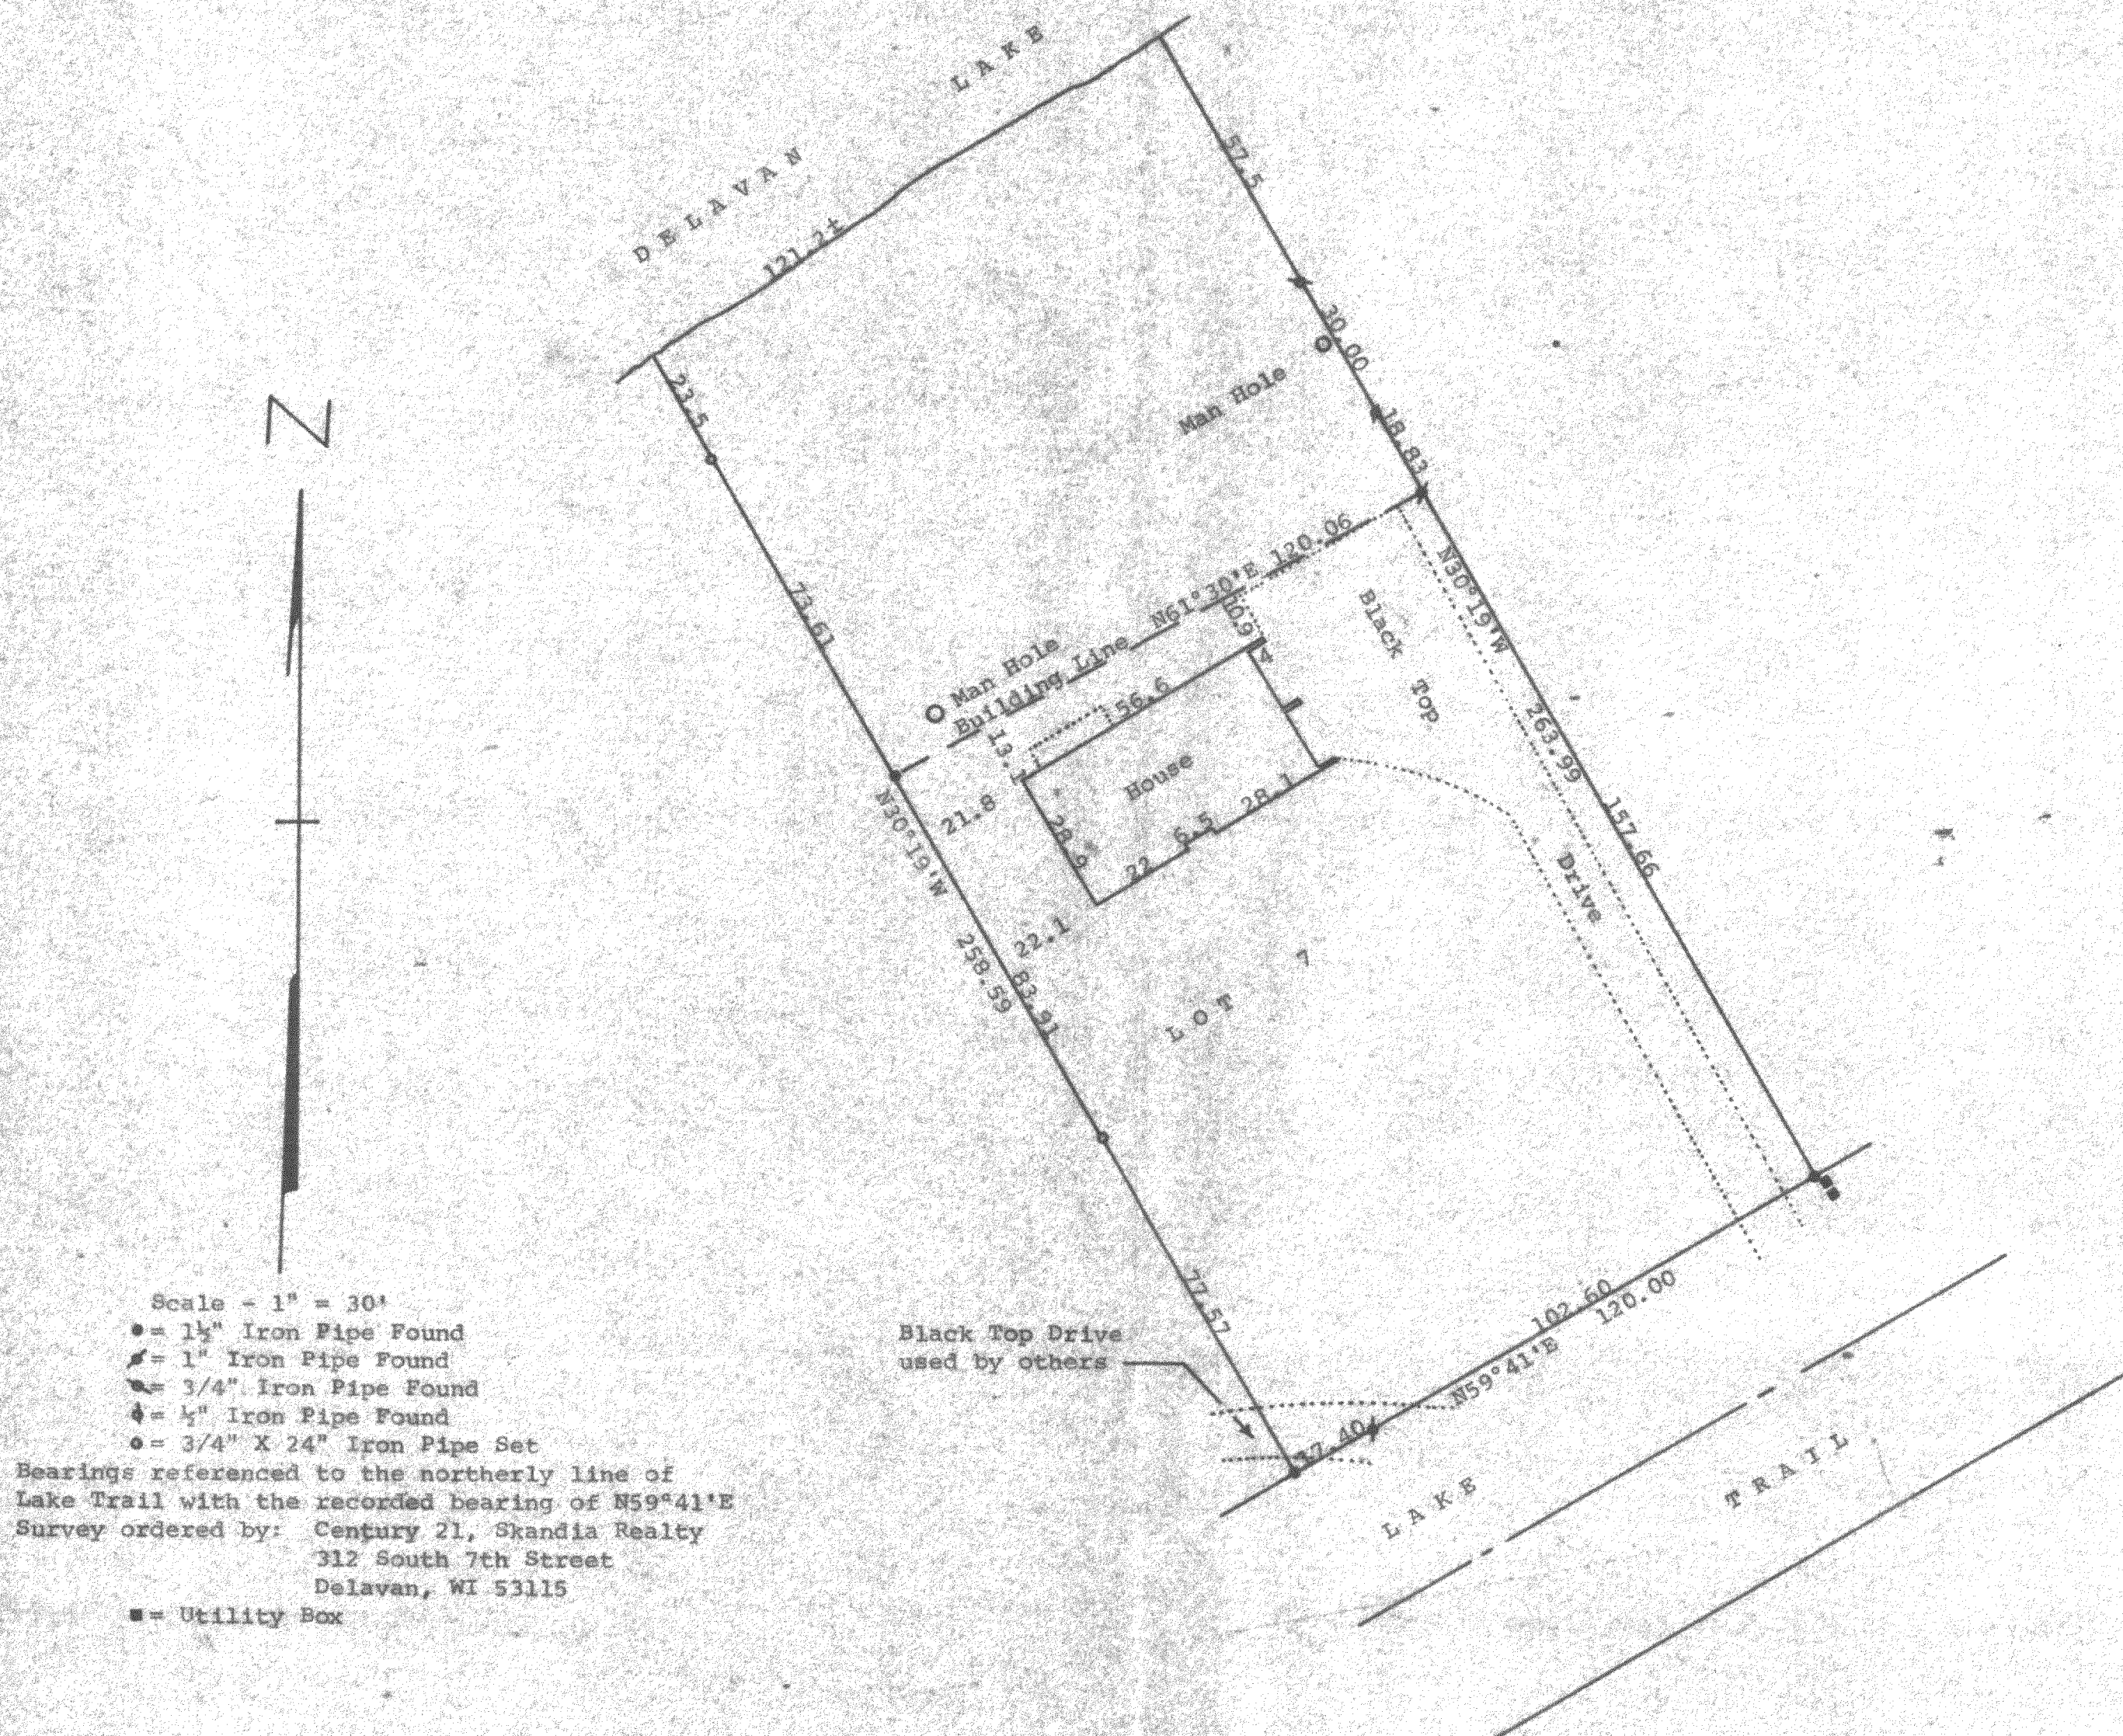


DUNHAM SURVEYING, S.C.
SURVEYING & SUBDIVIDING
DELAVAN, WISCONSIN 53115

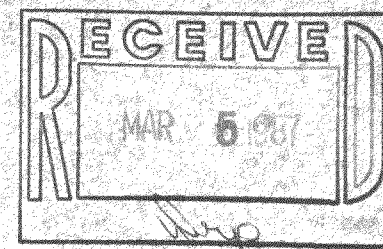

Scale - 1" = 30'

- = 1 1/2" Iron Pipe Found
- = 1" Iron Pipe Found
- = 3/4" Iron Pipe Found
- = 1/2" Iron Pipe Found
- = 3/4" X 24" Iron Pipe Set

Bearings referenced to the northerly line of Lake Trail with the recorded bearing of N59°41'E
Survey ordered by: Century 21, Skandia Realty
312 South 7th Street
Delavan, WI 53115

■ = Utility Box

STATE OF WISCONSIN)
COUNTY OF WAUKESHA) SS

I, George T. Dunham, Surveyor, certify that I have surveyed the property described as follows:

Lot 7 in Lakewood Estates, a subdivision located in the Southwest 1/4 of Section 21, T 2 N, R 16 E, Waukesha County, Wisconsin, and that the map shown above is a true representation thereof and shows the size and location of the property, its exterior boundaries, the location of all visible structures and dimensions of all principal buildings thereon, boundary fences, apparent easements, roadways and visible encroachments, if any, and that I have surveyed the property hereon described according to the official records to the best of my knowledge and belief.

November 19, 1986

George T. Dunham
George T. Dunham, Surveyor

