


RECEIVED
MAR 5 1987
Bro



George T. Dunham
George T. Dunham, Surveyor

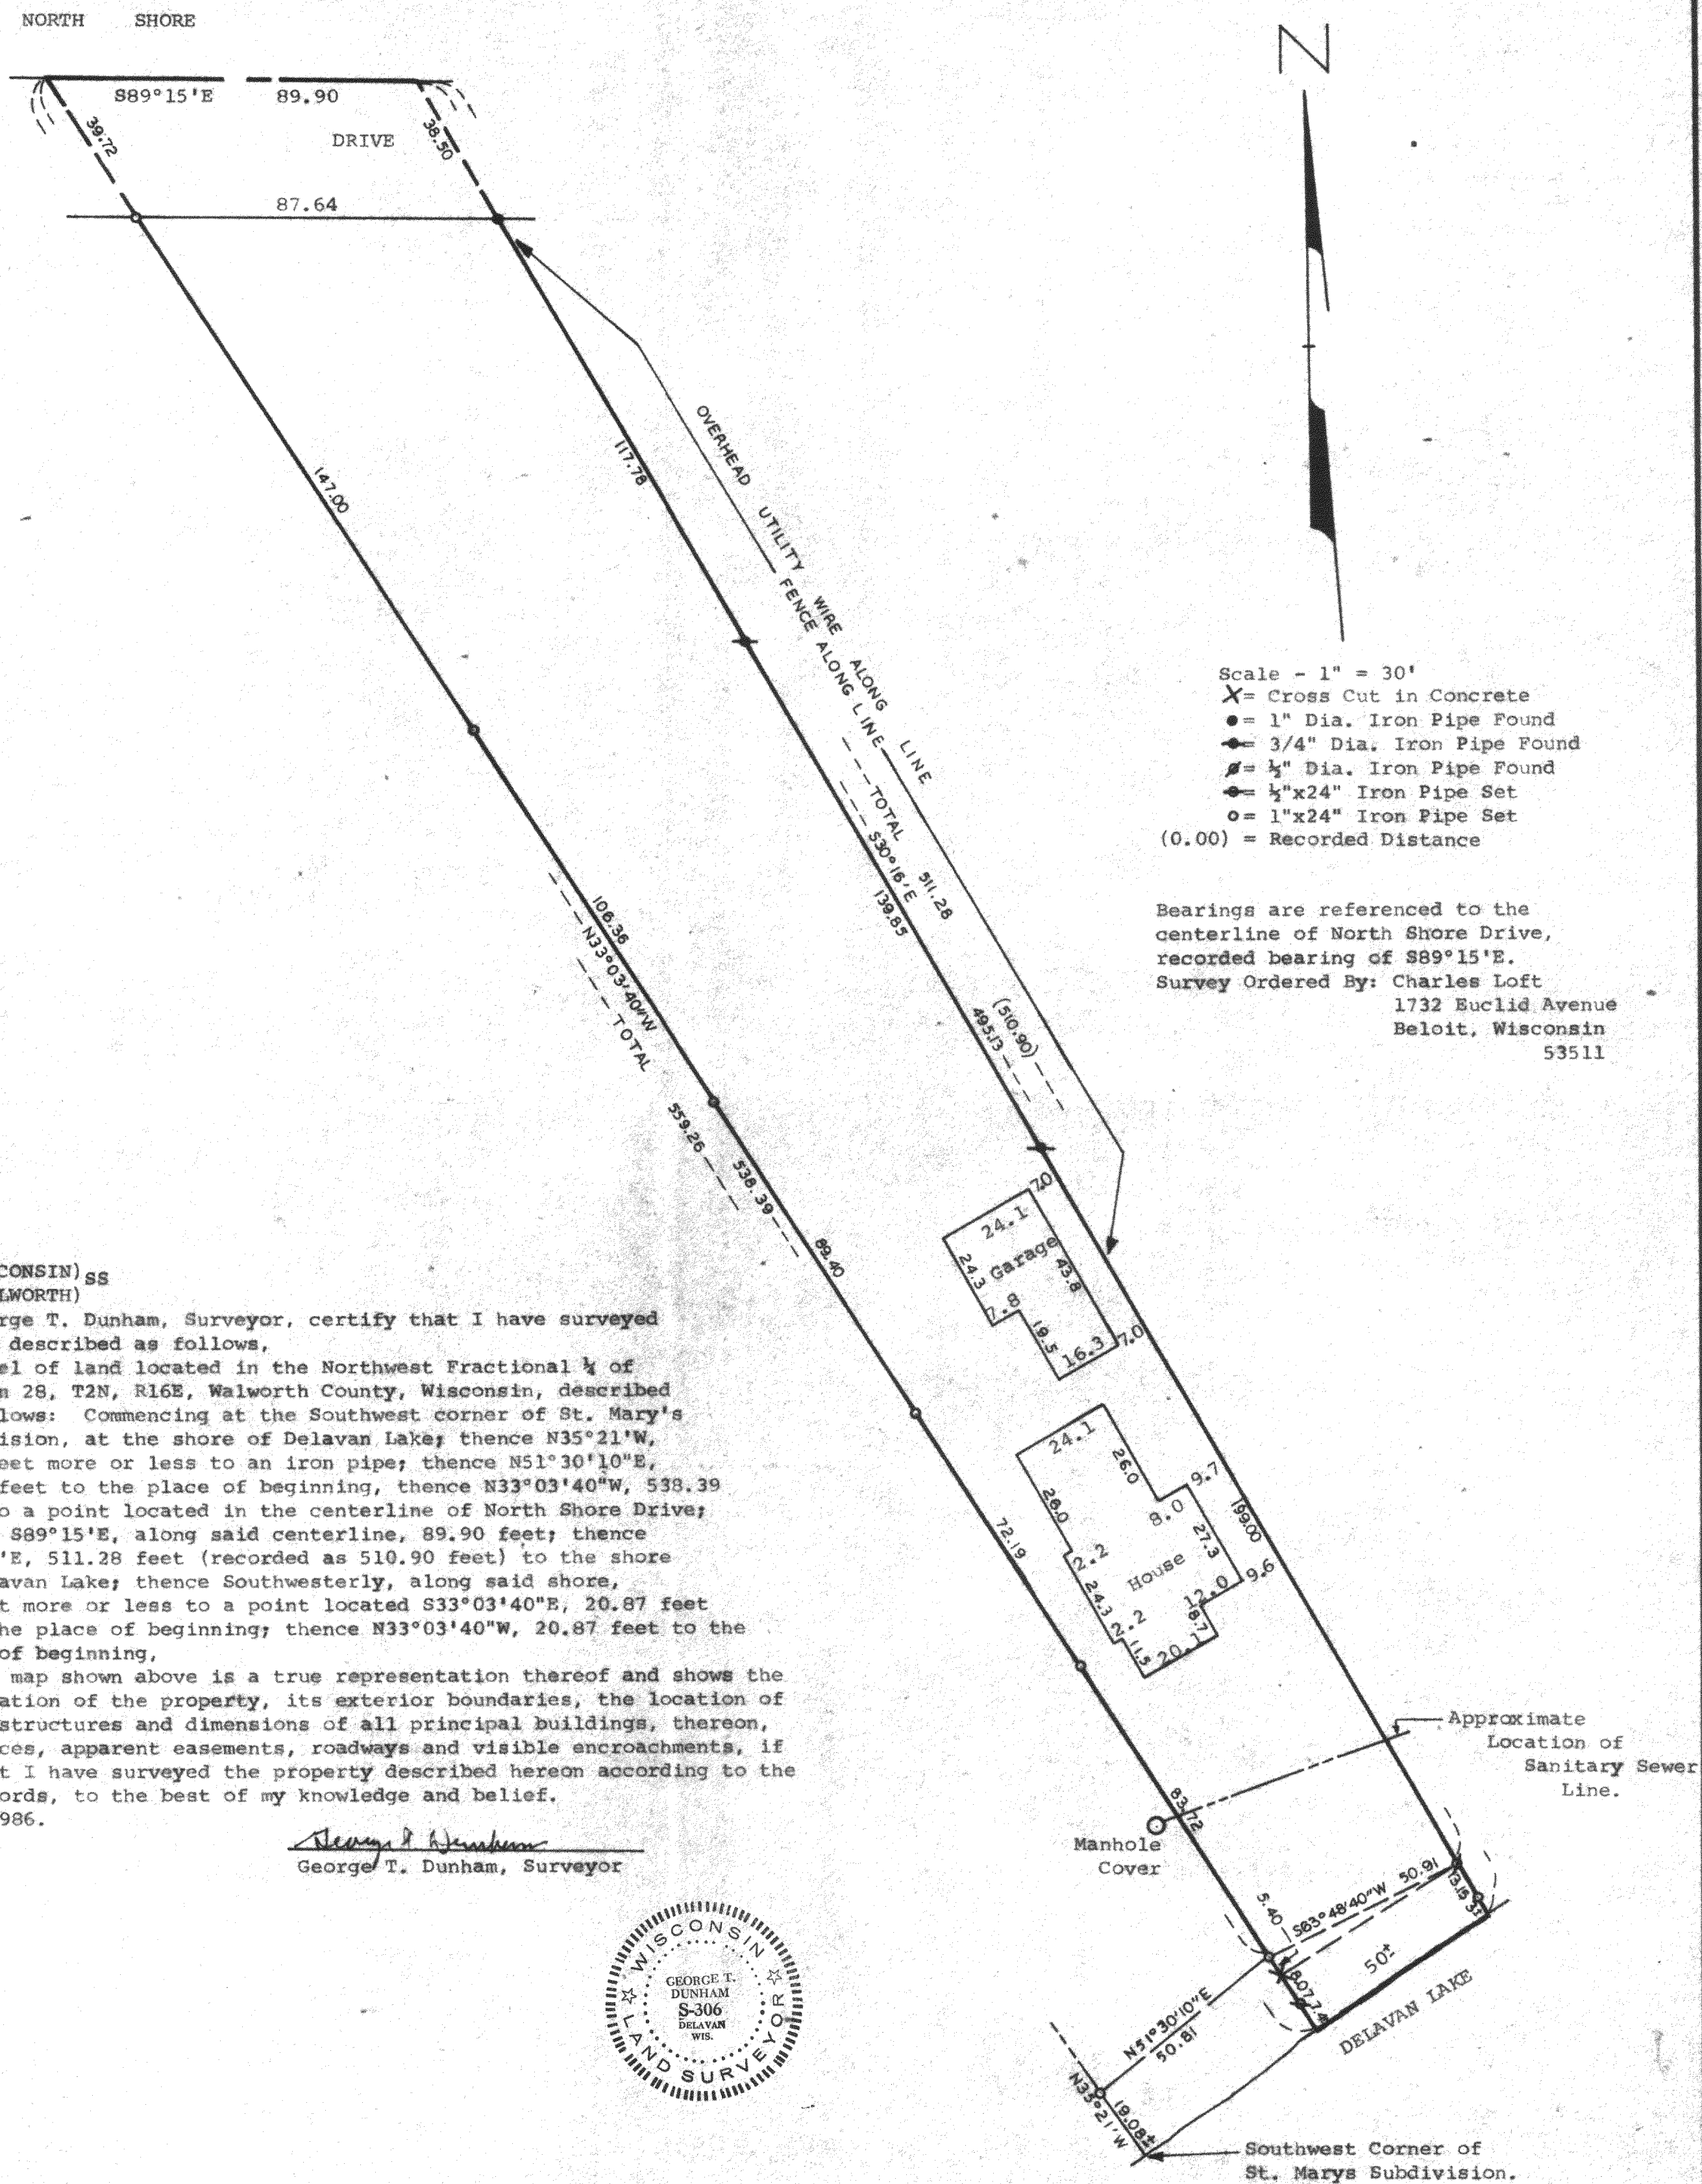