
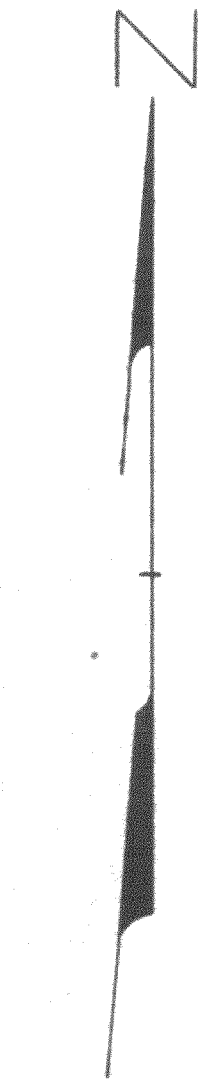


DUNHAM SURVEYING, S.C.
SURVEYING & SUBDIVIDING
DELAN, WISCONSIN 53115

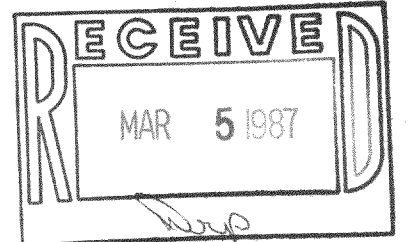


Scale - 1" = 20'
● = 2" Dia. Iron Pipe Found
▲ = 1 1/2" Dia. Iron Pipe Found
▼ = 1" Dia. Iron Pipe Found
○ = 1"x24" Iron Pipe Set
(173.00) = Recorded Distance

Bearings are based on the East line
of Glen Lane, assumed bearing of
North.

Survey Ordered By:
Century 21
Skandia Realty
312 South 7th Street
Delavan, Wisconsin 53115

GLEN

LANE

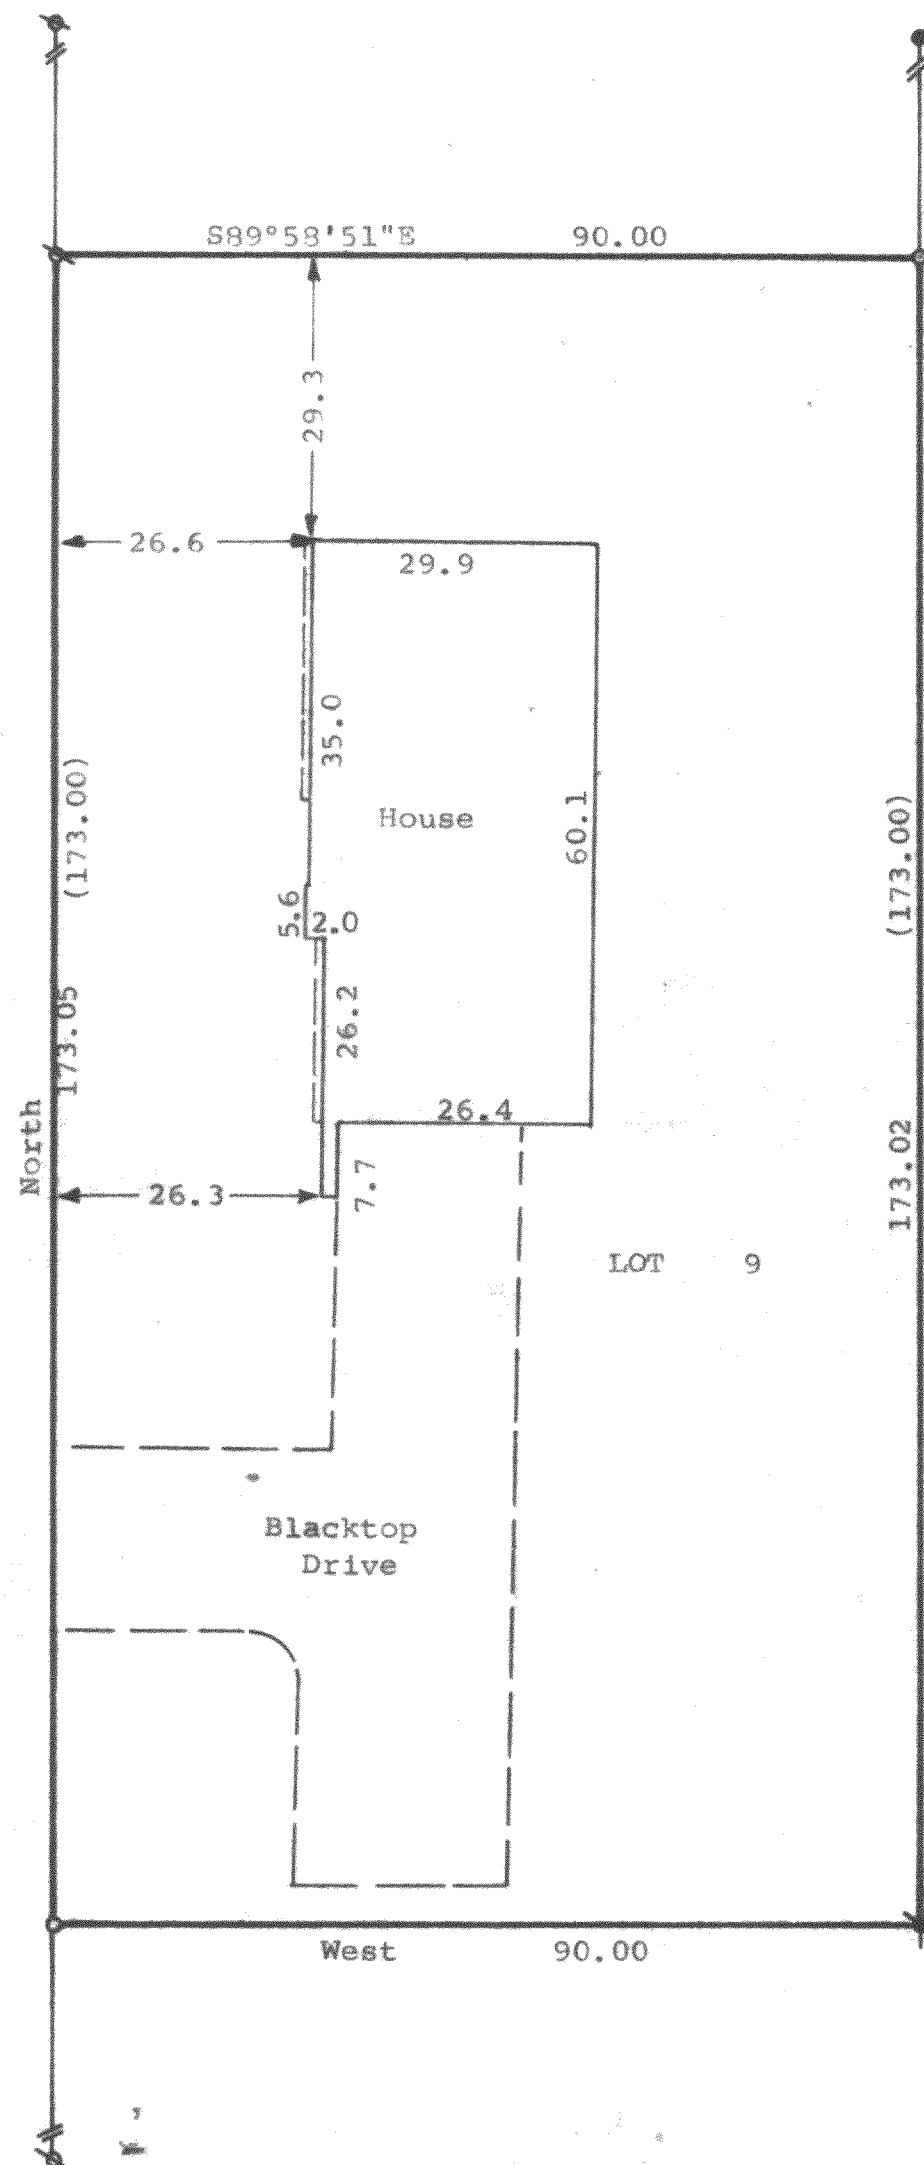

STATE OF WISCONSIN) ss
COUNTY OF WALWORTH)

I, George T. Dunham, Surveyor, certify that I have surveyed the
property described as follows,

Lot 9 of the Re-Subdivision of Lots 1 and 3 of Glen Eyrie, a
subdivision located in the Town of Delavan, Walworth County, Wisconsin,
and that the map shown above is a true representation thereof and shows the
size and location of the property, its exterior boundaries, the location
of all visible structures and dimensions of all principal buildings thereon,
boundary fences, apparent easements, roadways and visible encroachments, if
any, and that I have surveyed the property hereon described according to
the official records, to the best of my knowledge and belief.
September 8, 1986.

George T. Dunham
George T. Dunham, Surveyor

