

FARRIS, HANSEN & ASSOCIATES, INC.

7 RIDGEWAY COURT, P.O. BOX 487, ELKHORN, WISCONSIN

TEL. 414-723-2098





LOCATION: LOT 5 & N 1/2 LOT 6 PARCEL C
MAPLE HURST SUBDIVISION IN THE
TOWN OF DELAVAN WALWORTH CO. WI.

WORK ORDERED BY: SOUTHEASTERN WISCONSIN HOUSING

MAP LEGEND

- = IRON PIPE STAKE FOUND
- = IRON ROD STAKE SET
- = IRON ROD STAKE FOUND
- = WOOD STAKE SET
- = CONCRETE MONUMENT FOUND
- (XXXX) = RECORD DIMENSION

MAP SCALE IN FEET

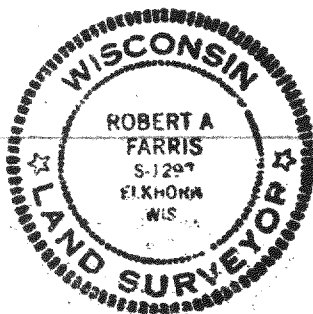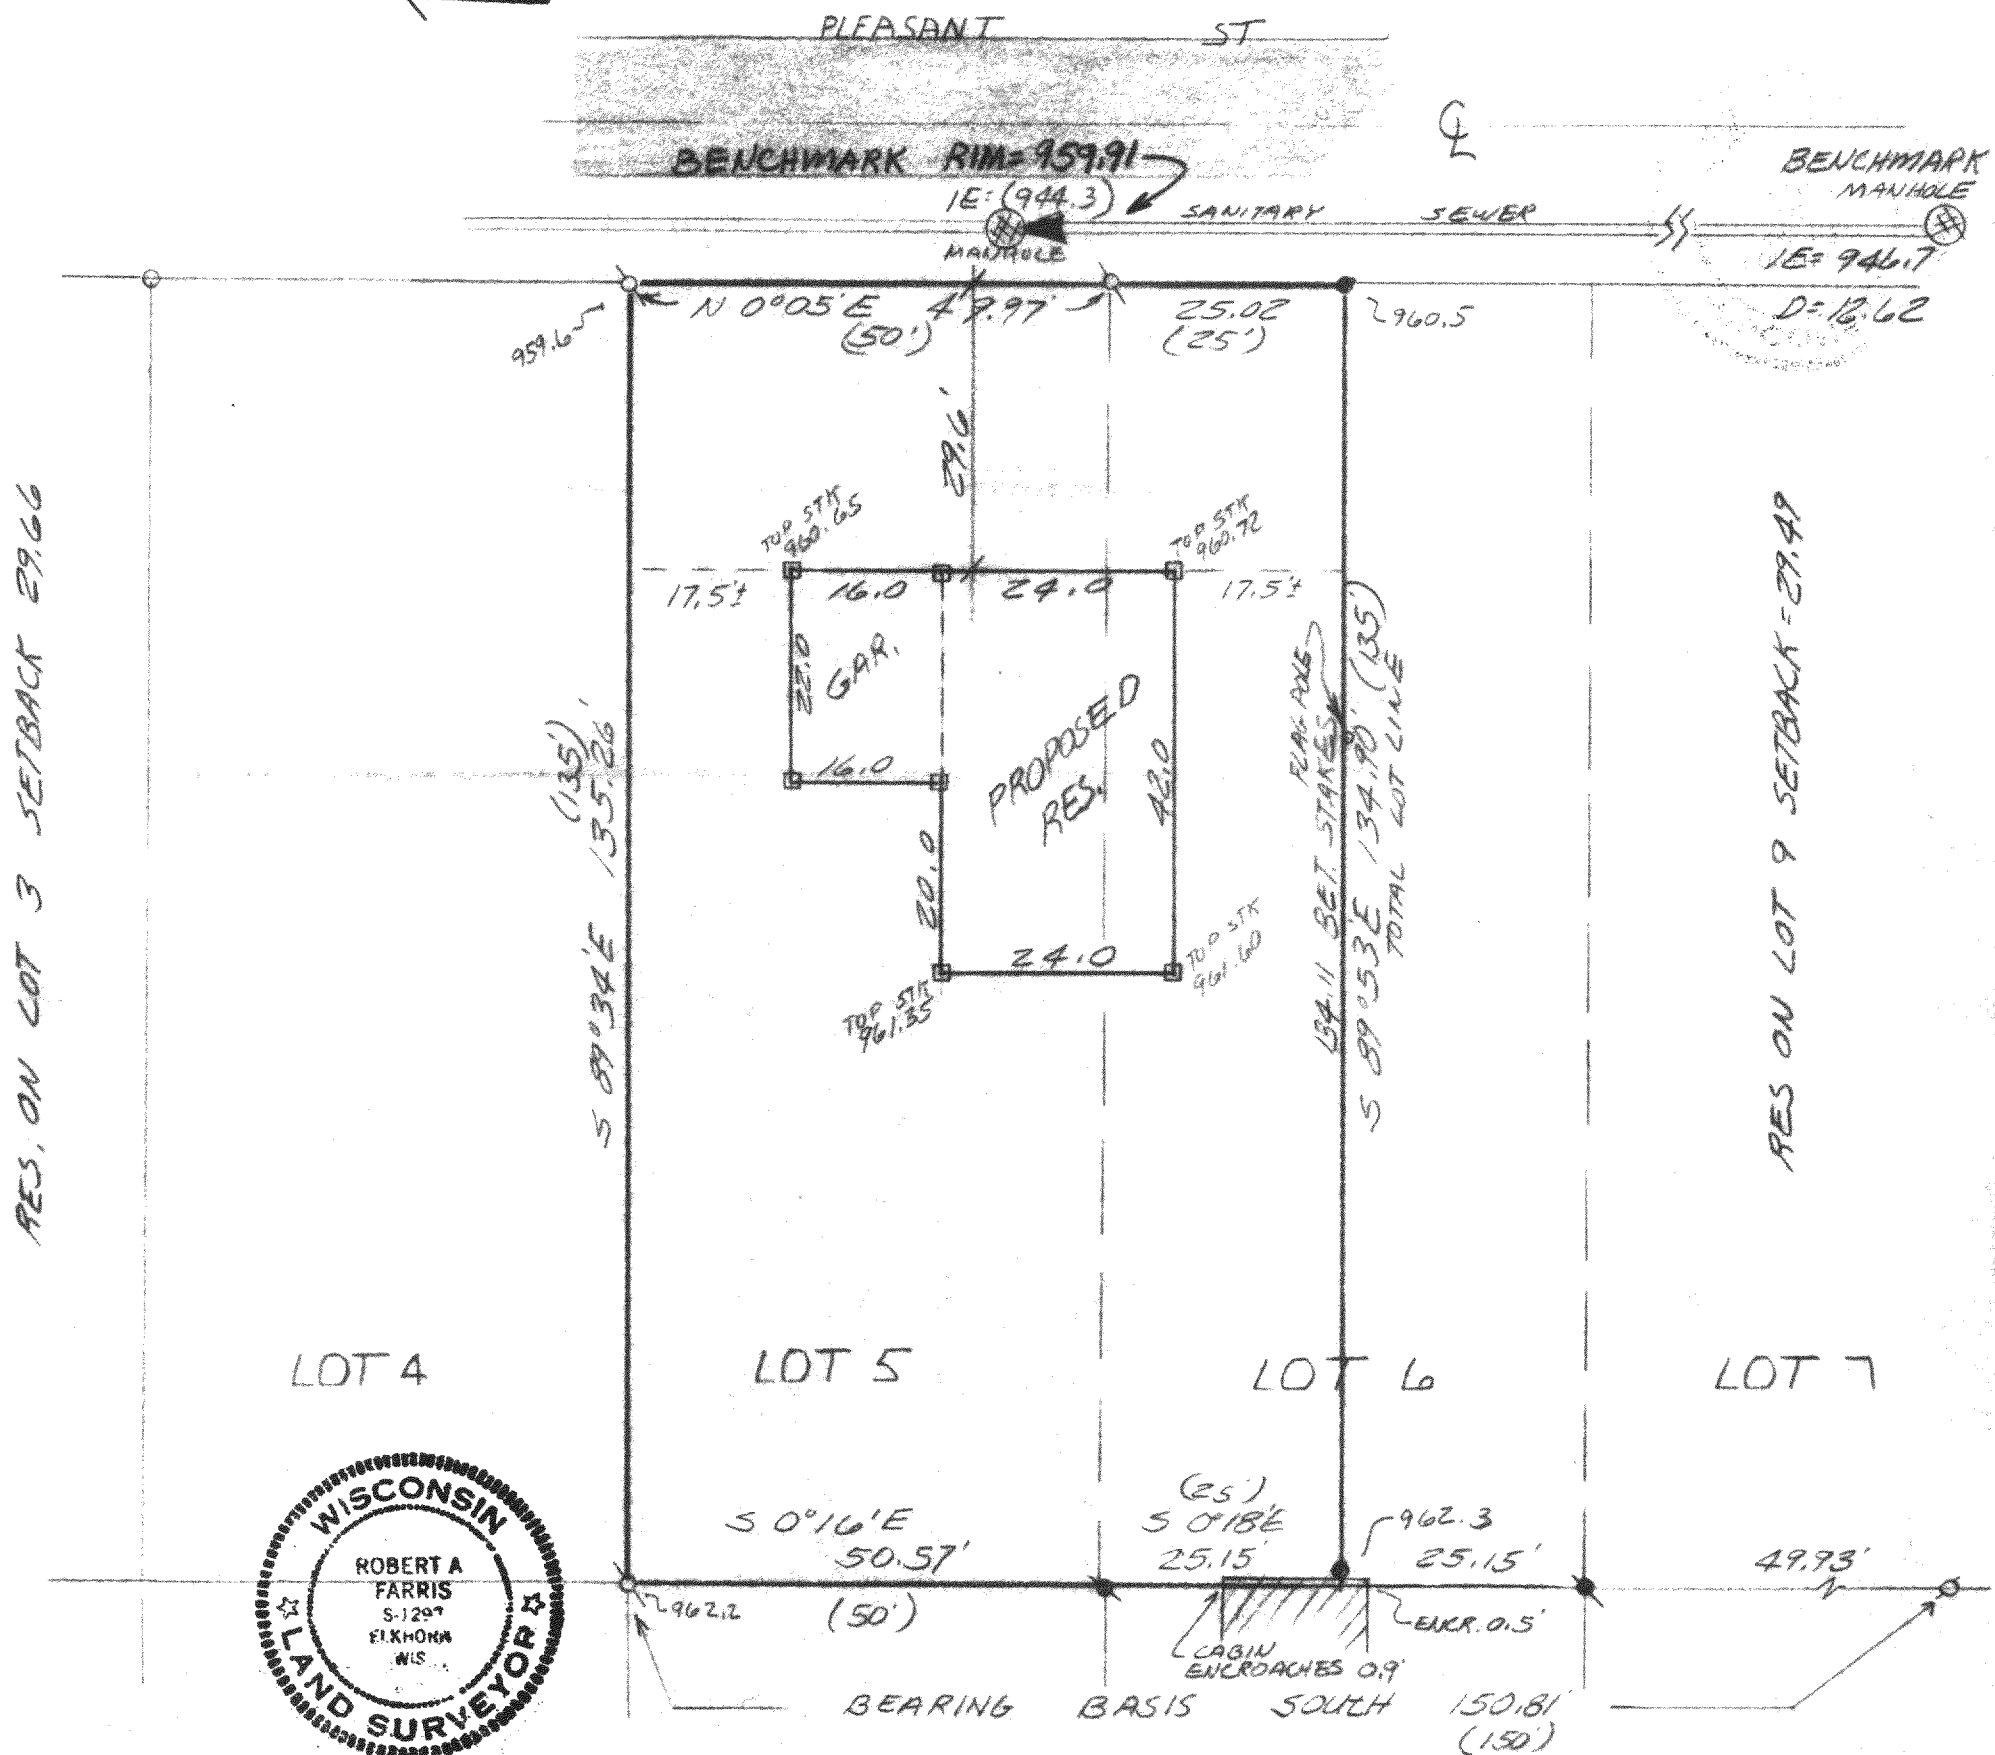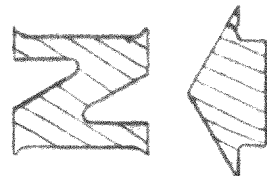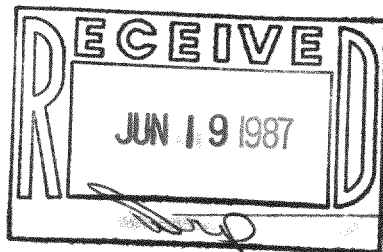

I hereby certify that the above described property has been surveyed under my direction and that the above map is a true representation thereof and shows the size and location of the property, its exterior boundaries, the location of all visible structures and dimensions of all principal buildings thereon, boundary fences, apparent easements, roadways and visible encroachments, if any. This survey is made for the use of the present owners of the property, and also those who purchase, mortgage, or guarantee the title thereto within one year from the date hereof.

DATED : 05/04/87

Robert A. Farris

PROJ. NO. 2777.01