


DUNHAM SURVEYING, S.C.
SURVEYING & SUBDIVIDING
DELAVER, WISCONSIN 53115

S U T T E R

A V E N U E

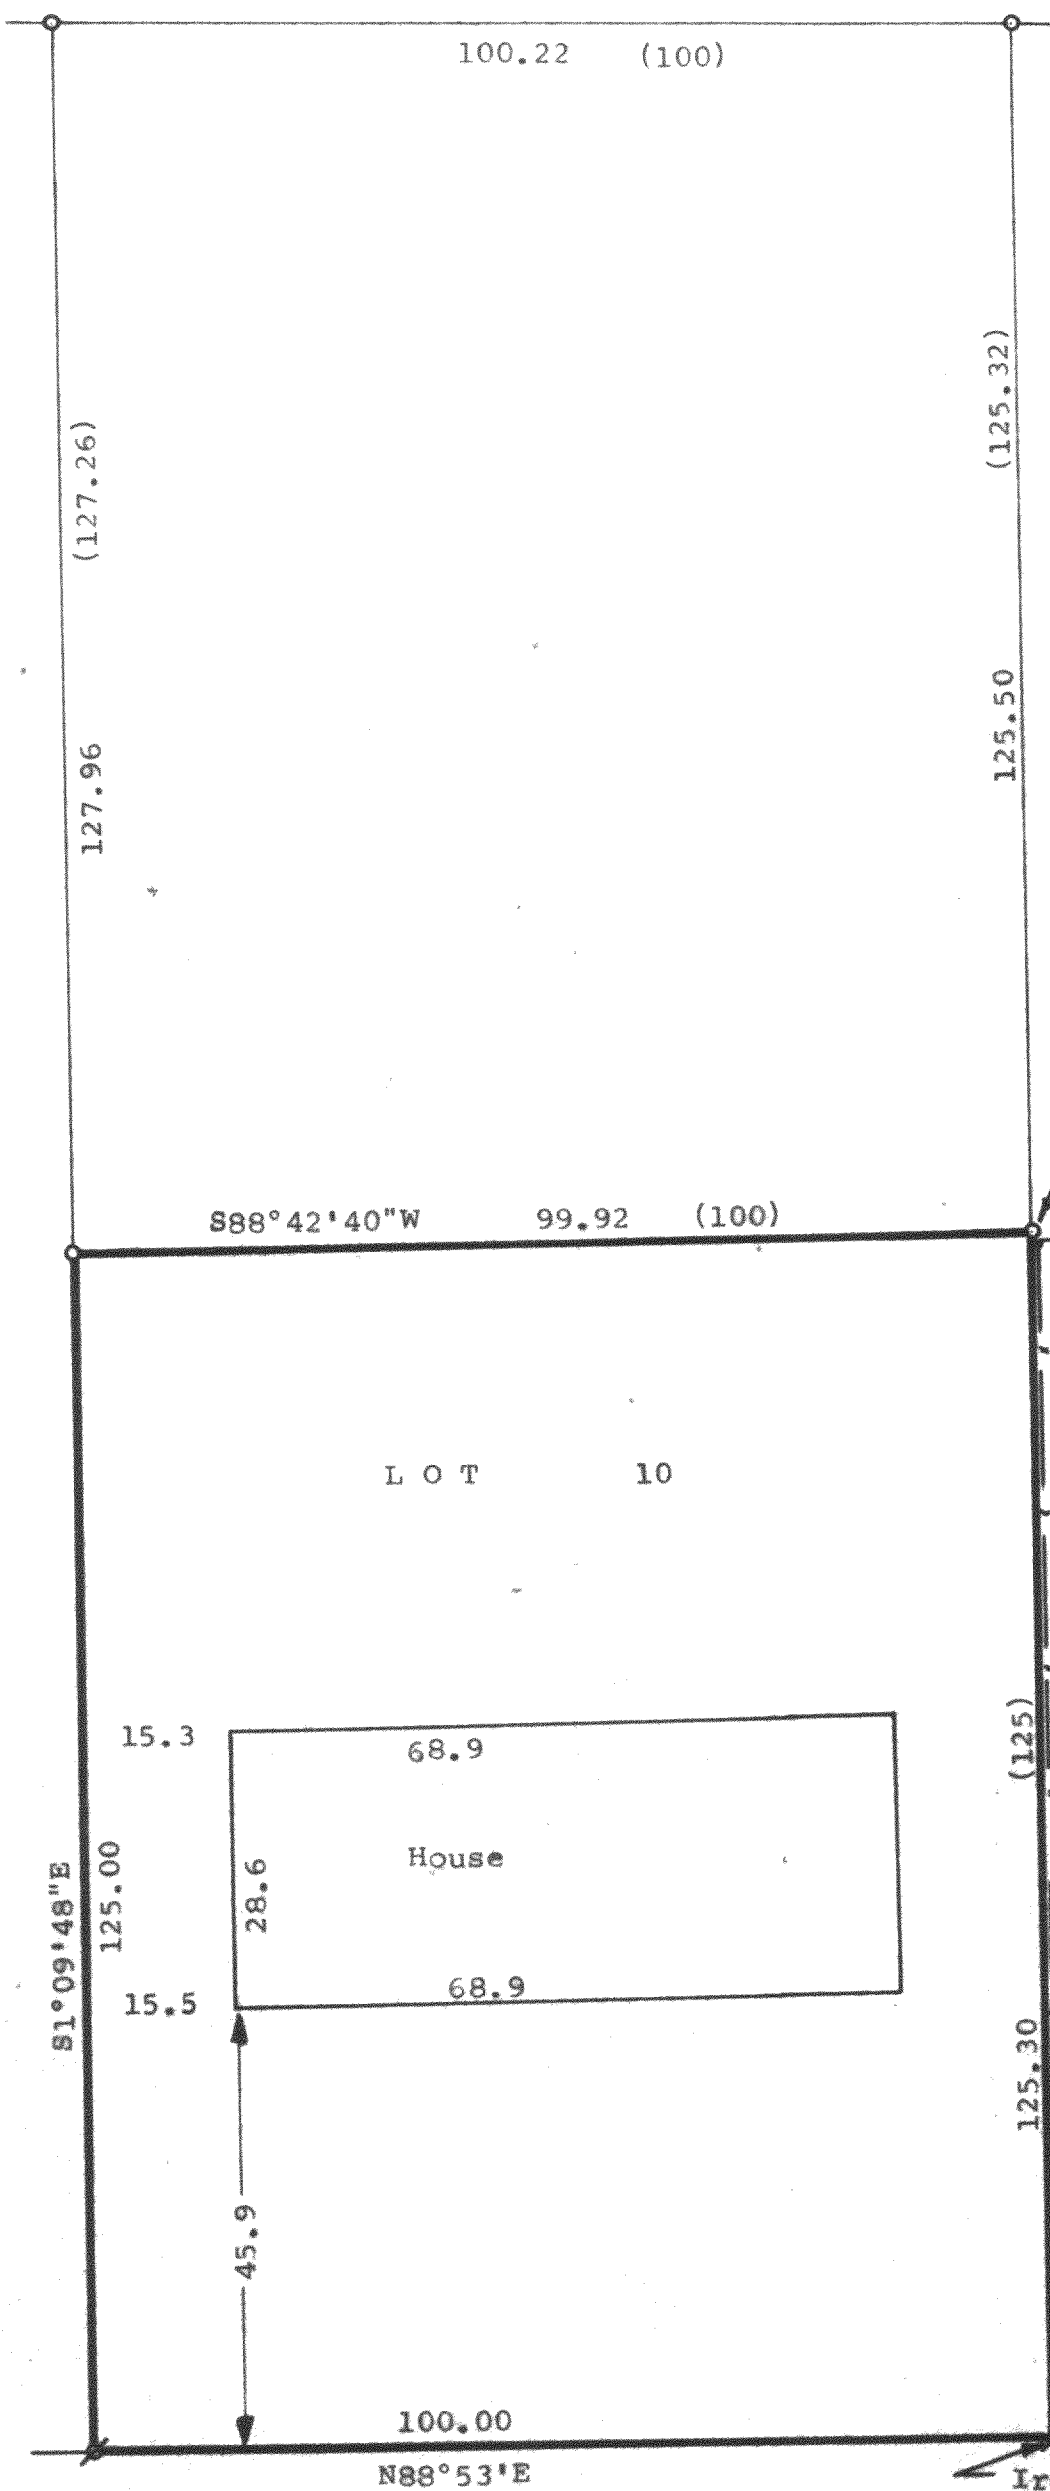

B A I L E Y

R O A D



Scale - 1" = 20'
● = 2" Dia. Iron Pipe Found
○ = 1" Dia. Iron Pipe Found
⊙ = 1" Dia. Iron Pipe Found and Reset
(100) = Recorded Distance

Bearings are referenced to the North line of Bailey Road, recorded bearing of N88°53'E.

Survey Ordered By: Realty World
Carmin Realtors
811 East Geneva Street
Delavan, Wisconsin 53115

STATE OF WISCONSIN) SS
COUNTY OF WALWORTH)

I, George T. Dunham, Surveyor, certify that I have surveyed the property described as follows:
Lot 10, Block 17 of Delmar, a subdivision located in the Southwest 1/4 of Section 27, T2N, R16E, Walworth County, Wisconsin,

and that the map shown hereon is a correct representation thereof and shows the size and location of the property, its exterior boundaries, the location of all visible structures and dimensions of all principal buildings thereon, boundary fences, apparent easements, roadways and visible encroachments, if any, and that I have surveyed the property hereon described according to the official records, to the best of my knowledge and belief.
April 27, 1987.

George T. Dunham
George T. Dunham, Surveyor

