


JUNIOR

TERRACE

PLAICE

BRIAR

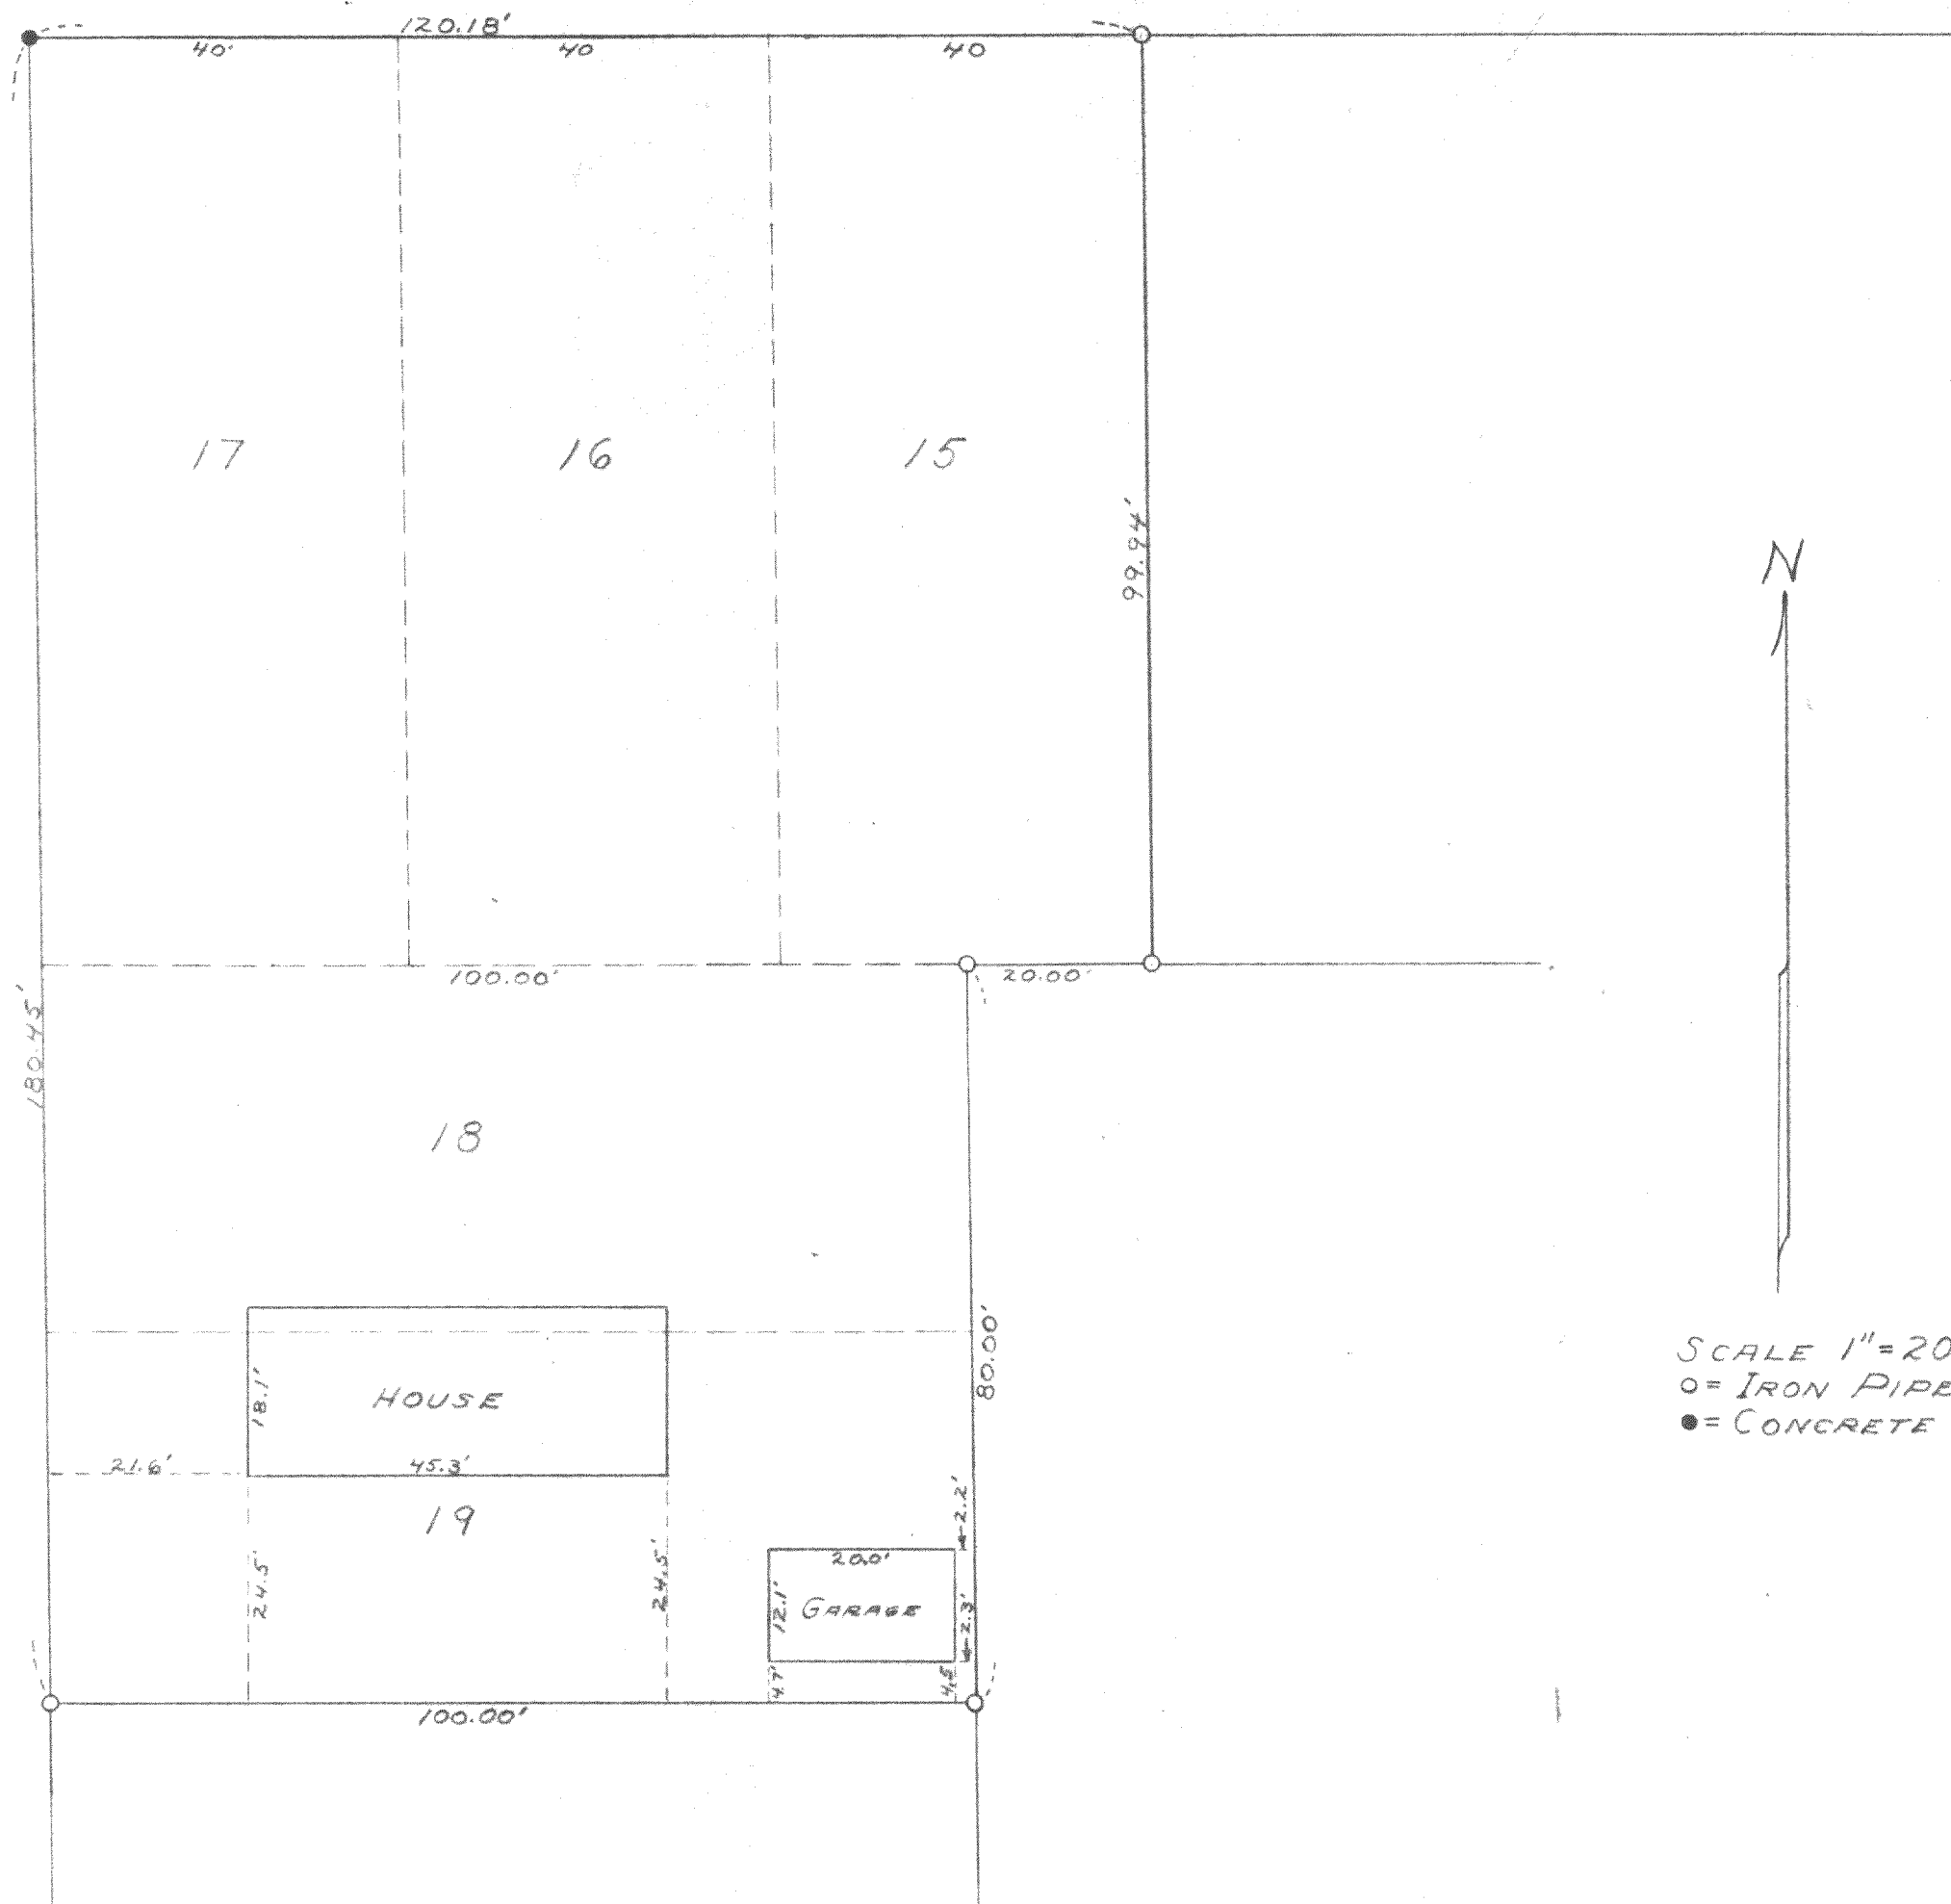

STATE OF WISCONSIN) ss
COUNTY OF WALWORTH)

I, LLOYD L. JENSEN, DO HEREBY CERTIFY THAT I HAVE SURVEYED THE PROPERTY DESCRIBED, ACCORDING TO THE OFFICIAL RECORDS, AS FOLLOWS:

LOTS 15, 16, 17, 18, & 19 OF BLOCK 11, OF THE 1ST ADDITION OF SOUTH SHORE MANOR, LOCATED IN THE SE 1/4 OF SECTION 32, T21N R16E, WALWORTH COUNTY, WISCONSIN, AND THAT THE ABOVE PLAT IS A CORRECT REPRESENTATION OF THE LOT LINES, PRINCIPLE LINES OF ALL BUILDINGS THEREON, AND ALL ENCROACHMENTS ON OR BY THE PREMISES.

ELKHORN, WISCONSIN
MARCH 20, 1951

Lloyd L. Jensen
SURVEYOR

216-9601

FSS1-39
11-40