

**ABELL
SURVEYING & MAPPING**
DELAVAN, WISCONSIN 53115
414-728-6737


SECOND STREET

OAK DRIVE



PLAT OF SURVEY OF

LOT 20, BLOCK 2, INLET OAKS
SUBDIVISION NO. 3, T2N, R16E,
WALWORTH COUNTY, WISCONSIN.

ORDERED BY:
CENTURY 21 SKANDIA REALTY
312 S. 7th STREET
DELAVAN, WI 53115

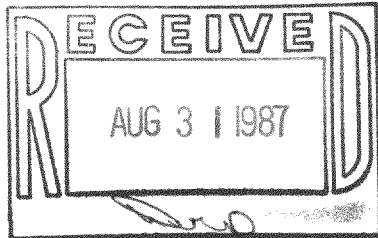

BLOCK

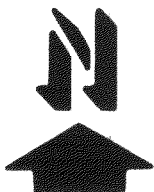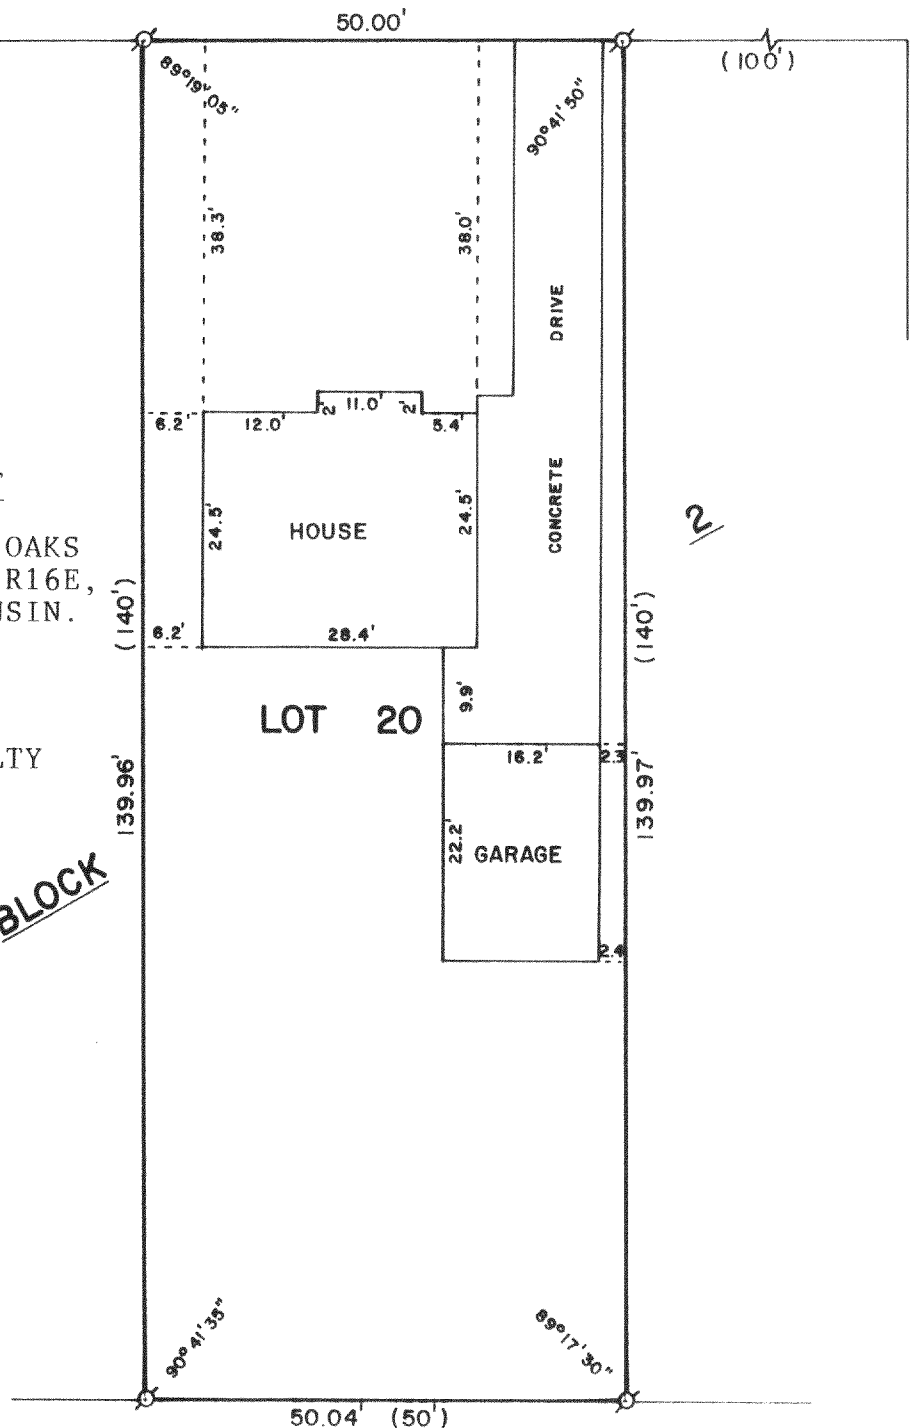

SCALE - 1"=20'

LEGEND

⊗ - IRON PIPE FOUND
() - RECORDED AS

I, DAVID F. ABELL, DO HEREBY CERTIFY
THAT I HAVE SURVEYED THE PROPERTY
HEREON DESCRIBED ACCORDING TO THE
OFFICIAL RECORDS AND THAT THE PLAT
HEREON IS A CORRECT REPRESENTATION
OF THE PROPERTY LINES TO THE BEST OF
MY KNOWLEDGE AND BELIEF.

David F. Abell

DAVID F. ABELL
WISCONSIN REGISTERED LAND SURVEYOR, S-1596

August 12, 1987

DATE JOB NUMBER - 87109

NOTE: THIS IS NOT A CERTIFIED COPY UNLESS SEALED.