


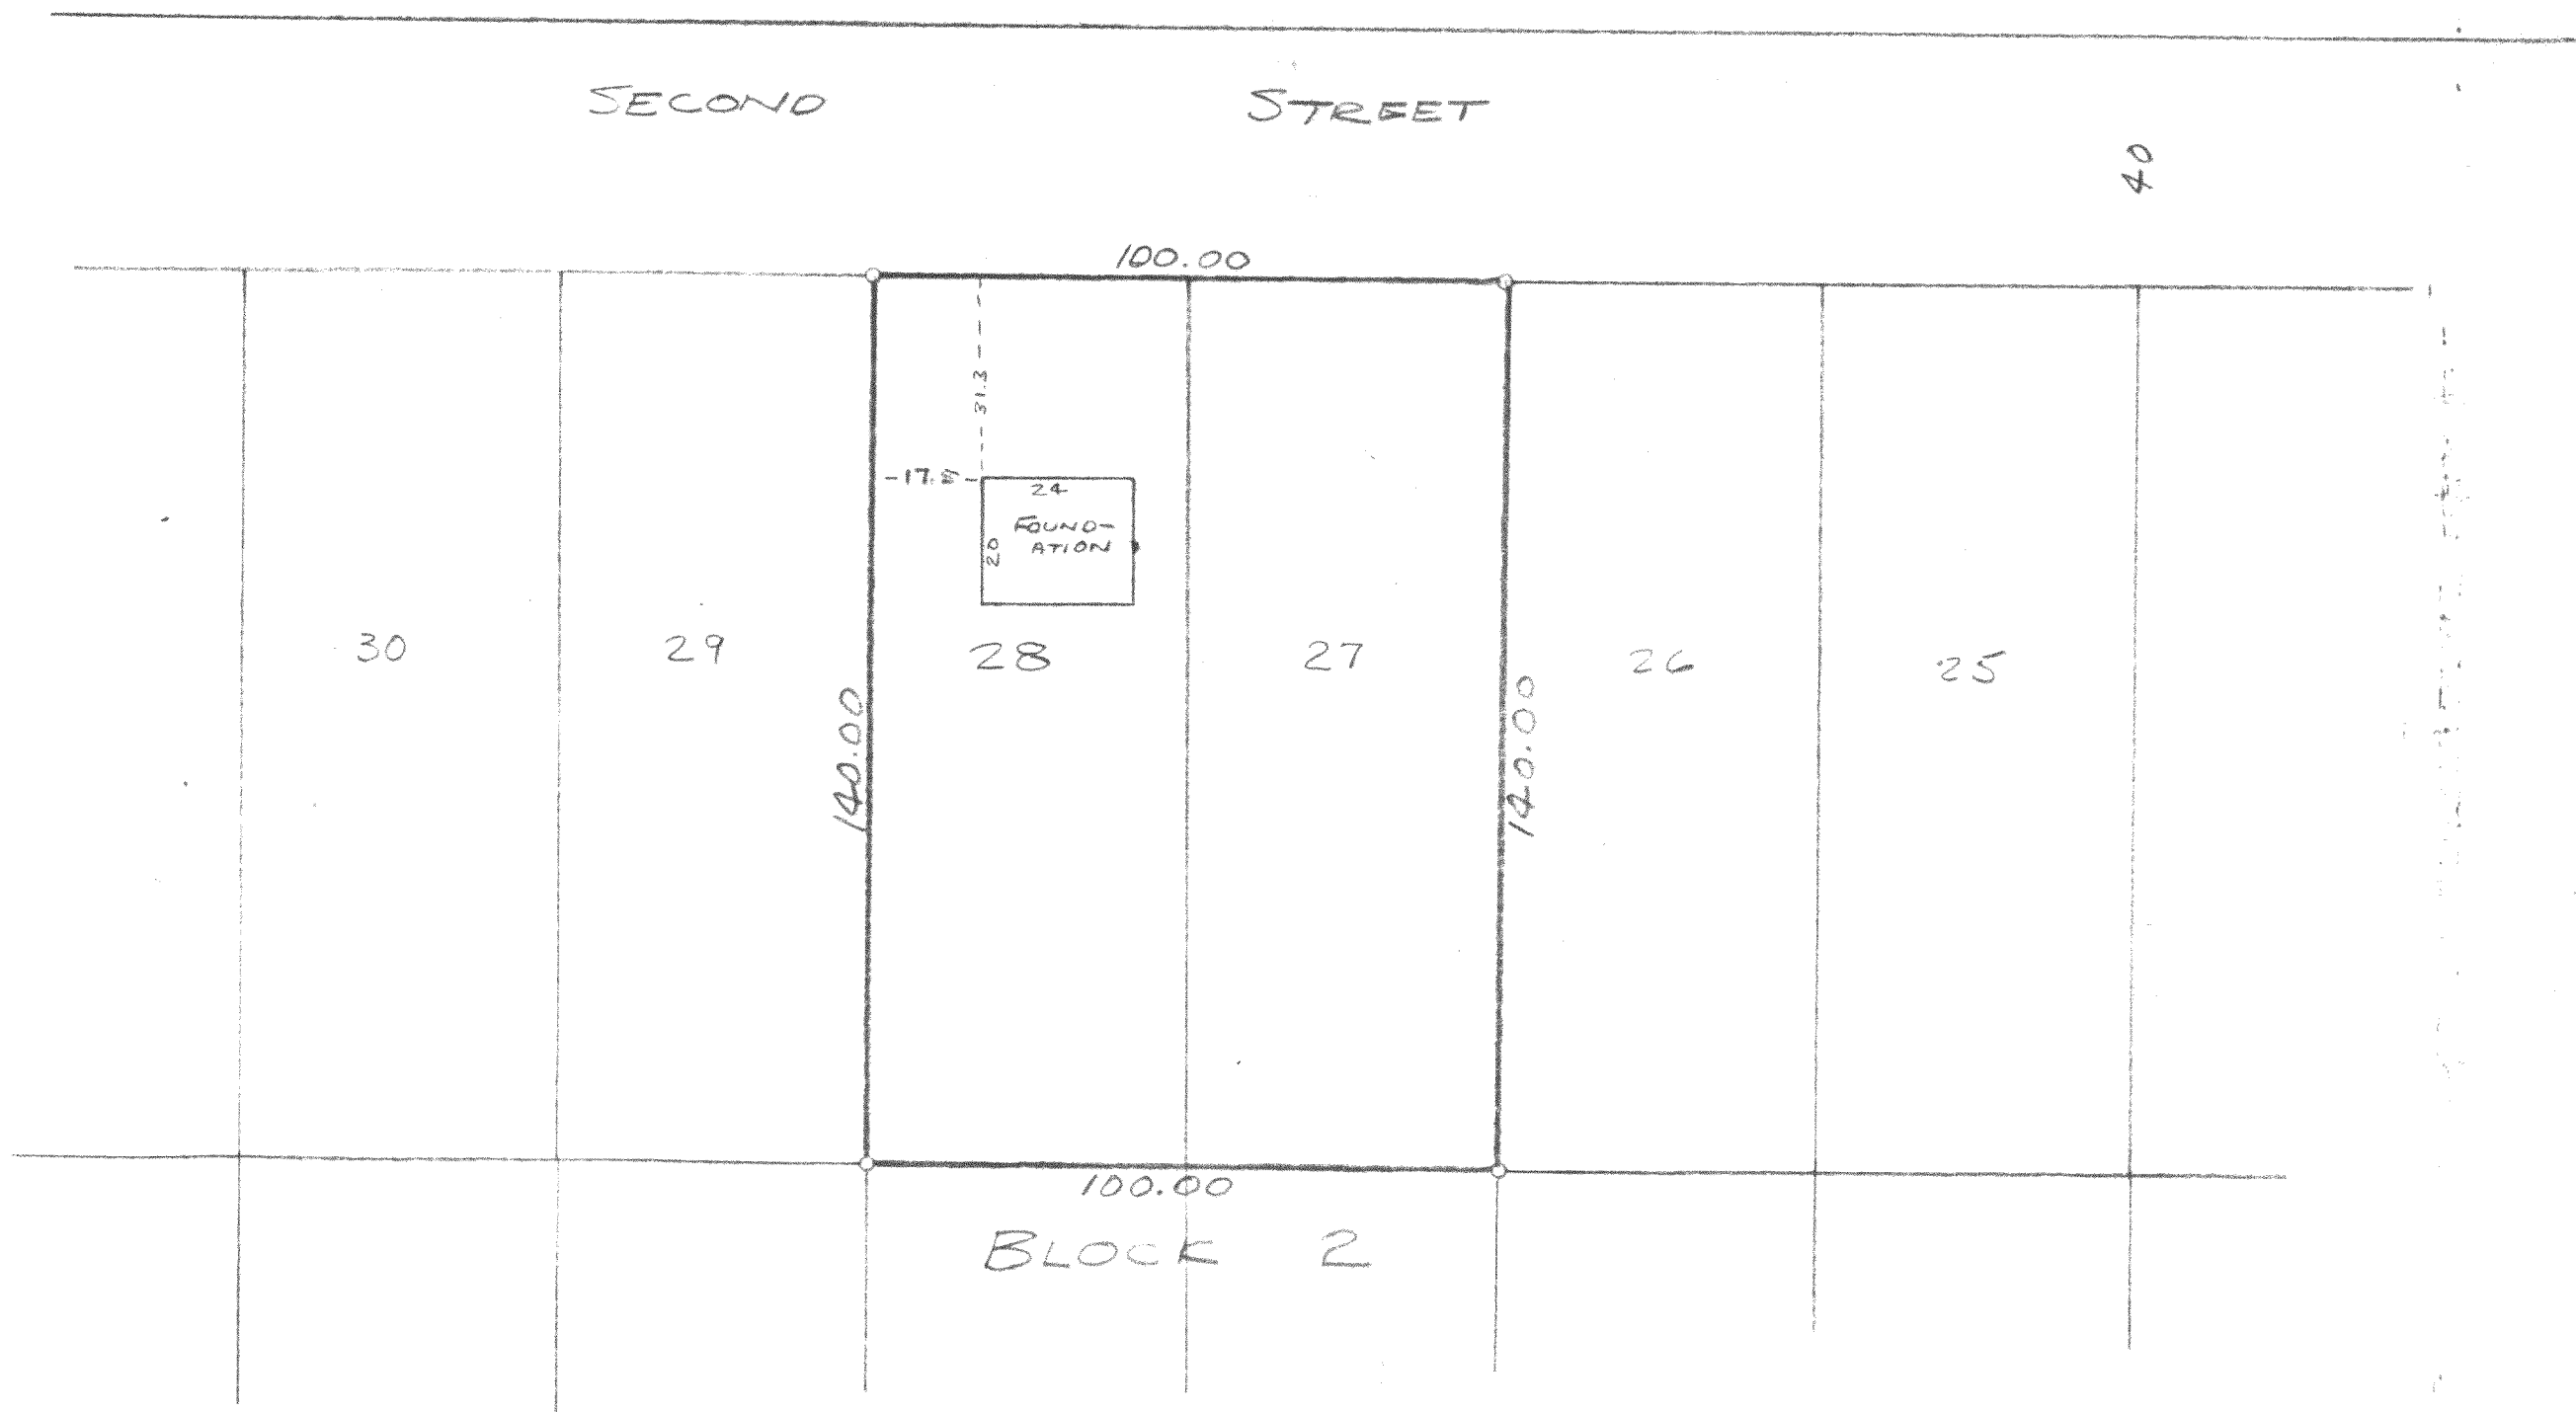

SCALE 1"=30'

○ = IRON PIPE

STATE OF WISCONSIN) ss
COUNTY OF WALWORTH)

I, LLOYD L. JENSEN, DO HEREBY CERTIFY THAT I
HAVE SURVEYED THE PROPERTY DESCRIBED, ACCORDING TO THE OFFICIAL
RECORDS, AS FOLLOWS:

LOTS 27 & 28 OF BLOCK 2 OF INLET OAKS No 3, A
SUBDIVISION LOCATED IN THE SE 1/4 OF SECTION 15, AND
THE NE 1/4 OF SECTION 22, T2N R16E, WALWORTH
COUNTY, WISCONSIN;

AND THAT THE ABOVE PLAT IS A CORRECT REPRESENTATION
OF THE LOT LINES, AND THE PRINCIPAL LINES OF ALL
BUILDINGS THEREON.

ELKHORN, WIS.
MARCH 29, 1951

Lloyd L. Jensen
COUNTY SURVEYOR 216-9701