


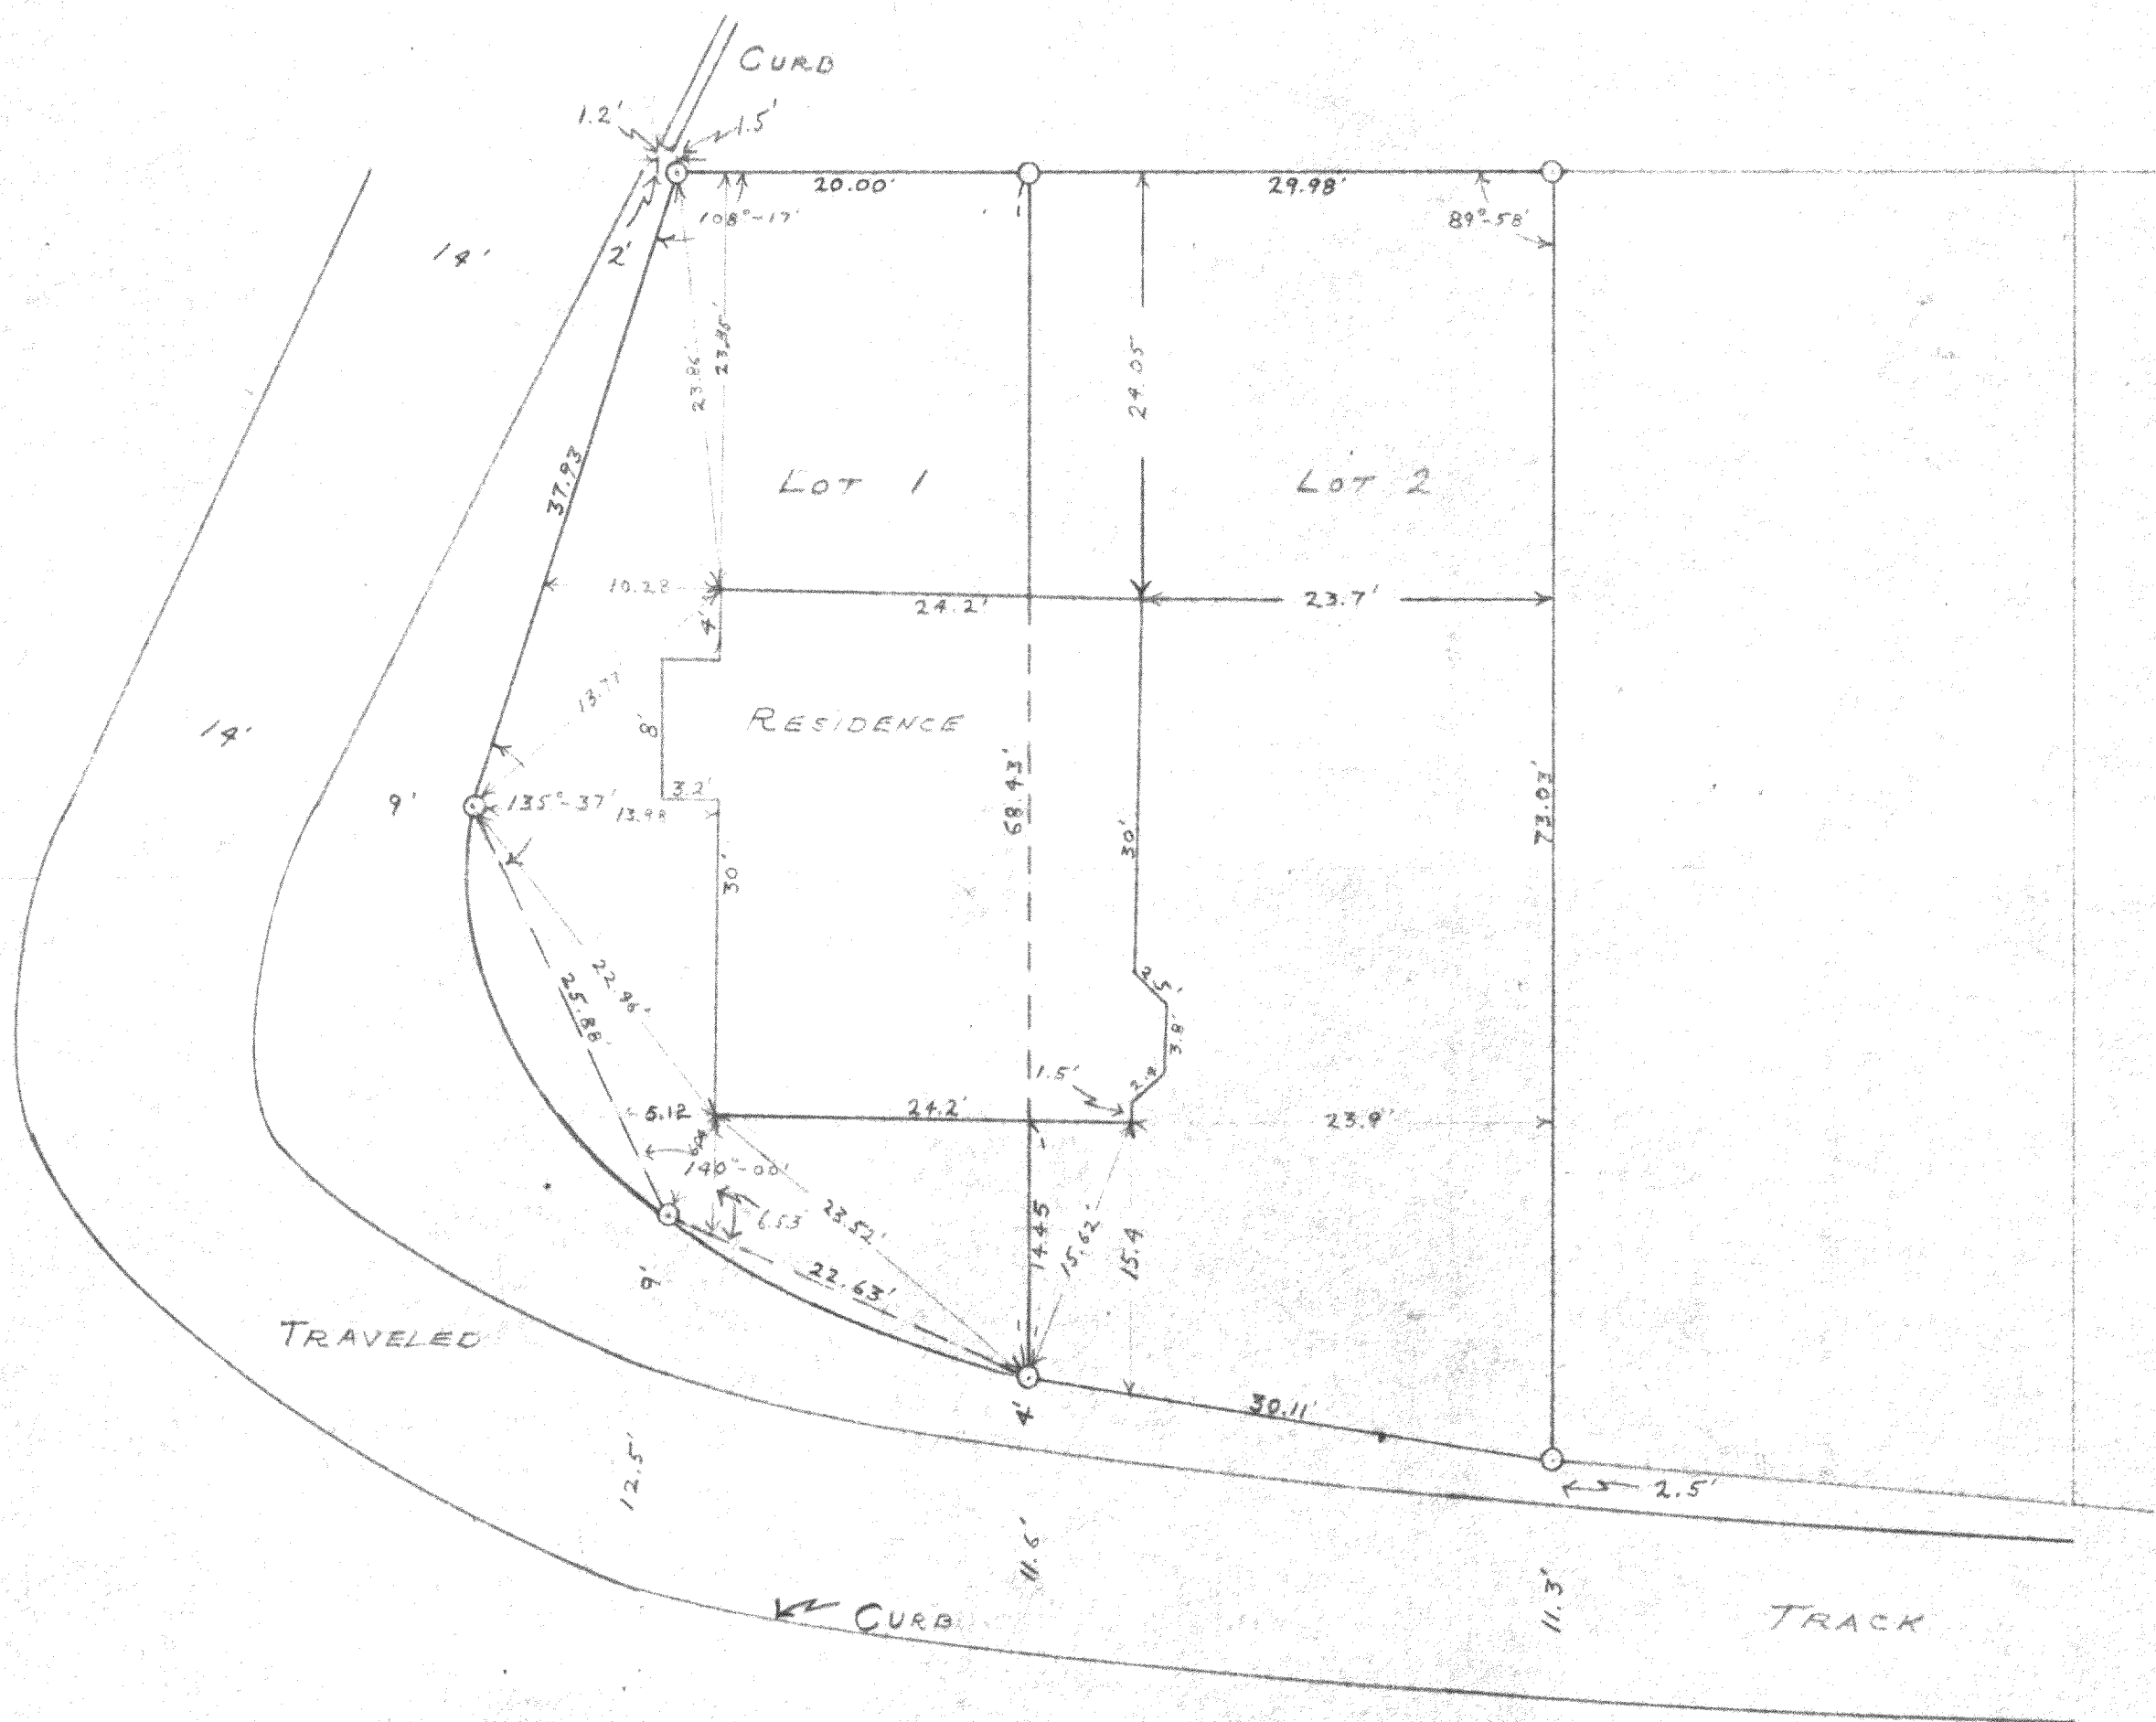

PLAT OF SURVEY OF LOTS 1 AND
2 BLOCK Y OF DELAVAN LAKE
ASSEMBLY GROUNDS, WALWORTH COUNTY,
WISCONSIN.
AUGUST 1, 1951

Lloyd L. Jensen
WALWORTH COUNTY SURVEYOR