



ABELL
SURVEYING & MAPPING
 DELAVAN, WISCONSIN 53115
 414-728-6737

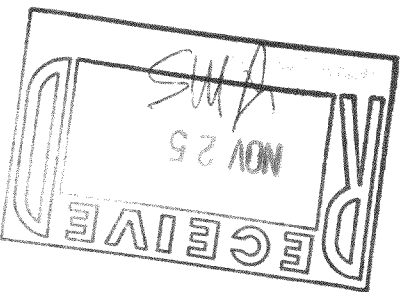

DRIVE
VALLEY

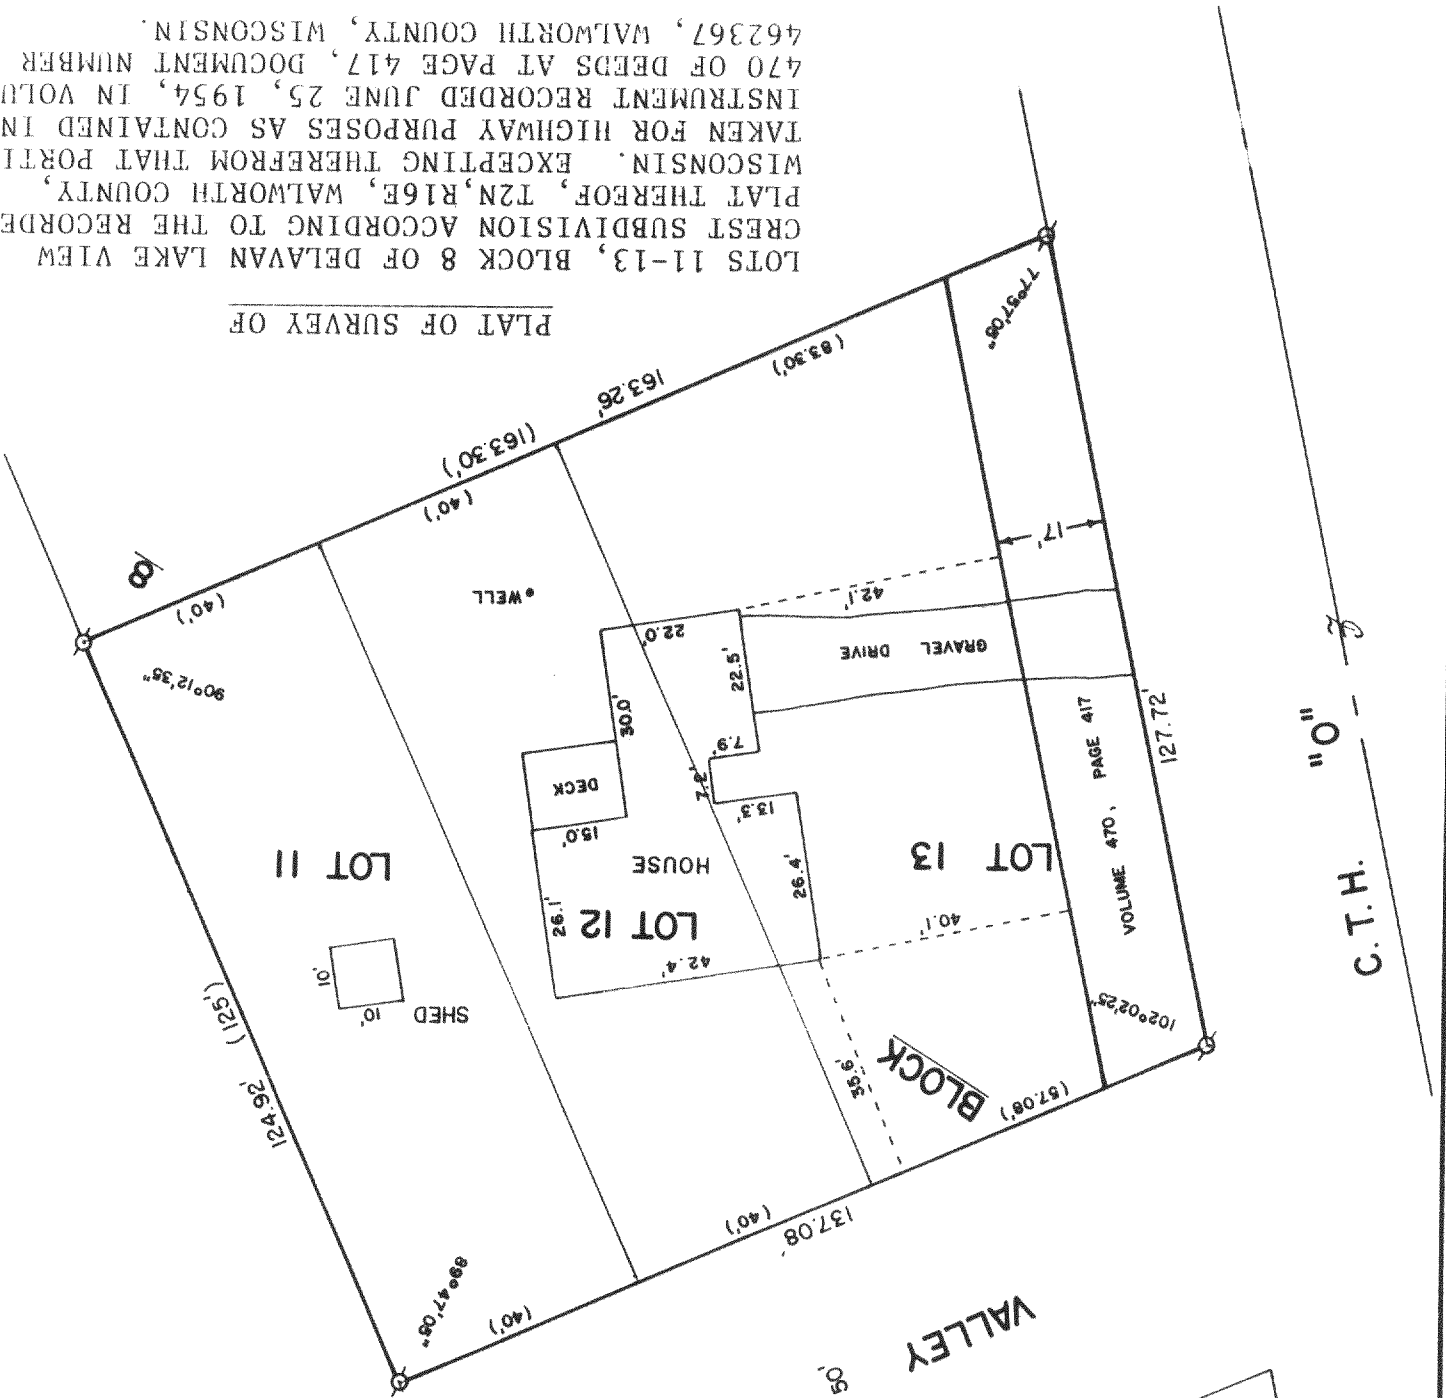

PLAT OF SURVEY OF

LOTS 11-13, BLOCK 8 OF DELAVAN LAKE VIEW
 GREAT SUBDIVISION ACCORDING TO THE RECORDED
 PLAT THEREOF, T2N, R16E, WALWORTH COUNTY,
 WISCONSIN. EXCEPTING THEREFROM THAT PORTION
 TAKEN FOR HIGHWAY PURPOSES AS CONTAINED IN
 INSTRUMENT RECORDED JUNE 25, 1954, IN VOLUME
 470 OF DEEDS AT PAGE 417, DOCUMENT NUMBER
 462367, WALWORTH COUNTY, WISCONSIN.

ORDERED BY: REALTY WORLD - CARMIN REALTORS
 811 E. GENEVA ST.
 DELAVAN, WI. 53115

I, DAVID F. ABELL, DO HEREBY CERTIFY
 THAT I HAVE SURVEYED THE PROPERTY
 HEREON DESCRIBED ACCORDING TO THE
 OFFICIAL RECORDS AND THAT THE PLAT
 HEREON IS A CORRECT REPRESENTATION
 OF THE PROPERTY LINES TO THE BEST OF
 MY KNOWLEDGE AND BELIEF.

Ø - IRON PIPE FOUND
 () - RECORDED AS

LEGEND

SCALE - 1"=30'



David F. Abell

DAVID F. ABELL

WISCONSIN REGISTERED LAND SURVEYOR, S-1596

DATE *October 15, 1987*

JOB NUMBER - 87159

NOTE: THIS IS NOT A CERTIFIED COPY UNLESS SEALED.

316-990