


DUNHAM SURVEYING, S.C.
SURVEYING & SUBDIVIDING
DELAVER, WISCONSIN 53115

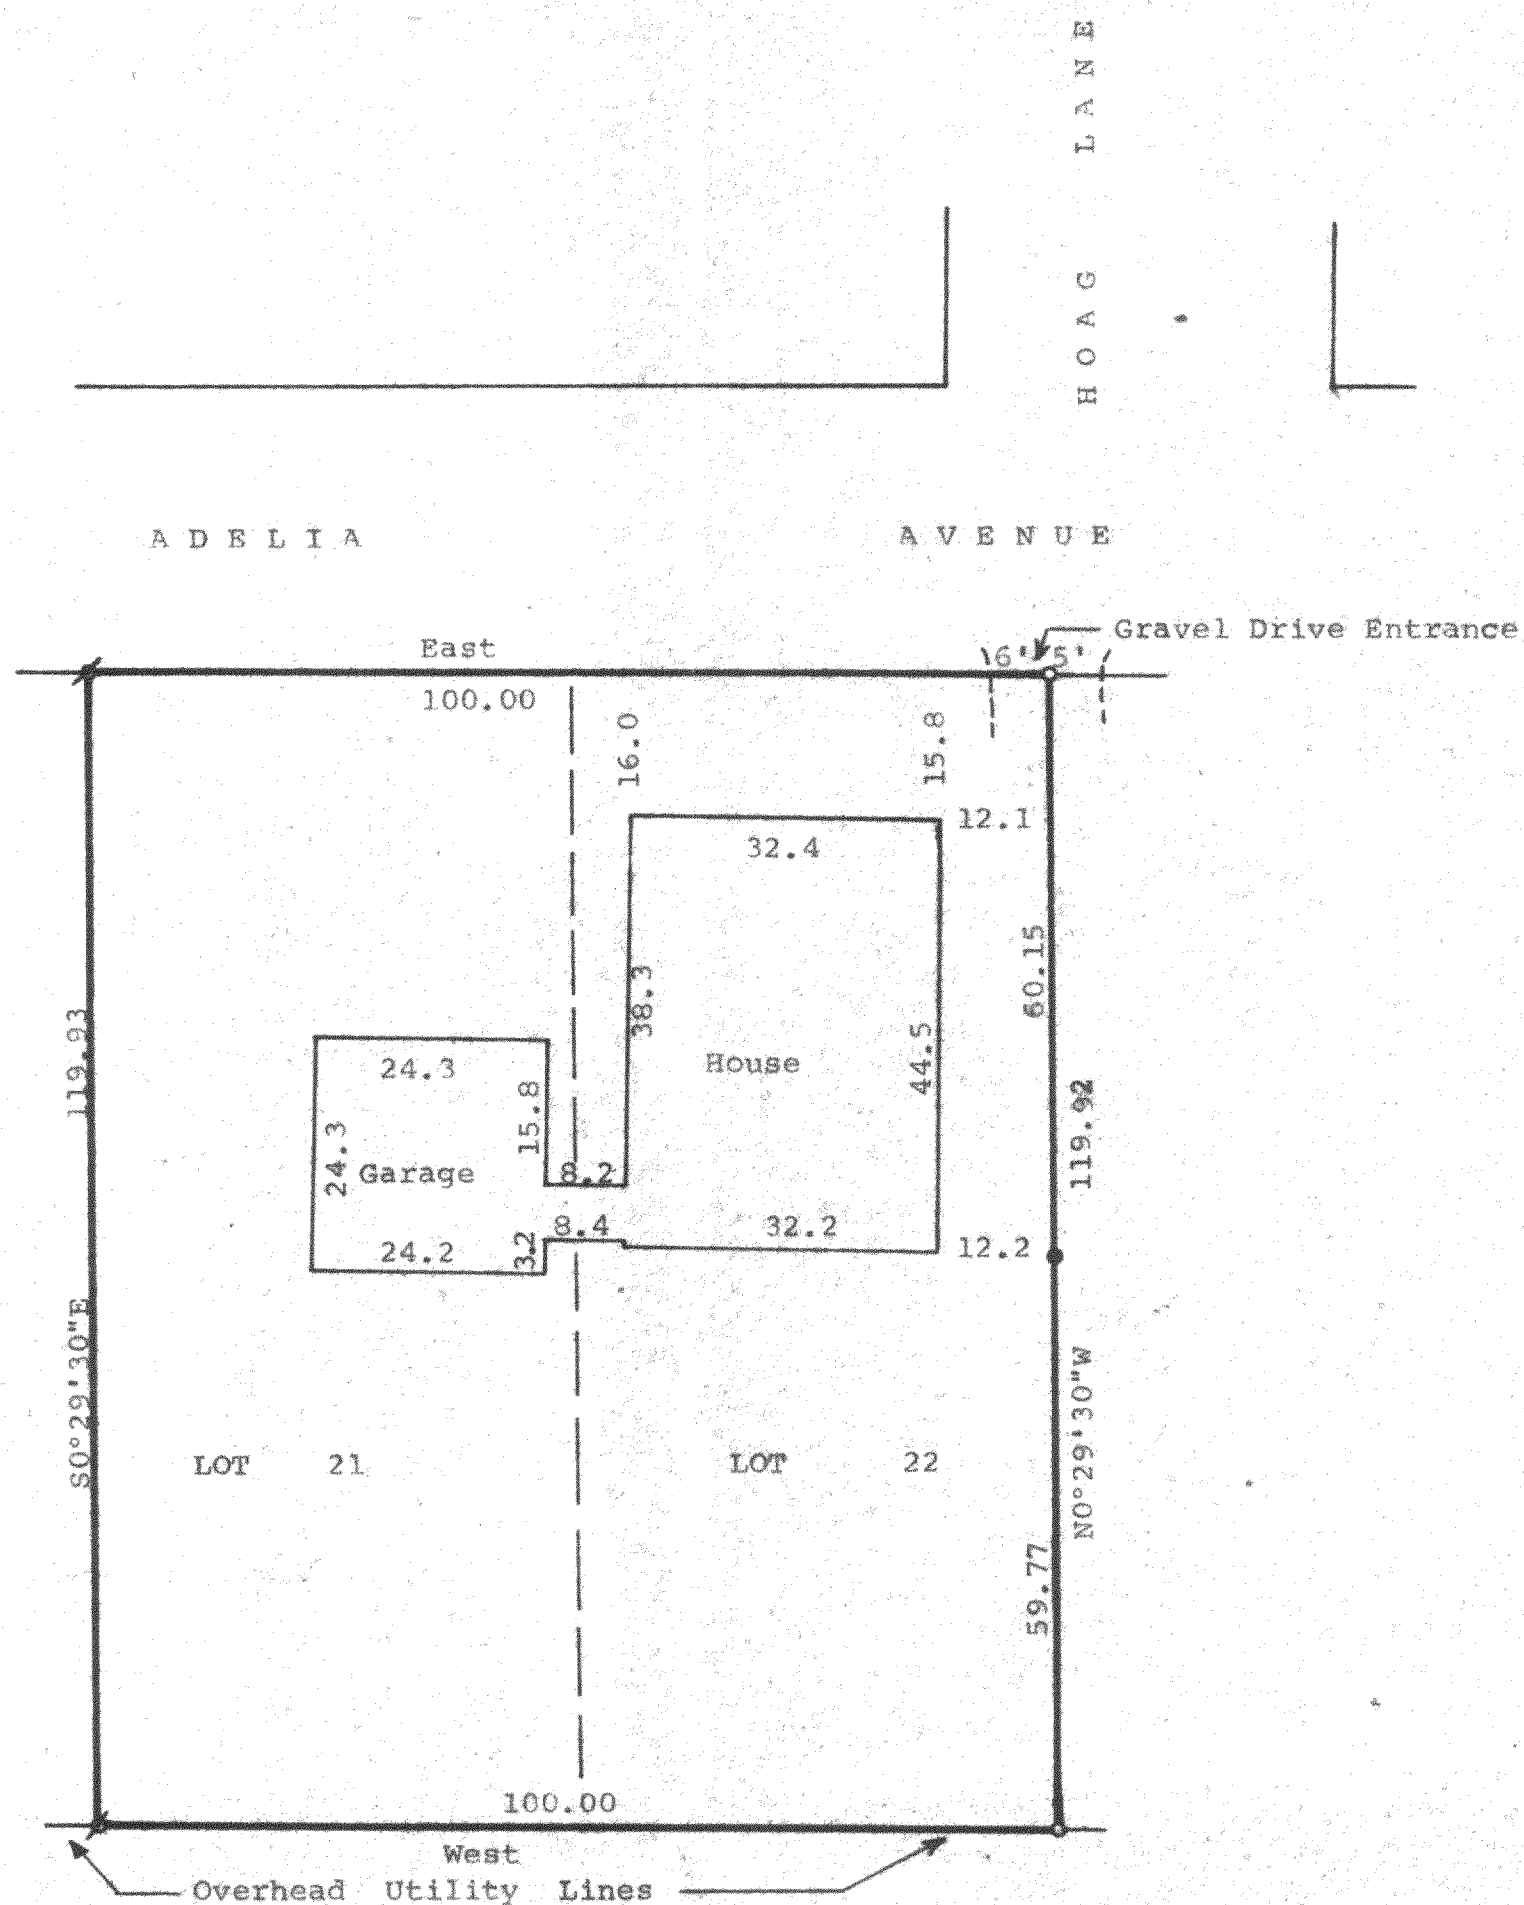

Scale - 1" = 20'
 ○ = 3/4" Dia. Iron Pipe Found
 ● = 3/4"x24" Iron Pipe Set
 ⦿ = Found Posey Pin and Set
 3/4"x24" Iron Pipe

Bearings are referenced to the
 South line of Adelia Avenue, assumed
 bearing of East.

Property Owners:
 Ronald A. & Audrey J. Stowers
 Rt. 4 Box 488
 Delavan, WI 53115

STATE OF WISCONSIN)
 COUNTY OF WALWORTH)SS

I, George T. Dunham, Surveyor, certify that I have surveyed the
 property described as follows,

Lots 21 and 22 of Hoag's Addition, a subdivision located in the
 Southeast 1/4 of Section 32, T2N, R16E, Walworth County, Wisconsin,
 and that the map shown hereon is a correct representation thereof and shows
 the size and location of the property, its exterior boundaries, the location
 of all visible structures and dimensions of all principal buildings thereon,
 boundary fences, apparent easements, roadways and visible encroachments, if any,
 and that I have surveyed the property hereon described according to the
 official records, to the best of my knowledge and belief.
 November 5, 1987.

George T. Dunham
 George T. Dunham, Surveyor

