


PLAT OF SURVEY
 UNIT 18-11
 GENEVA NATIONAL CONDOMINIUM
 NO. 18
 LOCATED IN TOWN 2 NORTH, RANGE 17 EAST
 WALWORTH COUNTY, WISCONSIN

BENCH MARK
 RIM SANITARY
 MANHOLE
 ELEV.=1023.32'

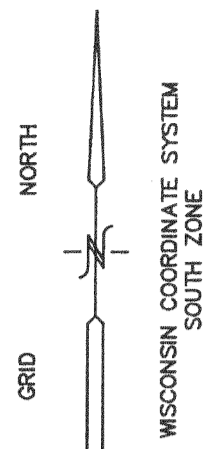

GENEVA CLUB COURT
 66' WIDE PRIVATE R.O.W.

UNIT 18-12

N 61°19'00" E
 C=46.14
 A=46.26
 R=184.00

N 57°16'30" E
 C=74.88
 A=82.09
 R=55.00

S 75°29'05" E
 178.91

UNIT 18-10

UNIT 18-11
 50,409 S.F.

GOLF CLUB
 GROUNDS

LEGEND
 ● = FOUND IRON REBAR STAKE
 (XXX) = RECORDED AS


NOTE: COPIES OF THIS MAP TO WHICH THE FOLLOWING CERTIFICATE WILL APPLY SHOW THE SURVEYOR'S ORIGINAL SEAL AND SIGNATURE IN RED INK. COPIES BY ANY OTHER MEANS MAY HAVE ALTERATIONS WHICH DO NOT REPRESENT THE SURVEYOR'S WORK PRODUCT.

I HEREBY CERTIFY THAT THE ABOVE DESCRIBED PROPERTY HAS BEEN SURVEYED UNDER MY DIRECTION AND THAT THE ABOVE MAP IS A TRUE REPRESENTATION THEREOF AND SHOWS THE SIZE AND LOCATION OF THE PROPERTY AND ITS EXTERIOR BOUNDARIES. THIS SURVEY IS MADE FOR THE USE OF THE PRESENT OWNERS OF THE PROPERTY, AND ALSO THOSE WHO PURCHASE, MORTGAGE, OR GUARANTEE THE TITLE THERETO WITHIN ONE YEAR FROM THE DATE HEREOF.

DATED: AUGUST 19, 2003

REVISED 02-27-2004
 TO SHOW SIZE & LOCATION OF
 FOUNDATION AS BUILT

Peter S. Gordon
 PETER S. GORDON R.L.S. 2101

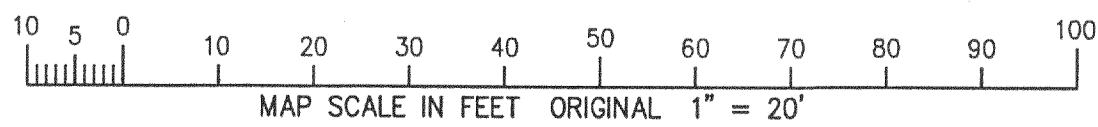

UNIT 18-08

RECEIVED
 APR 5 2004
 kw

WORK ORDERED BY
 LOWELL MANAGEMENT
 PO BOX 926
 LAKE GENEVA, WI 53147

FARRIS, HANSEN & ASSOCIATES, INC.
 Engineering, Architecture, Surveying
 7 Ridgeway Court P.O. Box 437
 ELKHORN, WISCONSIN 53121
 Office: (262) 723-2098
 Fax: (262) 723-5886

REVISIONS

PROJECT NO.
 3269.18.11
 DATE:
 08/05/03
 SHEET NO.
 1 OF 1

JGN18-11

217-2795

FEB 27 2004