


GEORGE T. DUNHAM
SURVEYING & SUBDIVIDING
DELAVAN, WISCONSIN

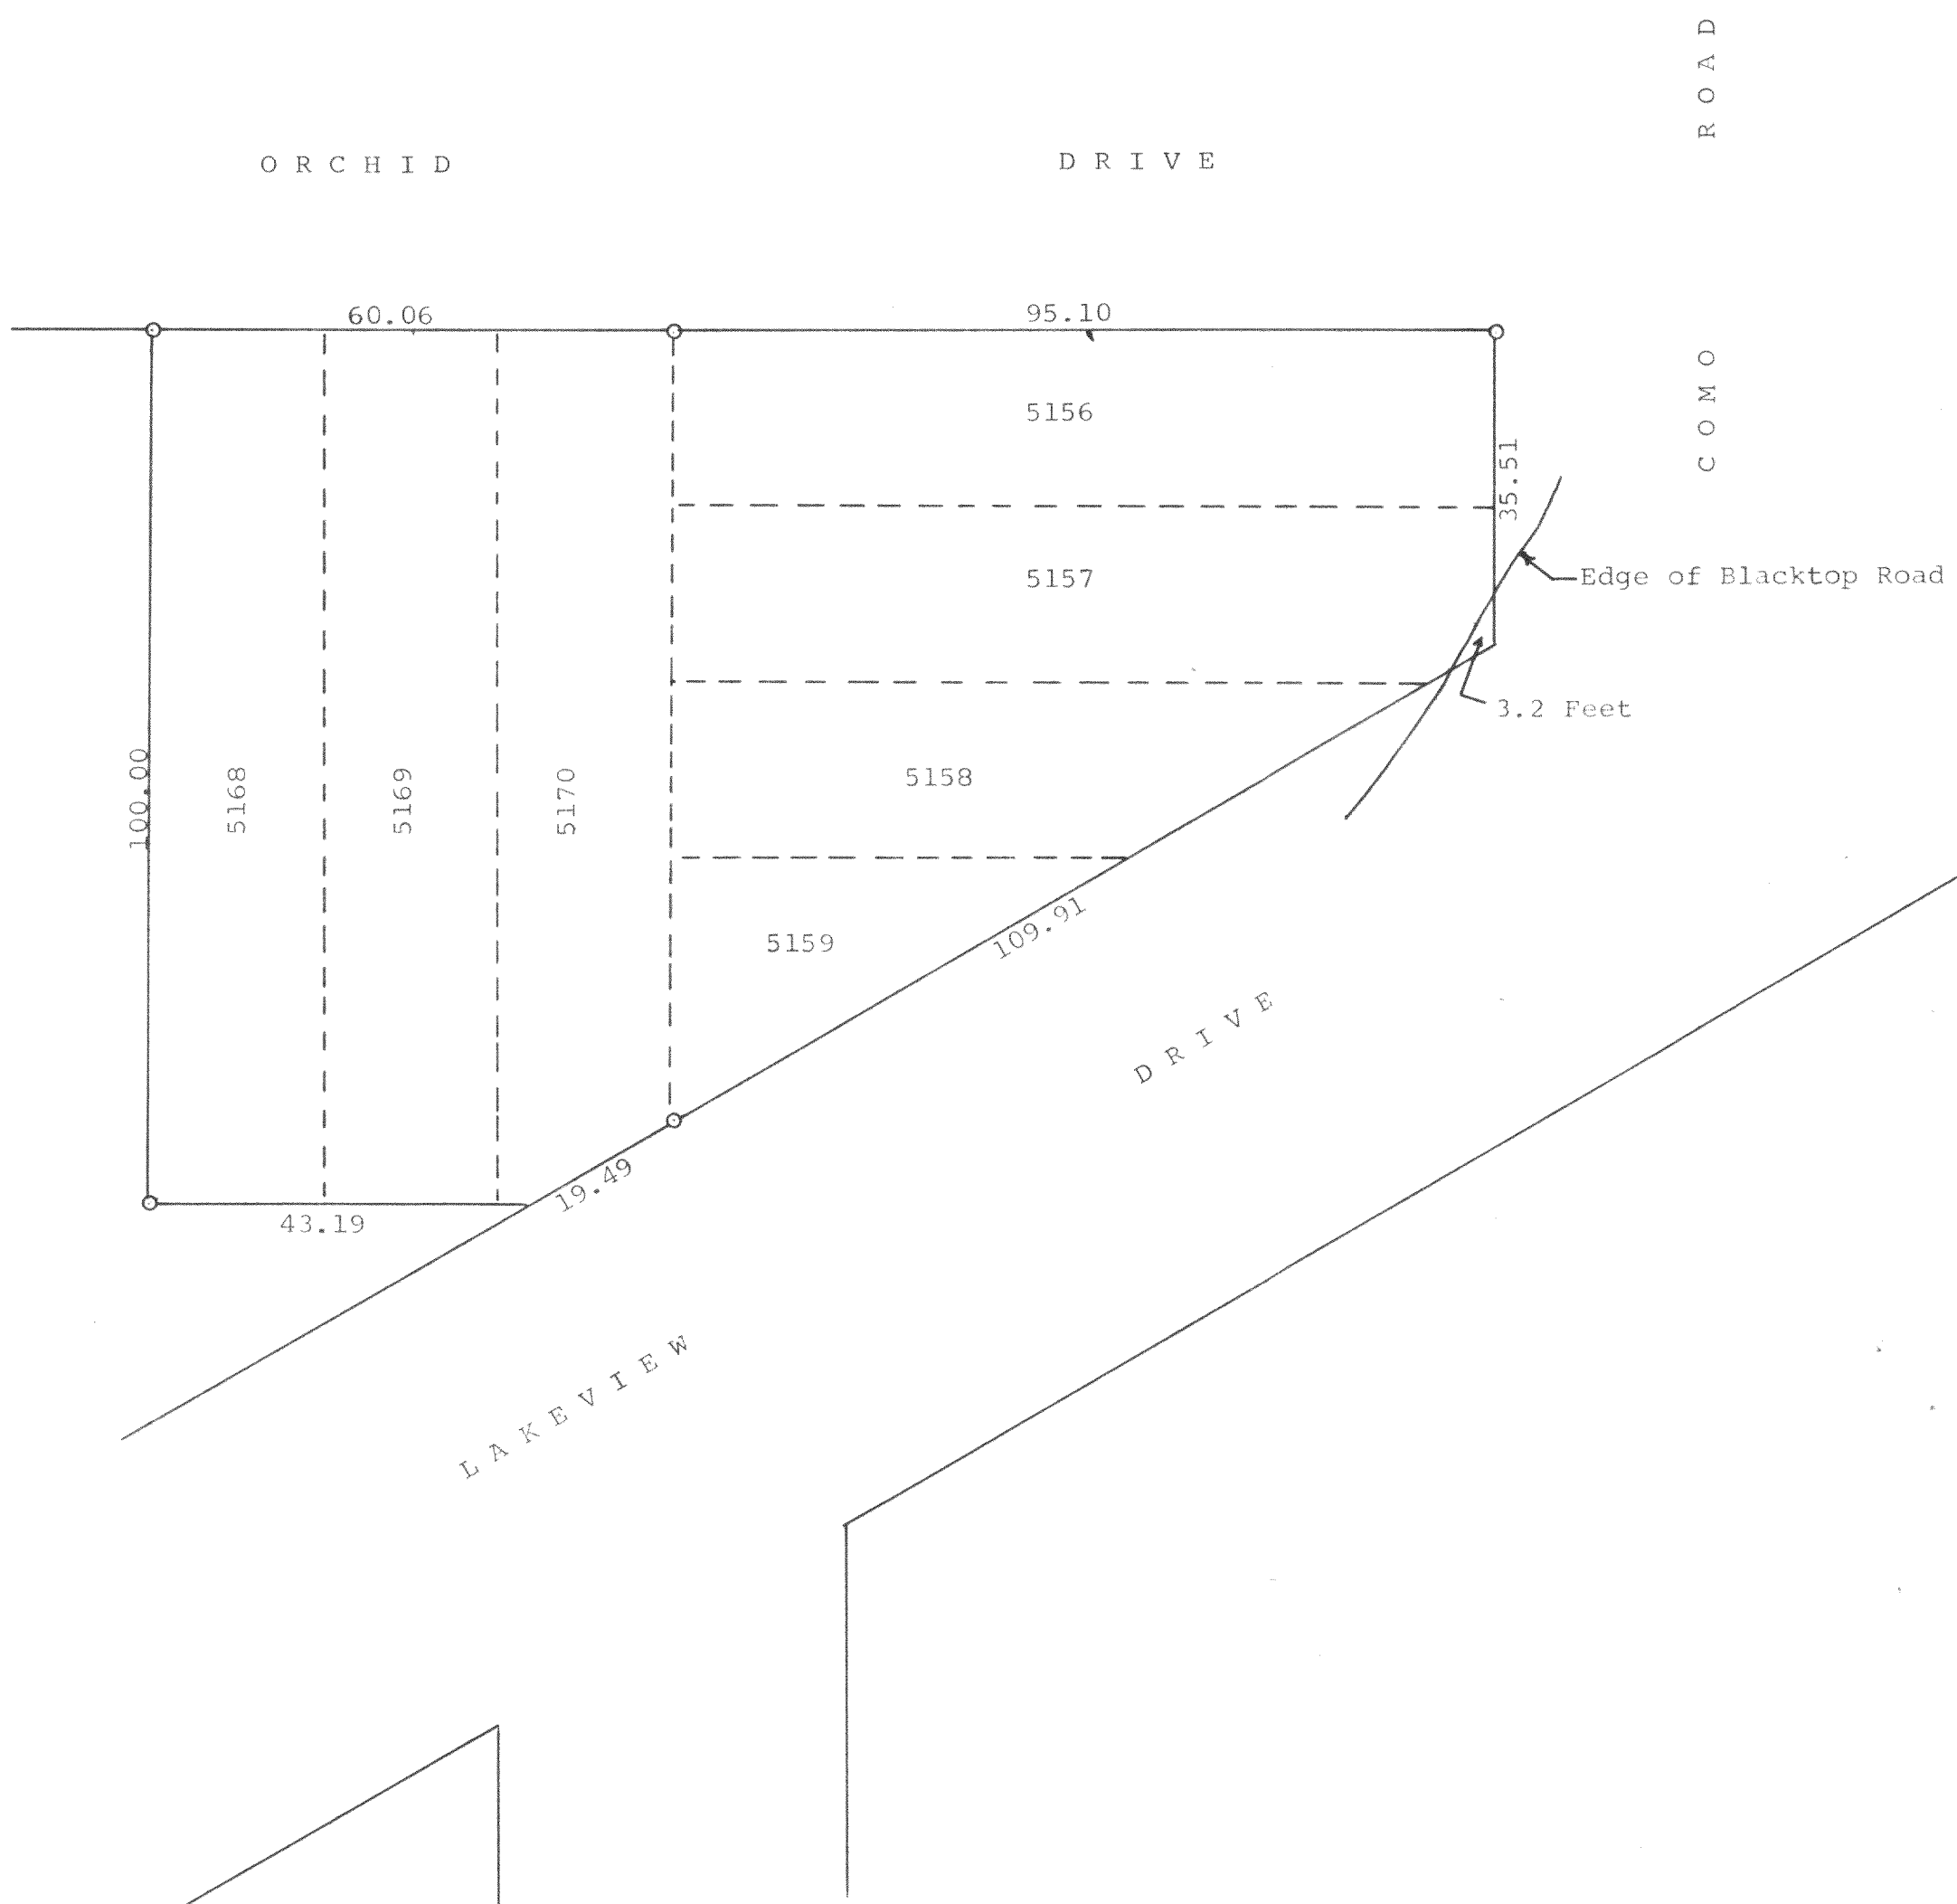

Scale - 1" = 20'
○ = Iron Pipe

Plat of survey of Lots 5156-5159 Inclusive and Lots
5168-5170 Inclusive, Lake Como Beach Subdivision,
Town of Geneva, Walworth County, Wisconsin as
surveyed in September 1962
October 20, 1967
George T. Dunham
George T. Dunham, Surveyor