



GEORGE T. DUNHAM
SURVEYING & SUBDIVIDING
DELAVER, WISCONSIN

N

Scale - 1" = 10'
○ = Iron Pipe

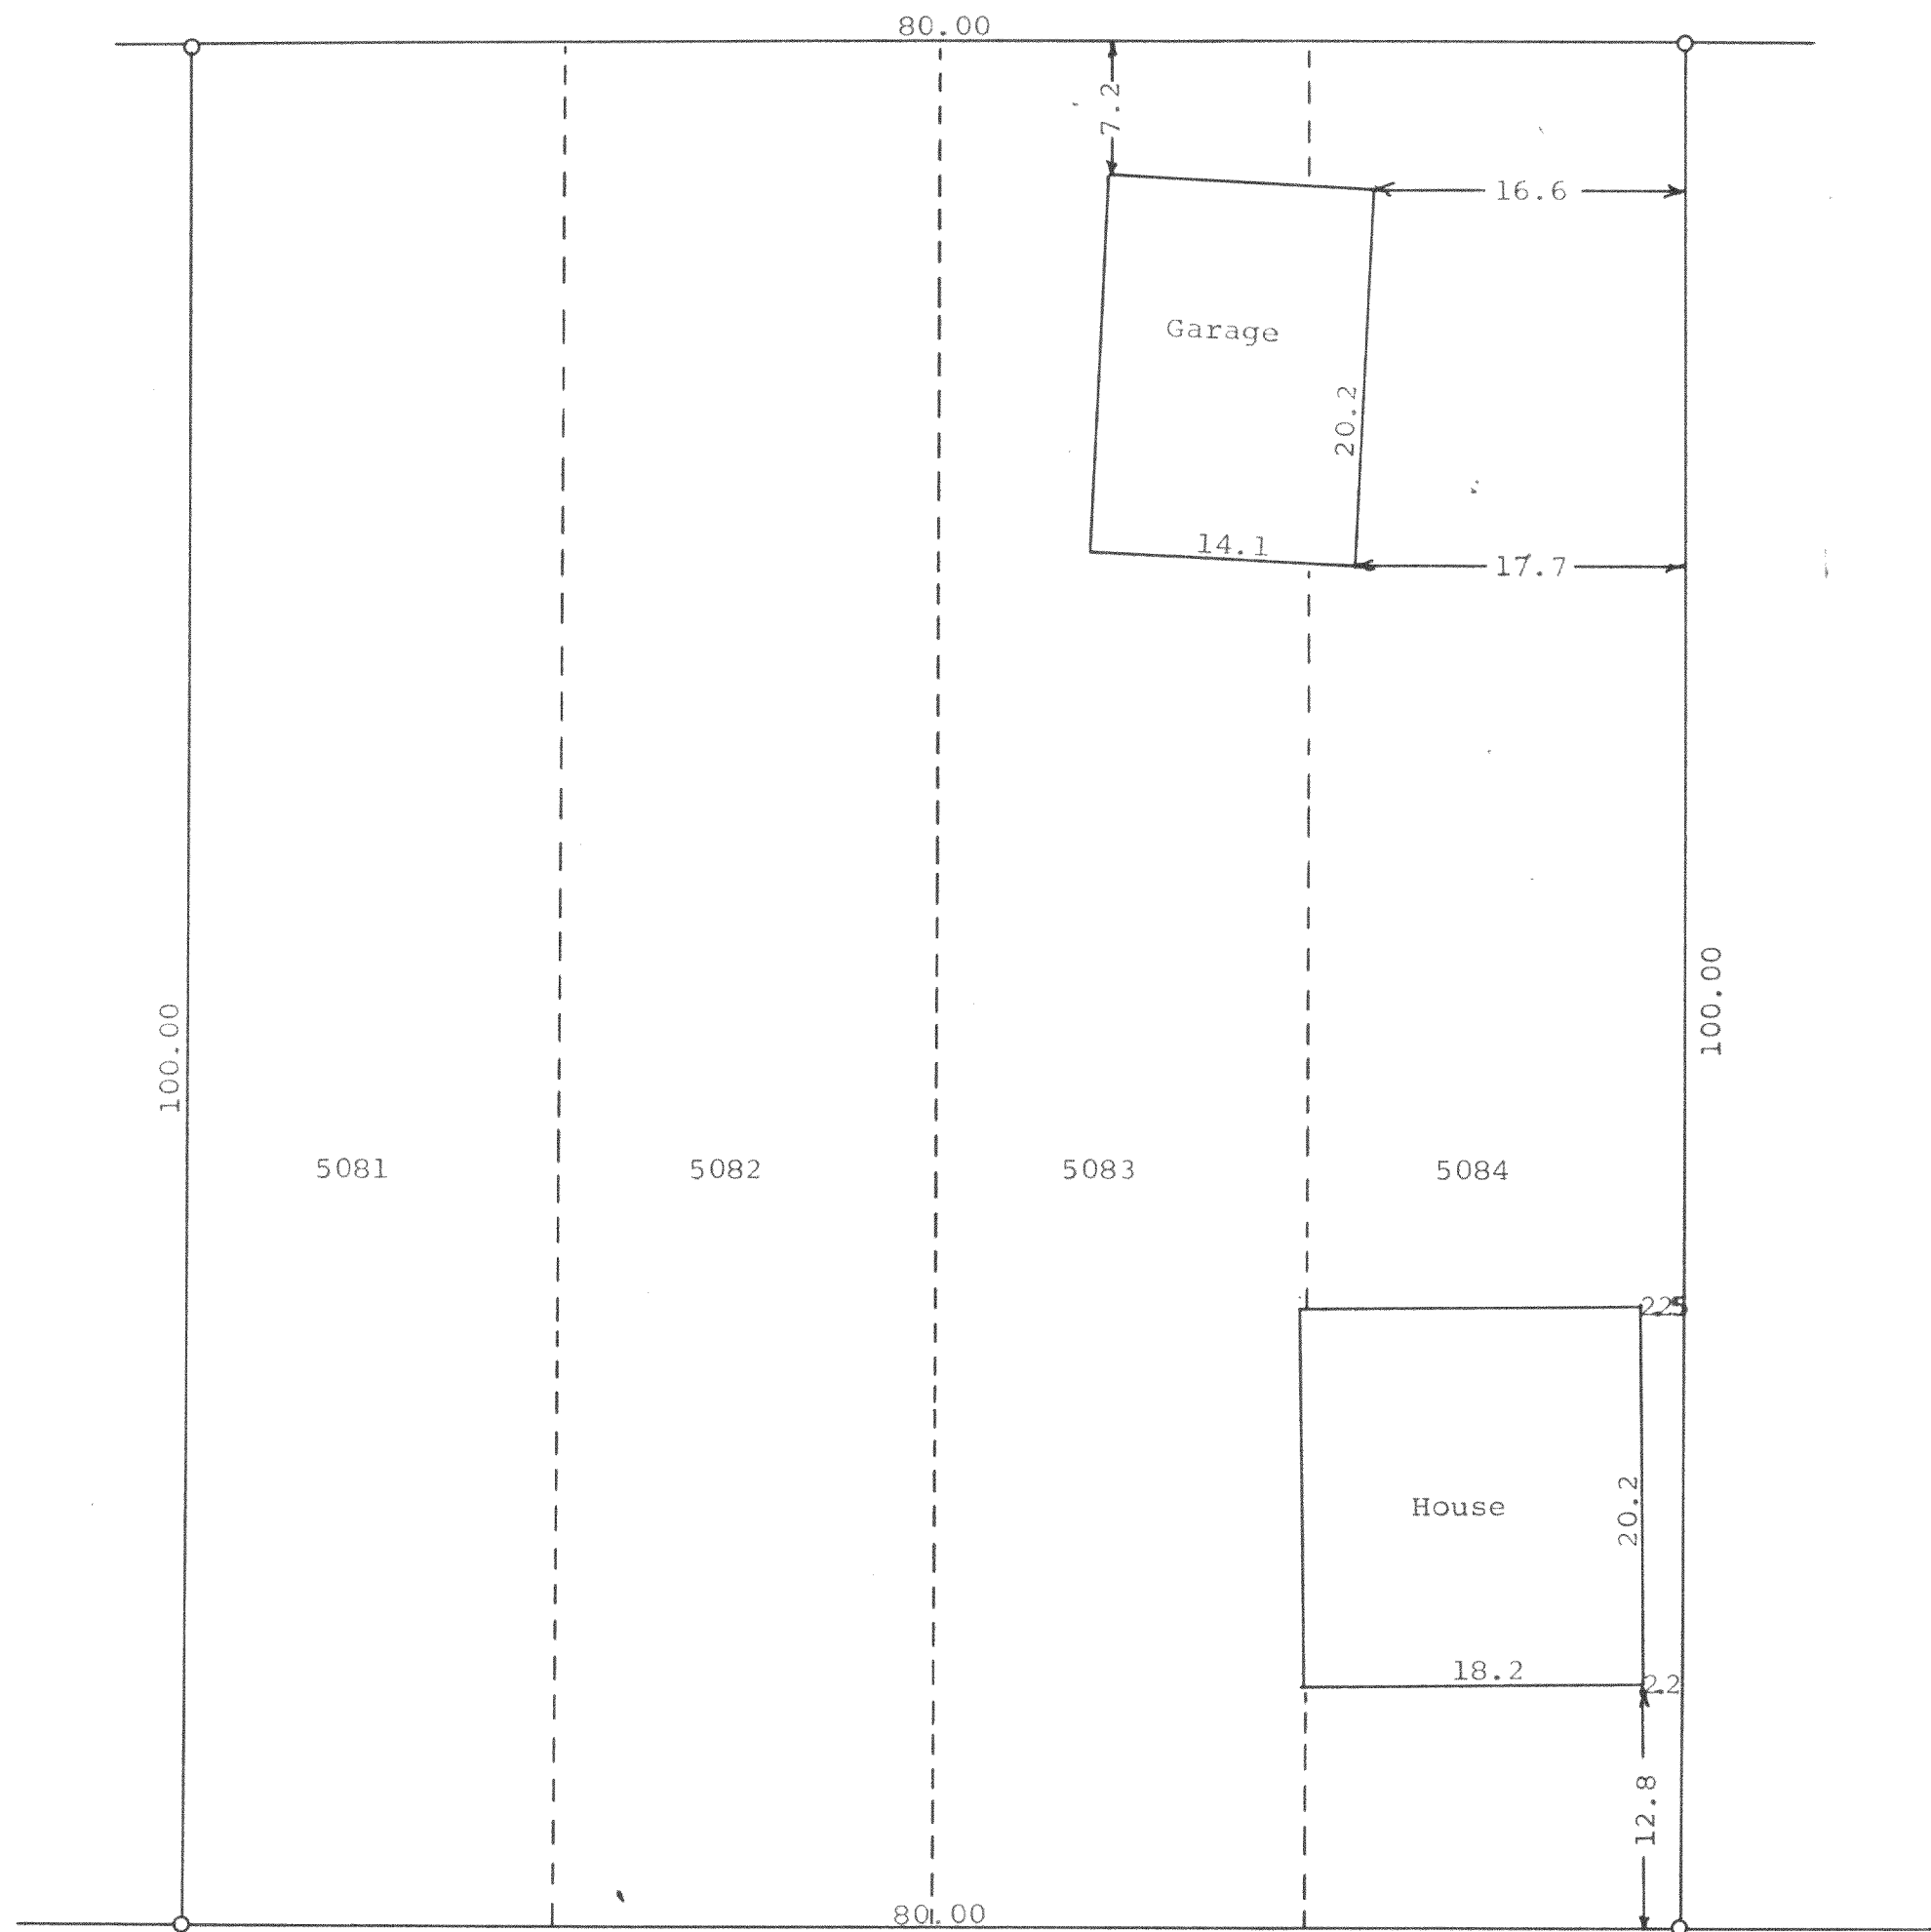

ORCHID

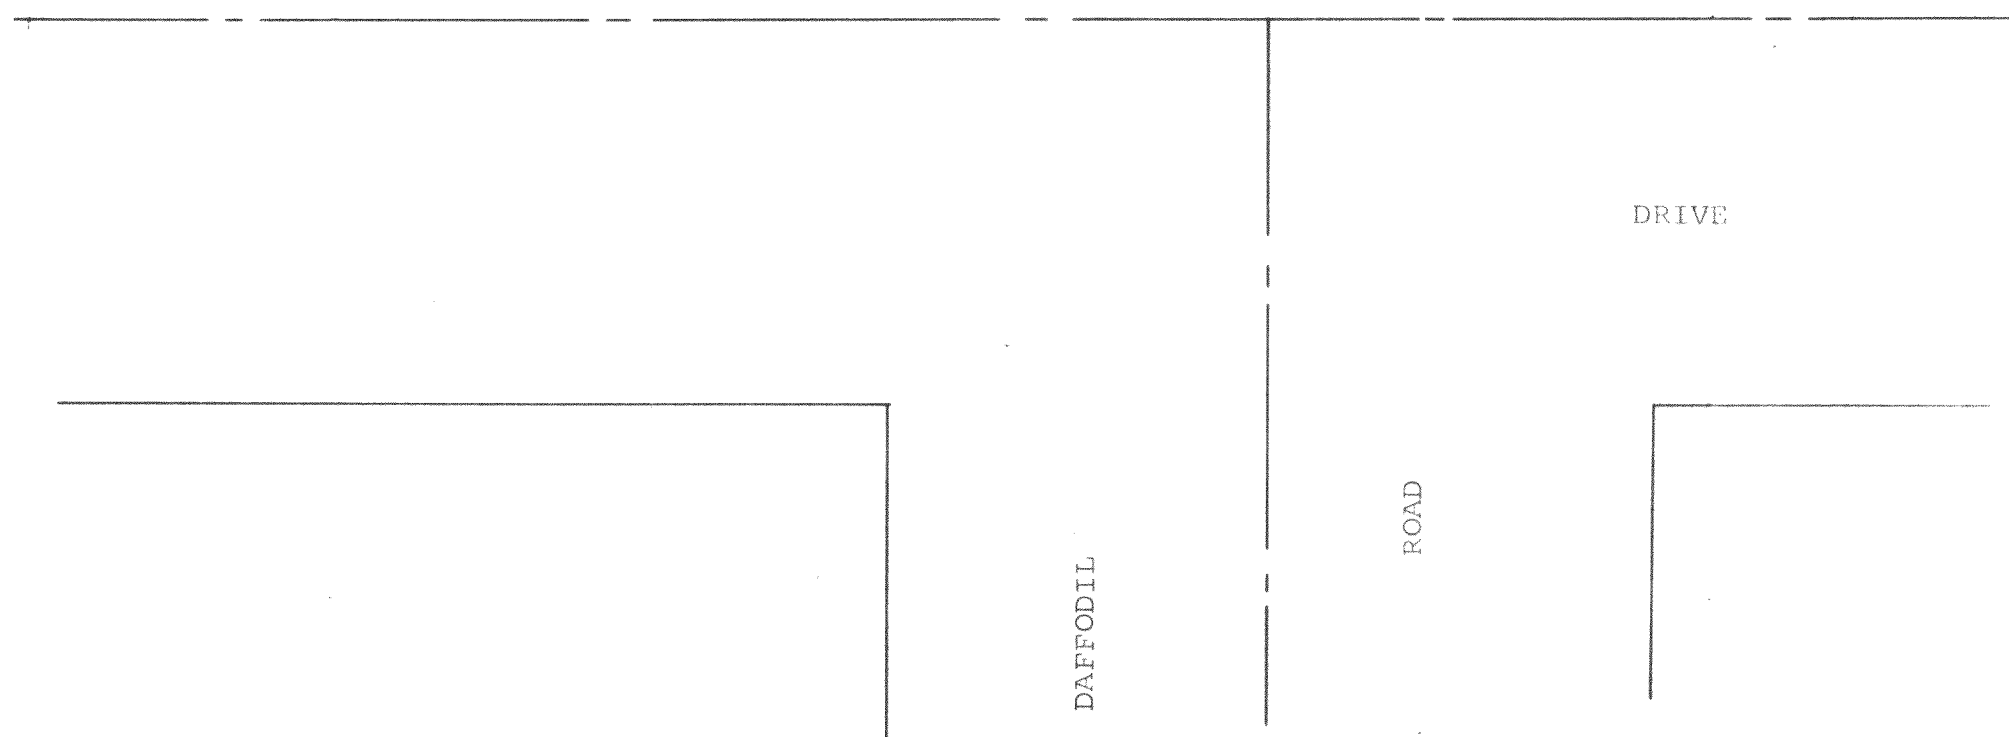

STATE OF WISCONSIN)
WALWORTH COUNTY) SS

I, George T. Dunham, Surveyor, certify that I have surveyed the property described as follows,

Lots 5081 to 5084 Inclusive in Lake Como Beach Subdivision, Section 28, T 2 N, R 17 E, Walworth County, Wisconsin. and that the above plat is an accurate survey and a true representation thereof and correctly shows the exterior boundary lines and location of the buildings on said property and the correct measurements thereof. September 18, 1967

George T. Dunham
George T. Dunham, Surveyor