


KOLB LAND CONSULTING, INC.
LAND SURVEYING • SUBDIVIDING • LAND PLANNING

929 WILLIAMS STREET

LAKE GENEVA, WISCONSIN 53147



414-248-3697

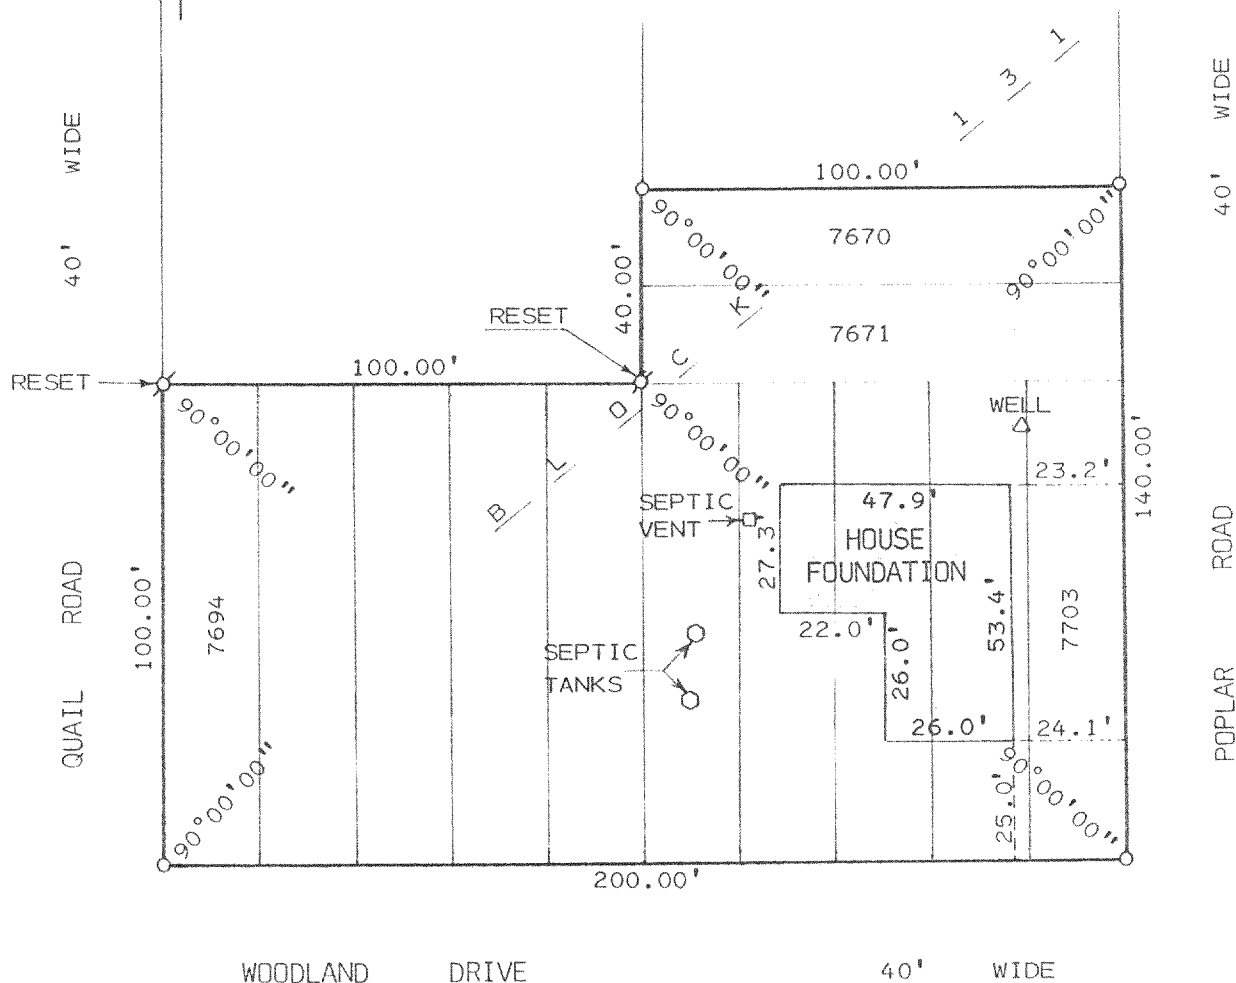

PLAT OF SURVEY OF

LOTS 7670 AND 7671 AND LOTS 7694 THRU 7703, BLOCK 131,
LAKE COMO BEACH SUBDIVISION, T 2 N, R 17 E, TOWN OF
GENEVA, WALWORTH COUNTY, WISCONSIN.

OWNER: VITO D'AMBROSIO
ORDERED BY: FIVE STAR HOMES
90 EAST GENEVA SQUARE
LAKE GENEVA, WI 53147

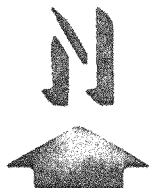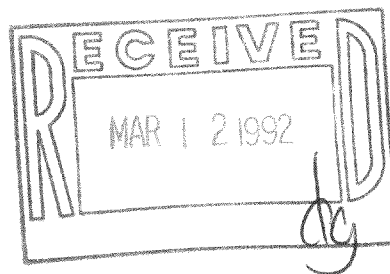

SCALE : 1" = 40'

LEGEND

- o - IRON PIPE SET
- ⊘ - IRON PIPE FOUND

I, HAROLD H. KOLB, DO HEREBY CERTIFY THAT I
HAVE SURVEYED THE PROPERTY HEREON DESCRIBED
ACCORDING TO THE OFFICIAL RECORDS, AND THAT
THE PLAT HEREON IS A CORRECT REPRESENTATION
OF THE LOT LINES TO THE BEST OF MY KNOWLEDGE
AND BELIEF. THIS SURVEY IS NOT VALID UNLESS
THE SURVEYOR'S SIGNATURE IS IN RED.

HAROLD H. KOLB

WISCONSIN REGISTERED LAND SURVEYOR, S-187

DATE NOVEMBER 13, 1990

REVISED

REVISED

217-1051

JLCB-1634