


LOTS 8802 & 8803 BLOCK 153 AND
LOTS 8820 & 8821 BLOCK 154
OF LAKE COMO BEACH SUBDIVISION
SEC. 21 T2N R17E WAL. CO. WIS.

Lloyd L. Jensen
LLOYD L. JENSEN
COUNTY SURVEYOR

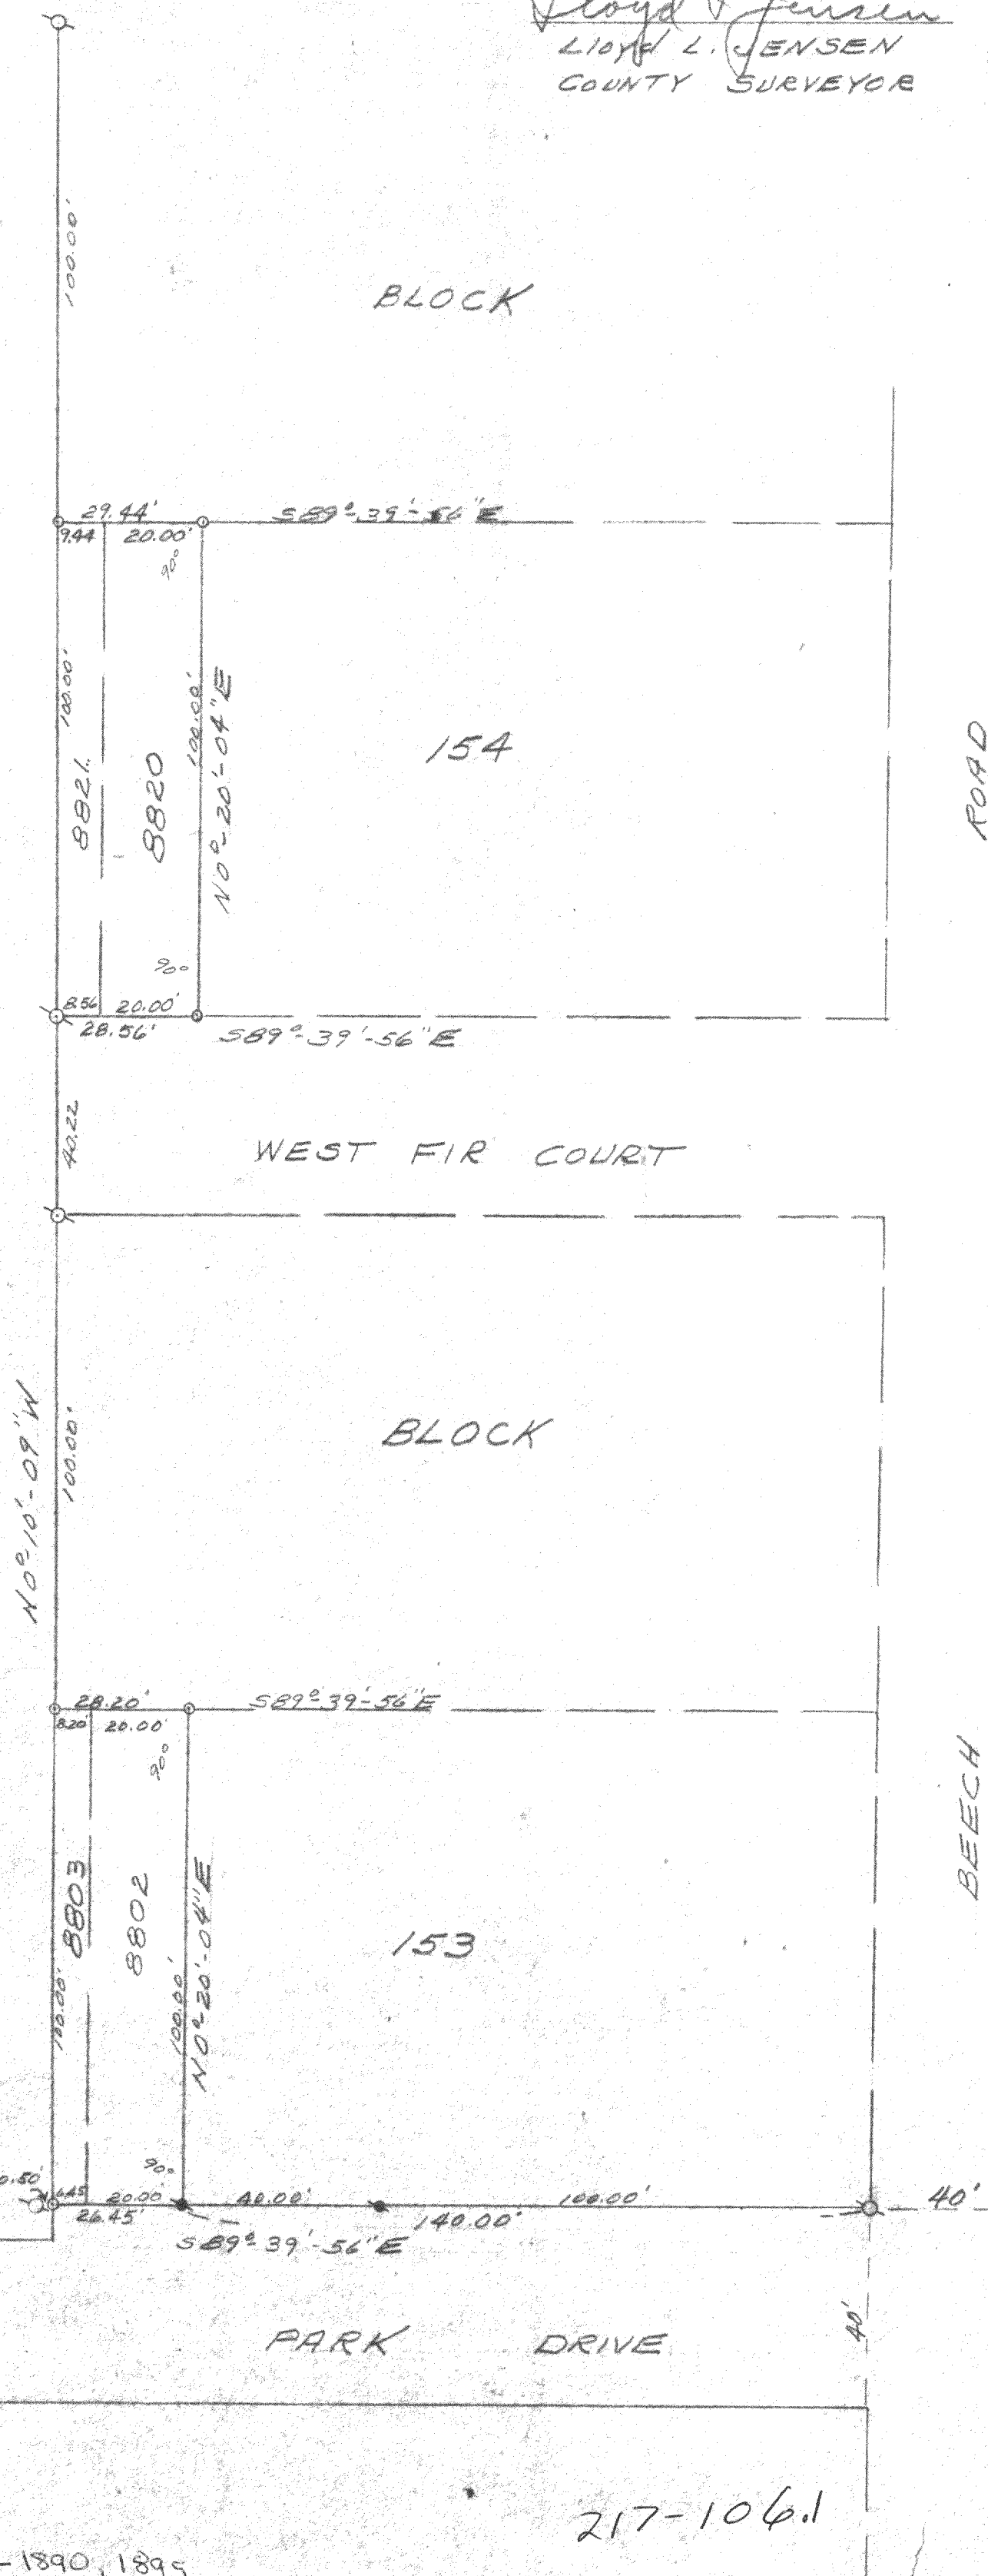

- Q - IRON PIPE SET
- Q - IRON ROD FOUND
- Q - IRON PIPE FOUND

217-106.1

JLLB-1890, 1895