

FARRIS, HANSEN & ASSOCIATES, INC.

7 RIDGEWAY COURT, P.O. BOX 437
ELKHORN, WISCONSIN 53121

PHONE: (414) 723-2098
FAX: (414) 723-5886

LOCATION: LOTS 5456, 5457, 5458 BLOCK 98
OF LAKE COMO BEACH
A SUBDIVISION LOCATED
IN TOWN 2 NORTH, RANGE 17 EAST
WALWORTH COUNTY, WISCONSIN

WORK ORDERED BY: LEONARD MONDELLI
3530 RUBY ST.
FRANKLIN PARK, IL. 60131


MAP LEGEND

- O = IRON PIPE STAKE FOUND
- IRON PIPE STAKE SET
- = IRON ROD STAKE FOUND
- = IRON ROD STAKE SET
- CONCRETE MONUMENT FOUND
- RECORD DIMENSION
- WOOD FENCE
- ▽ = COMPUTED PROPERTY CORNER
- ⊙ = COPPER TUBING IN CONCRETE MONUMENT FOUND

(XXXXX)

▽ = COMPUTED PROPERTY CORNER

⊙ = COPPER TUBING IN CONCRETE MONUMENT FOUND

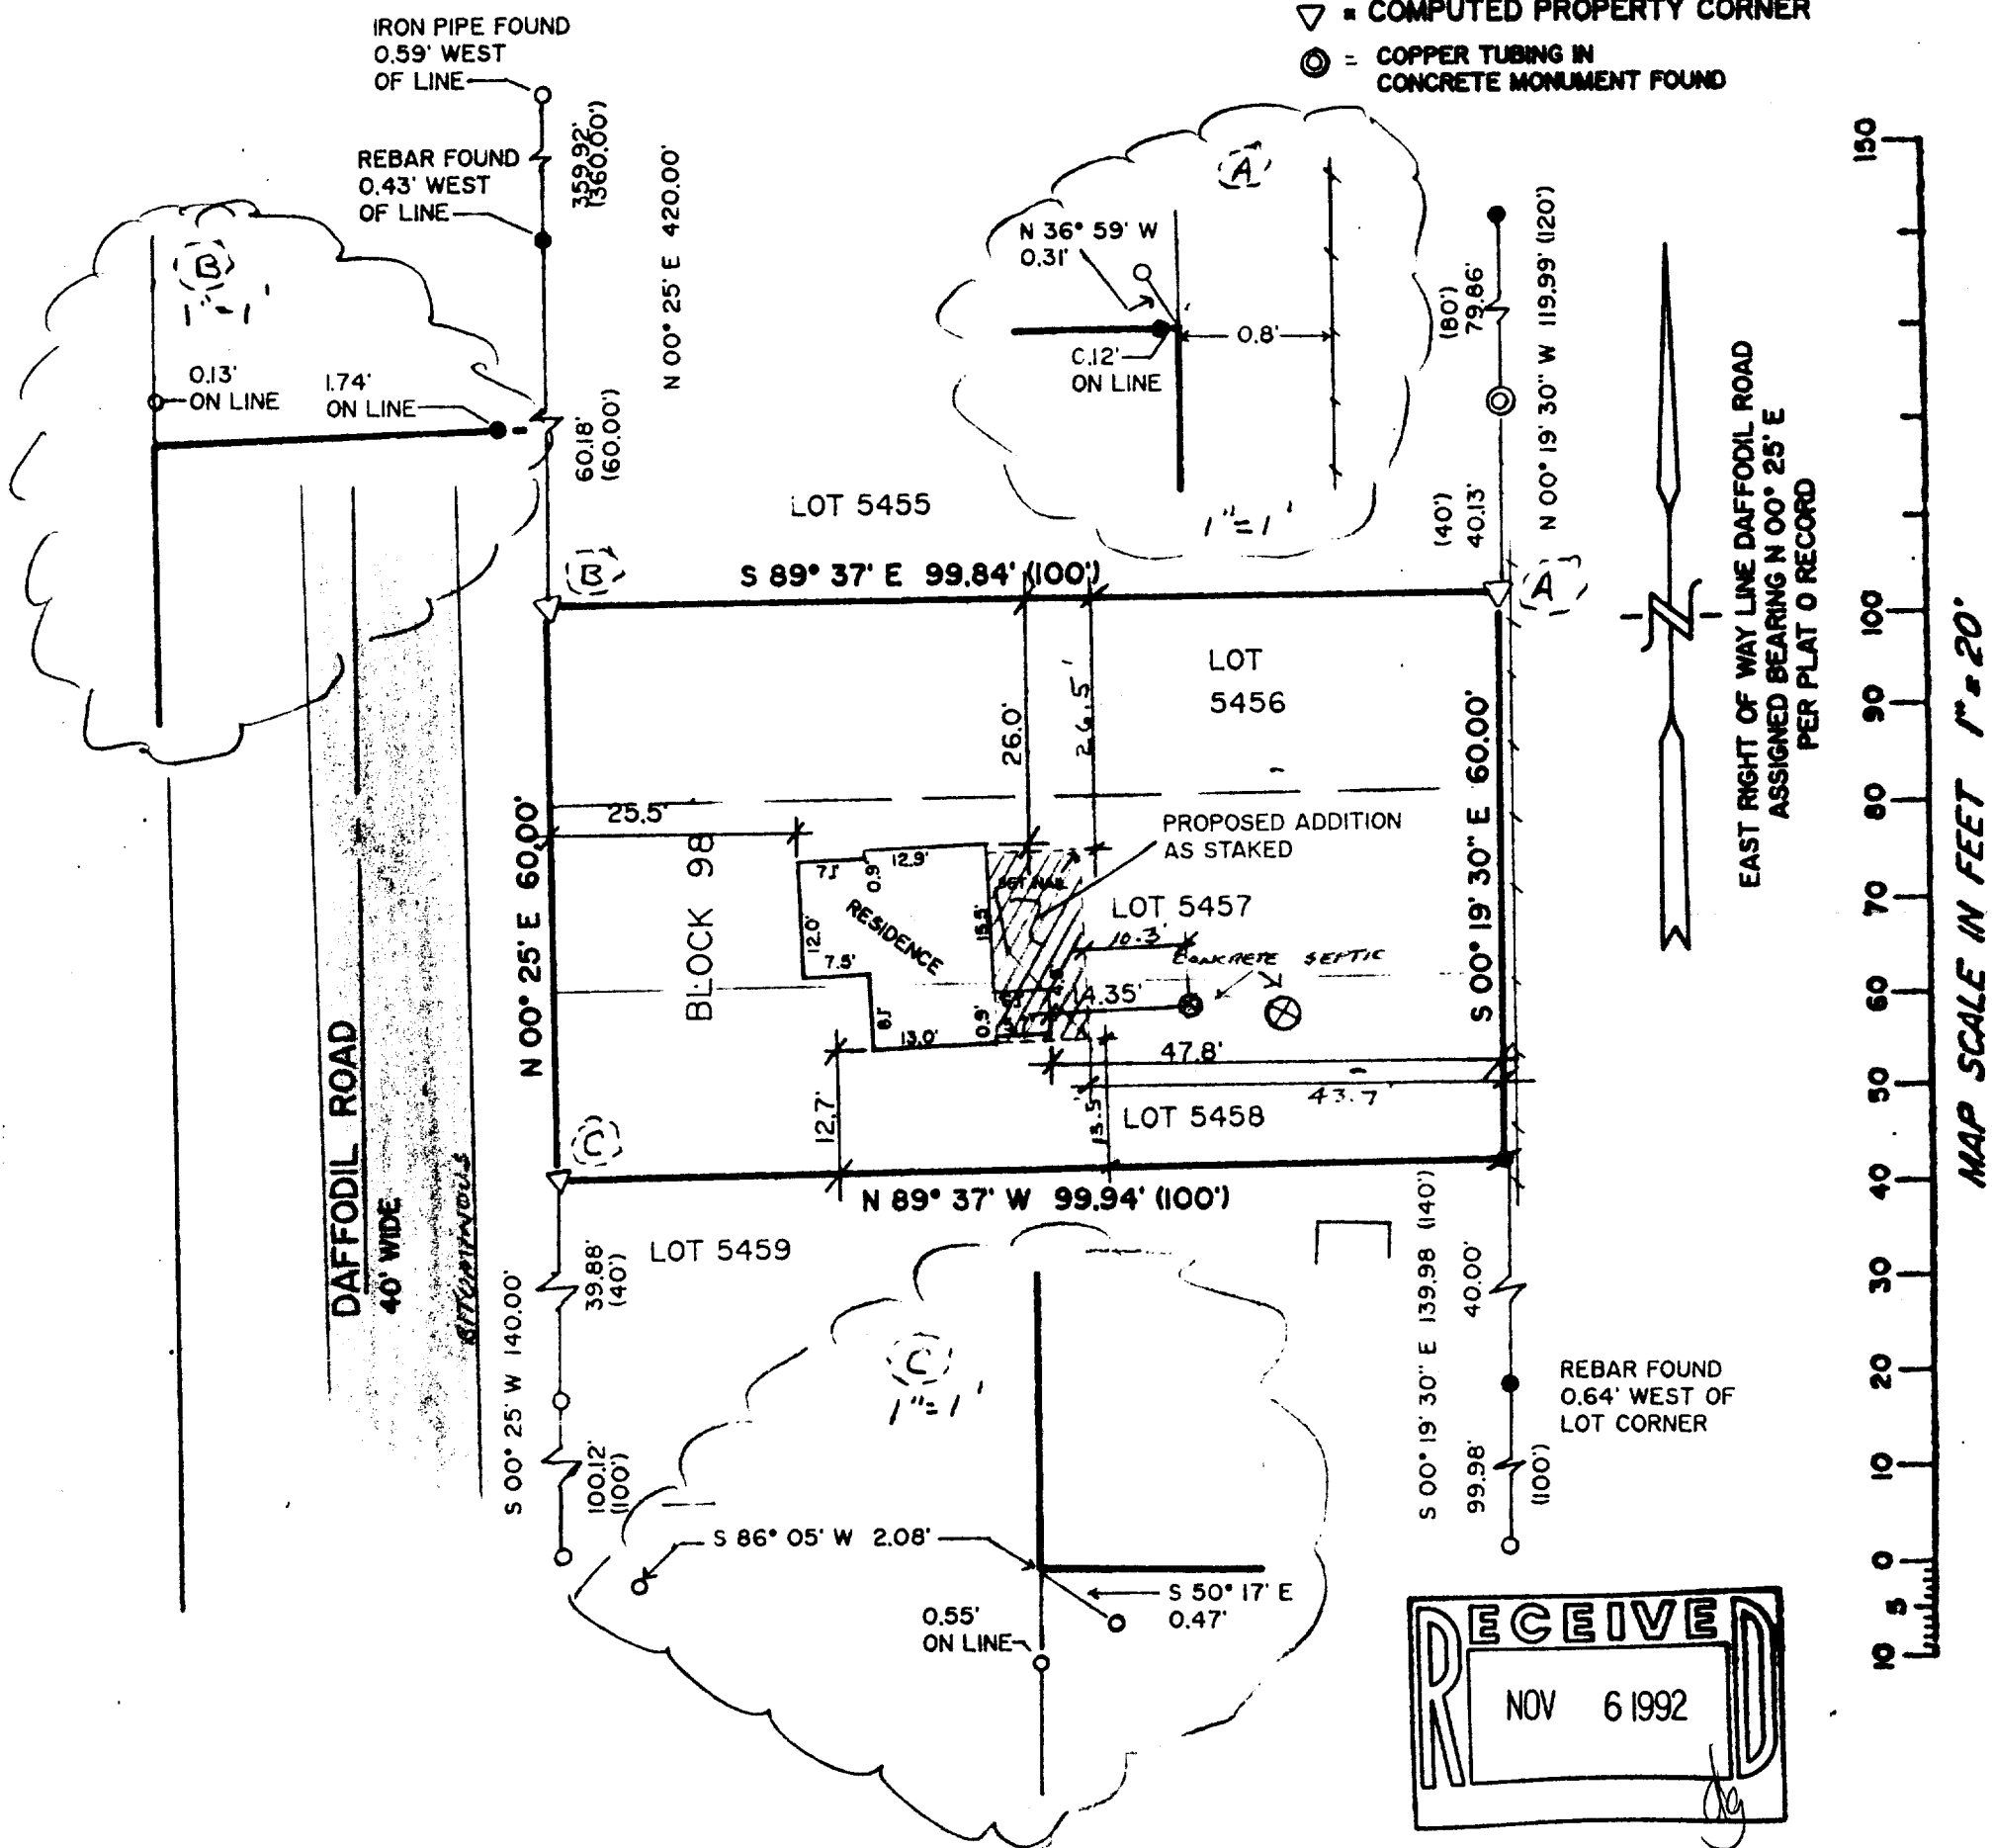


NOTE: COPIES OF THIS MAP TO WHICH THE FOLLOWING CERTIFICATE WILL APPLY ARE BLUE LINE PRINTS SHOWING SURVEYOR'S ORIGINAL SEAL AND SIGNATURE IN BLACK INK. COPIES BY ANY OTHER MEANS MAY HAVE ALTERATIONS WHICH DO NOT REPRESENT THE SURVEYOR'S WORK PRODUCT.

I HEREBY CERTIFY THAT THIS PLAT OF SURVEY IS A TRUE AND ACCURATE REPRESENTATION OF THE BOUNDARY LINES OF THE SUBJECT PARCEL AND SHOWS THE SIZE AND LOCATION OF ALL BUILDINGS ON THE PARCEL SHOWN HEREON, TO THE BEST OF MY PROFESSIONAL KNOWLEDGE AND BELIEF. THIS SURVEY IS MADE FOR THE USE OF THE PRESENT OWNERS OF THE PROPERTY, AND ALSO THOSE WHO PURCHASE, MORTGAGE, OR GUARANTEE THE TITLE THERETO WITHIN ONE YEAR FROM THE DATE HEREOF.

DATED: JULY 27, 1992

PETER S. GORDON RLS 2101

PROJECT NO. 3687

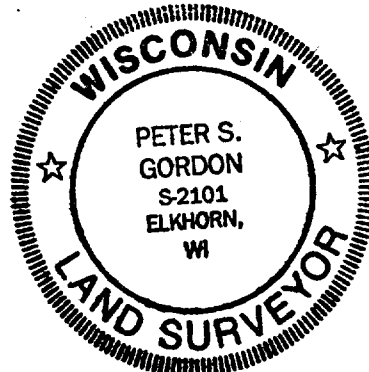

217-1071

JLCB-1106