
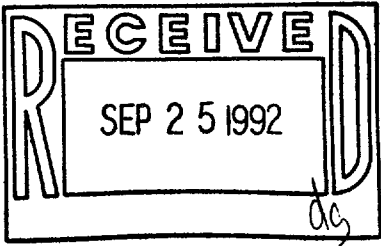


PLAT OF SURVEY

of Lots 1449, 1450, 1451, 1452, 1453, (1454), 1455, 1456, 1457, 1458 and Lots 1466, 1467, 1468 and 1469, (Block 24) all in LAKE COMO BEACH SUBDIVISION, Town of Geneva, Walworth County, Wisconsin.

NOTE: Legal description is from Document No. 200981, which omitted Lot 1454 and the block number.

AMBIT LAND SURVEYING
P.O. Box 42
Bassett, WI. 53101
414-537-4874

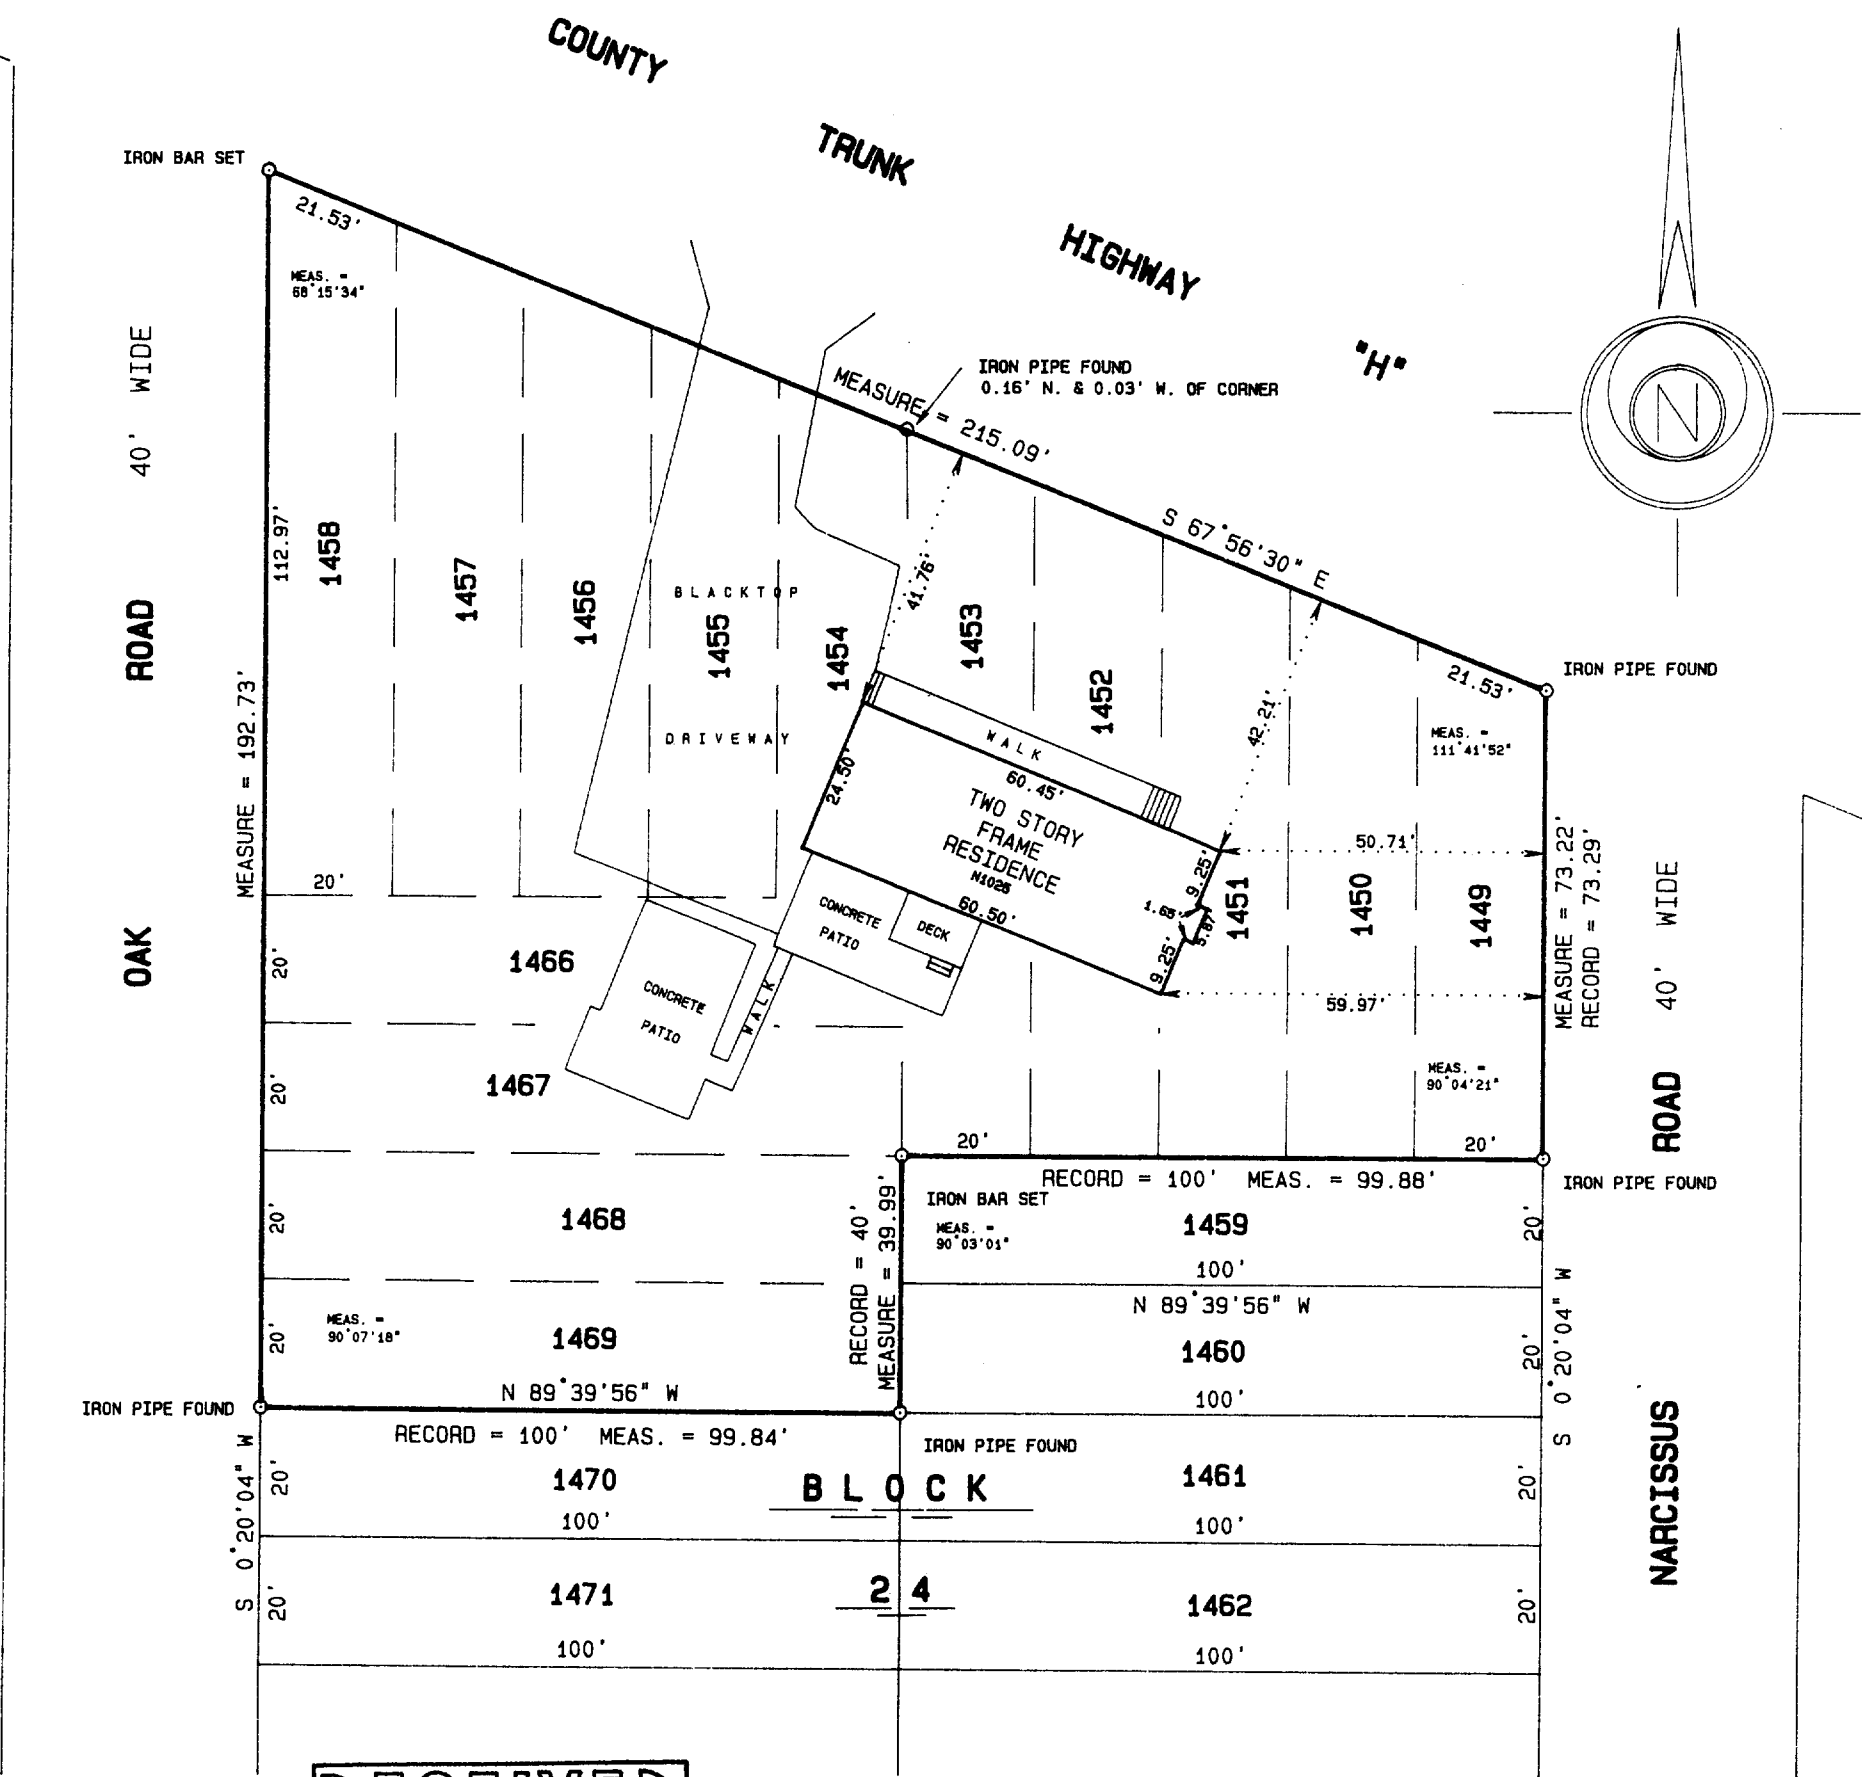

SCALE 1" = 30'
ORDERED BY Commonwealth United Mortgage
JOB NO. 92180

I hereby certify that I have surveyed the above described property and the above plat is a true representation thereof and shows the size and location of the property, its exterior boundaries, the location and dimensions of all visible structures thereon, boundary fences, apparent easements and roadways and visible encroachments, if any.

This survey is made for the exclusive use of the present owners of the property, and also those who purchase, mortgage, or guarantee the title thereto within one year from the date hereof.

Dated at Bassett, Wisconsin this 8th day of July 1992.


Mark A. Bolender
Mark A. Bolender
Wisconsin Registered Land Surveyor S - 1784

COUNTY

TRUNK

HIGHWAY

"H"

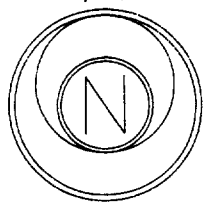

I hereby certify that I have surveyed the above described property and the above plat is a true representation thereof and shows the size and location of the property, its exterior boundaries, the location and dimensions of all visible structures thereon, boundary fences, apparent easements and roadways and visible encroachments, if any.

Dated at Bassett, Wisconsin this 8th day of JULY 1992.

Mark A. Bolender

Mark A. Bolander
Wisconsin Registered Land Surveyor S - 1784

217-1074