


ABELL SURVEYING & MAPPING

DELAVER, WISCONSIN 53115


414-728-6737

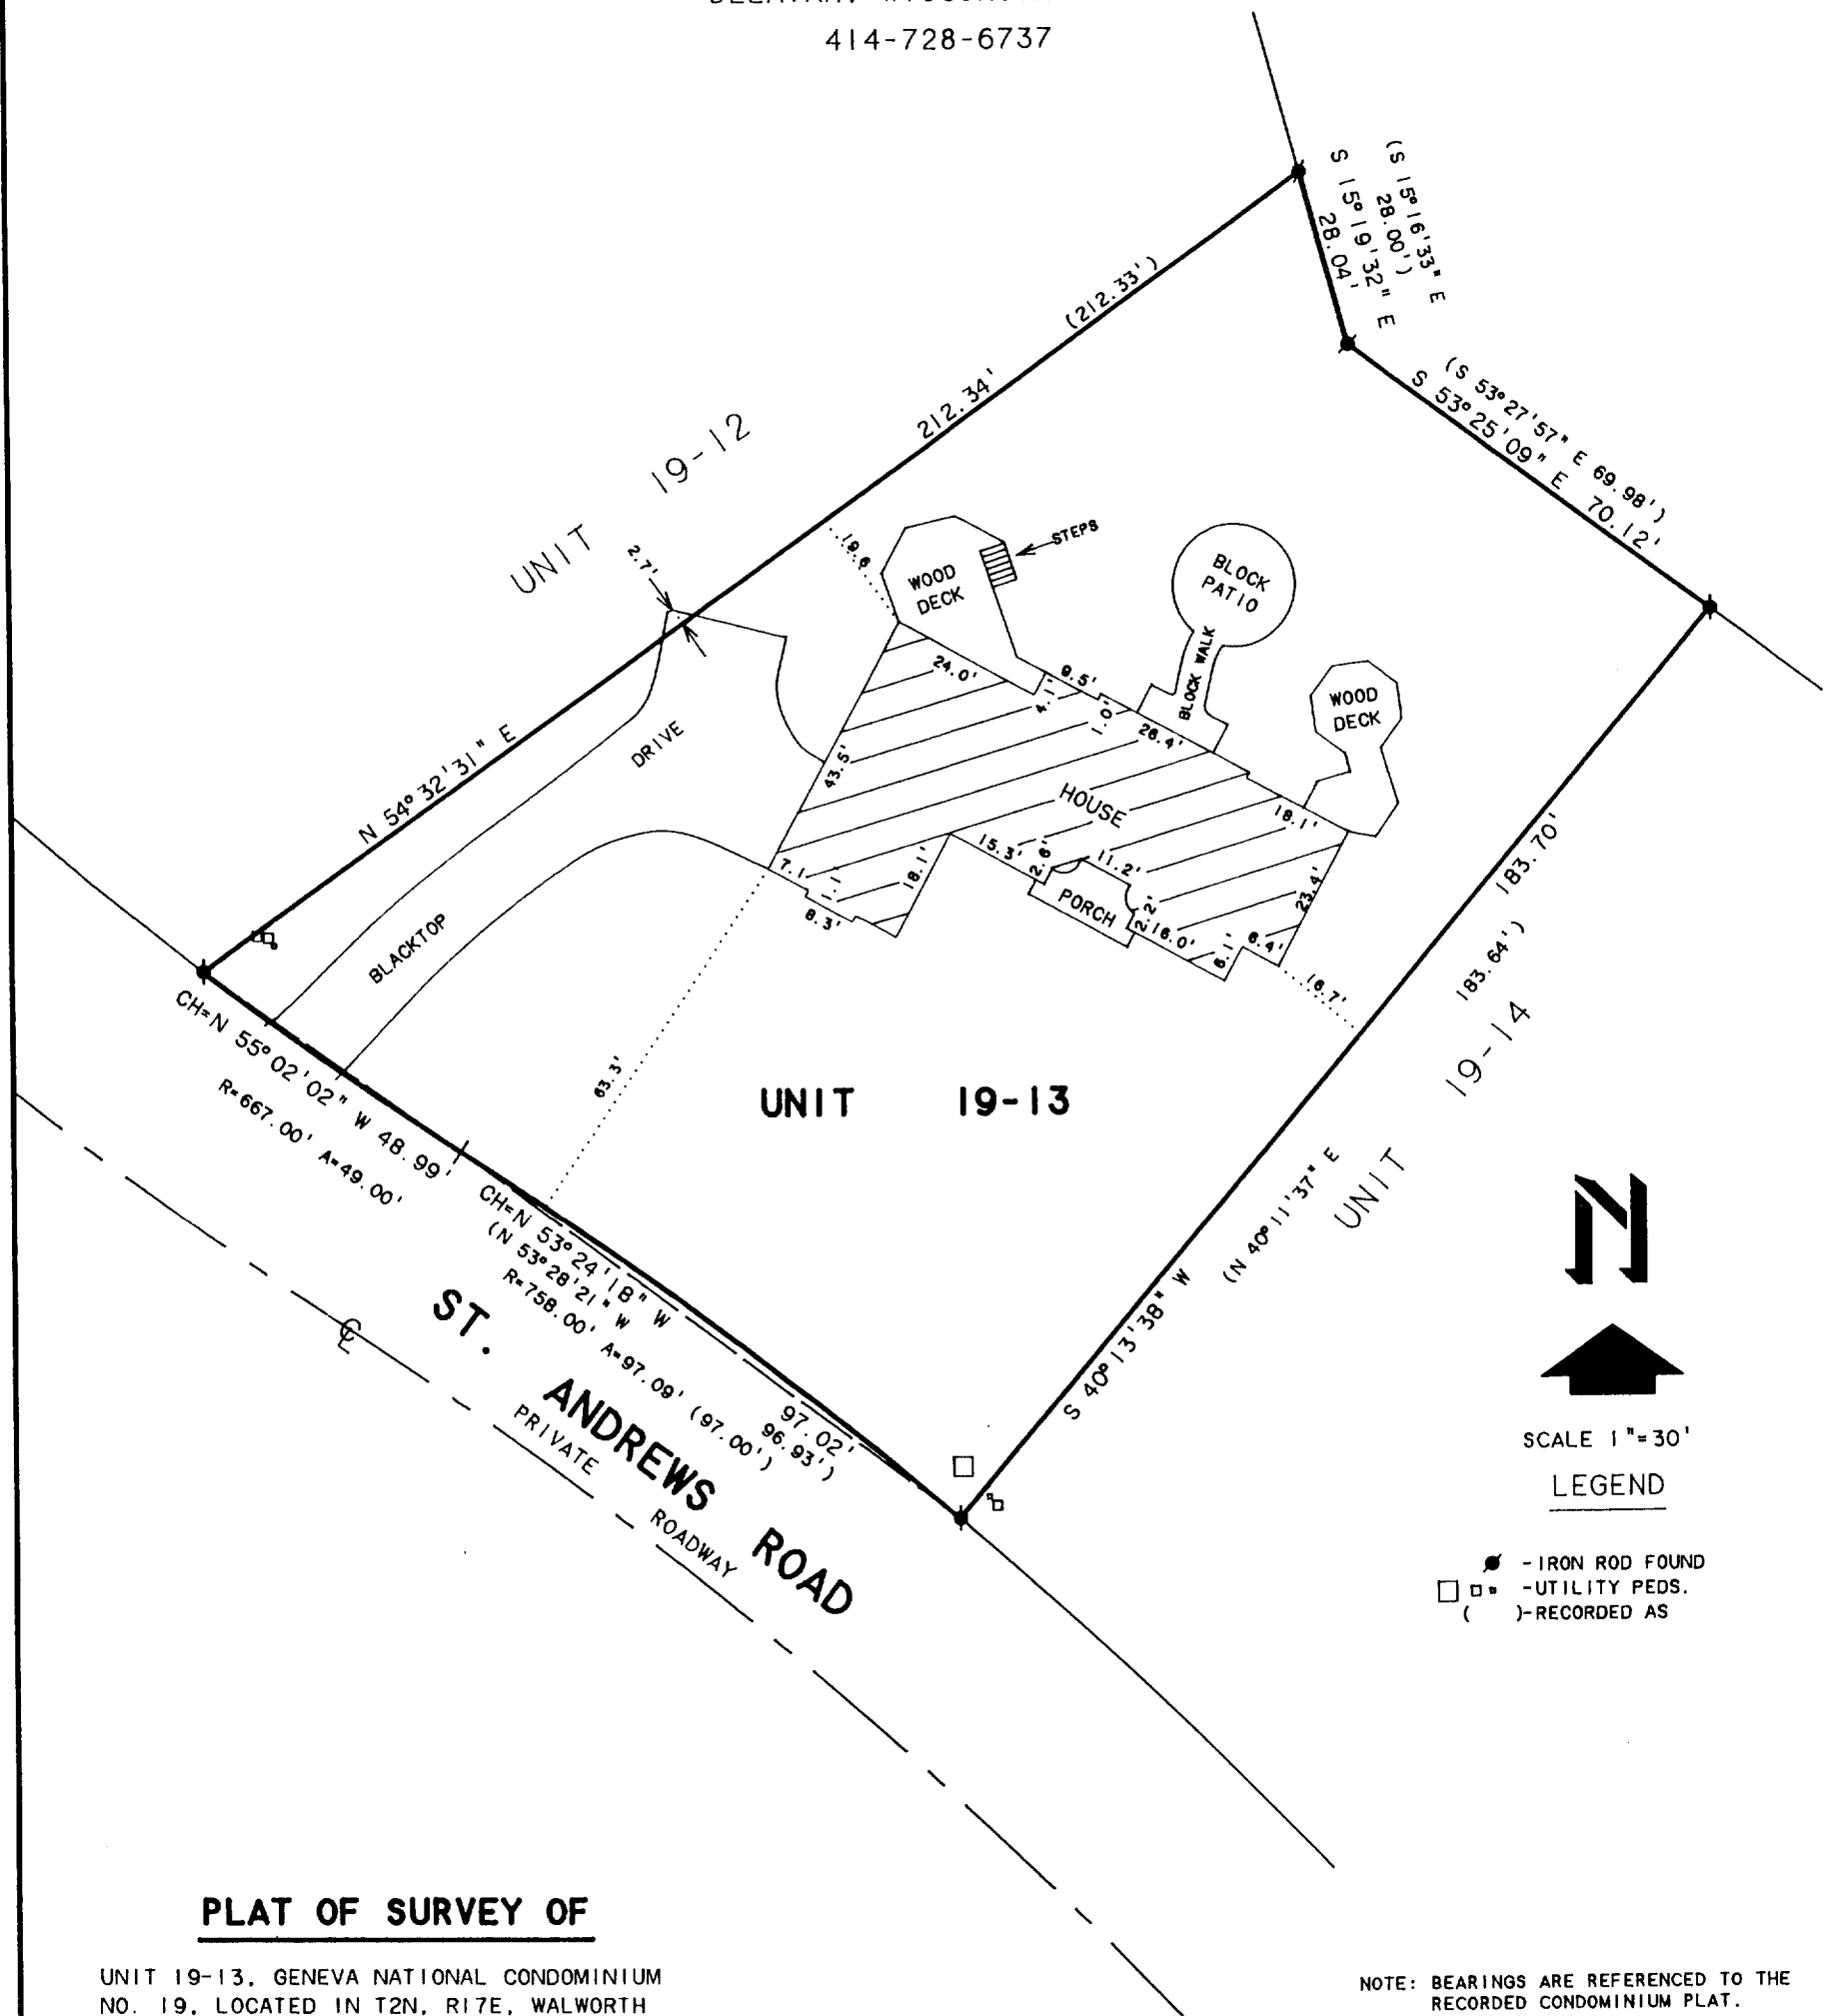

PLAT OF SURVEY OF

UNIT 19-13, GENEVA NATIONAL CONDOMINIUM
NO. 19, LOCATED IN T2N, R17E, WALWORTH
COUNTY, WISCONSIN.

ORDERED BY: ANCHOR BANK
P.O. BOX 997
LAKE GENEVA, WI. 53147

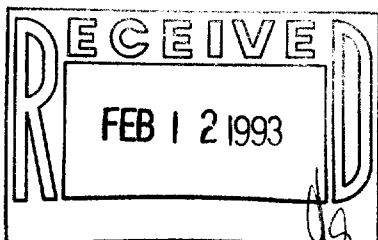

I HEREBY CERTIFY THAT I HAVE SURVEYED THE ABOVE DESCRIBED PROPERTY AND THAT THE ABOVE MAP IS A TRUE REPRESENTATION THEREOF AND SHOWS THE SIZE AND LOCATION OF THE PROPERTY, ITS EXTERIOR BOUNDARIES, THE LOCATION OF ALL VISIBLE STRUCTURES AND DIMENSIONS OF ALL PRINCIPAL BUILDINGS THEREON, BOUNDARY FENCES, APPARENT EASEMENTS, ROADWAYS AND VISIBLE ENCROACHMENTS, IF ANY, TO THE BEST OF MY KNOWLEDGE AND BELIEF.

THIS SURVEY IS MADE FOR THE USE OF THE PRESENT OWNERS OF THE PROPERTY, AND ALSO THOSE WHO PURCHASE, MORTGAGE, OR GUARANTEE THE TITLE THERETO WITHIN ONE (1) YEAR FROM DATE HEREON.

David F. Abell

DAVID F. ABELL
WISCONSIN REGISTERED LAND SURVEYOR, S-1596

October 14, 1992

DATE: OCTOBER 14, 1992 JOB NUMBER - 92231
NOTE: THIS IS NOT A CERTIFIED COPY UNLESS SEALED.