


GEORGE T. DUNHAM
SURVEYING & SUBDIVIDING
DELAVER, WISCONSIN

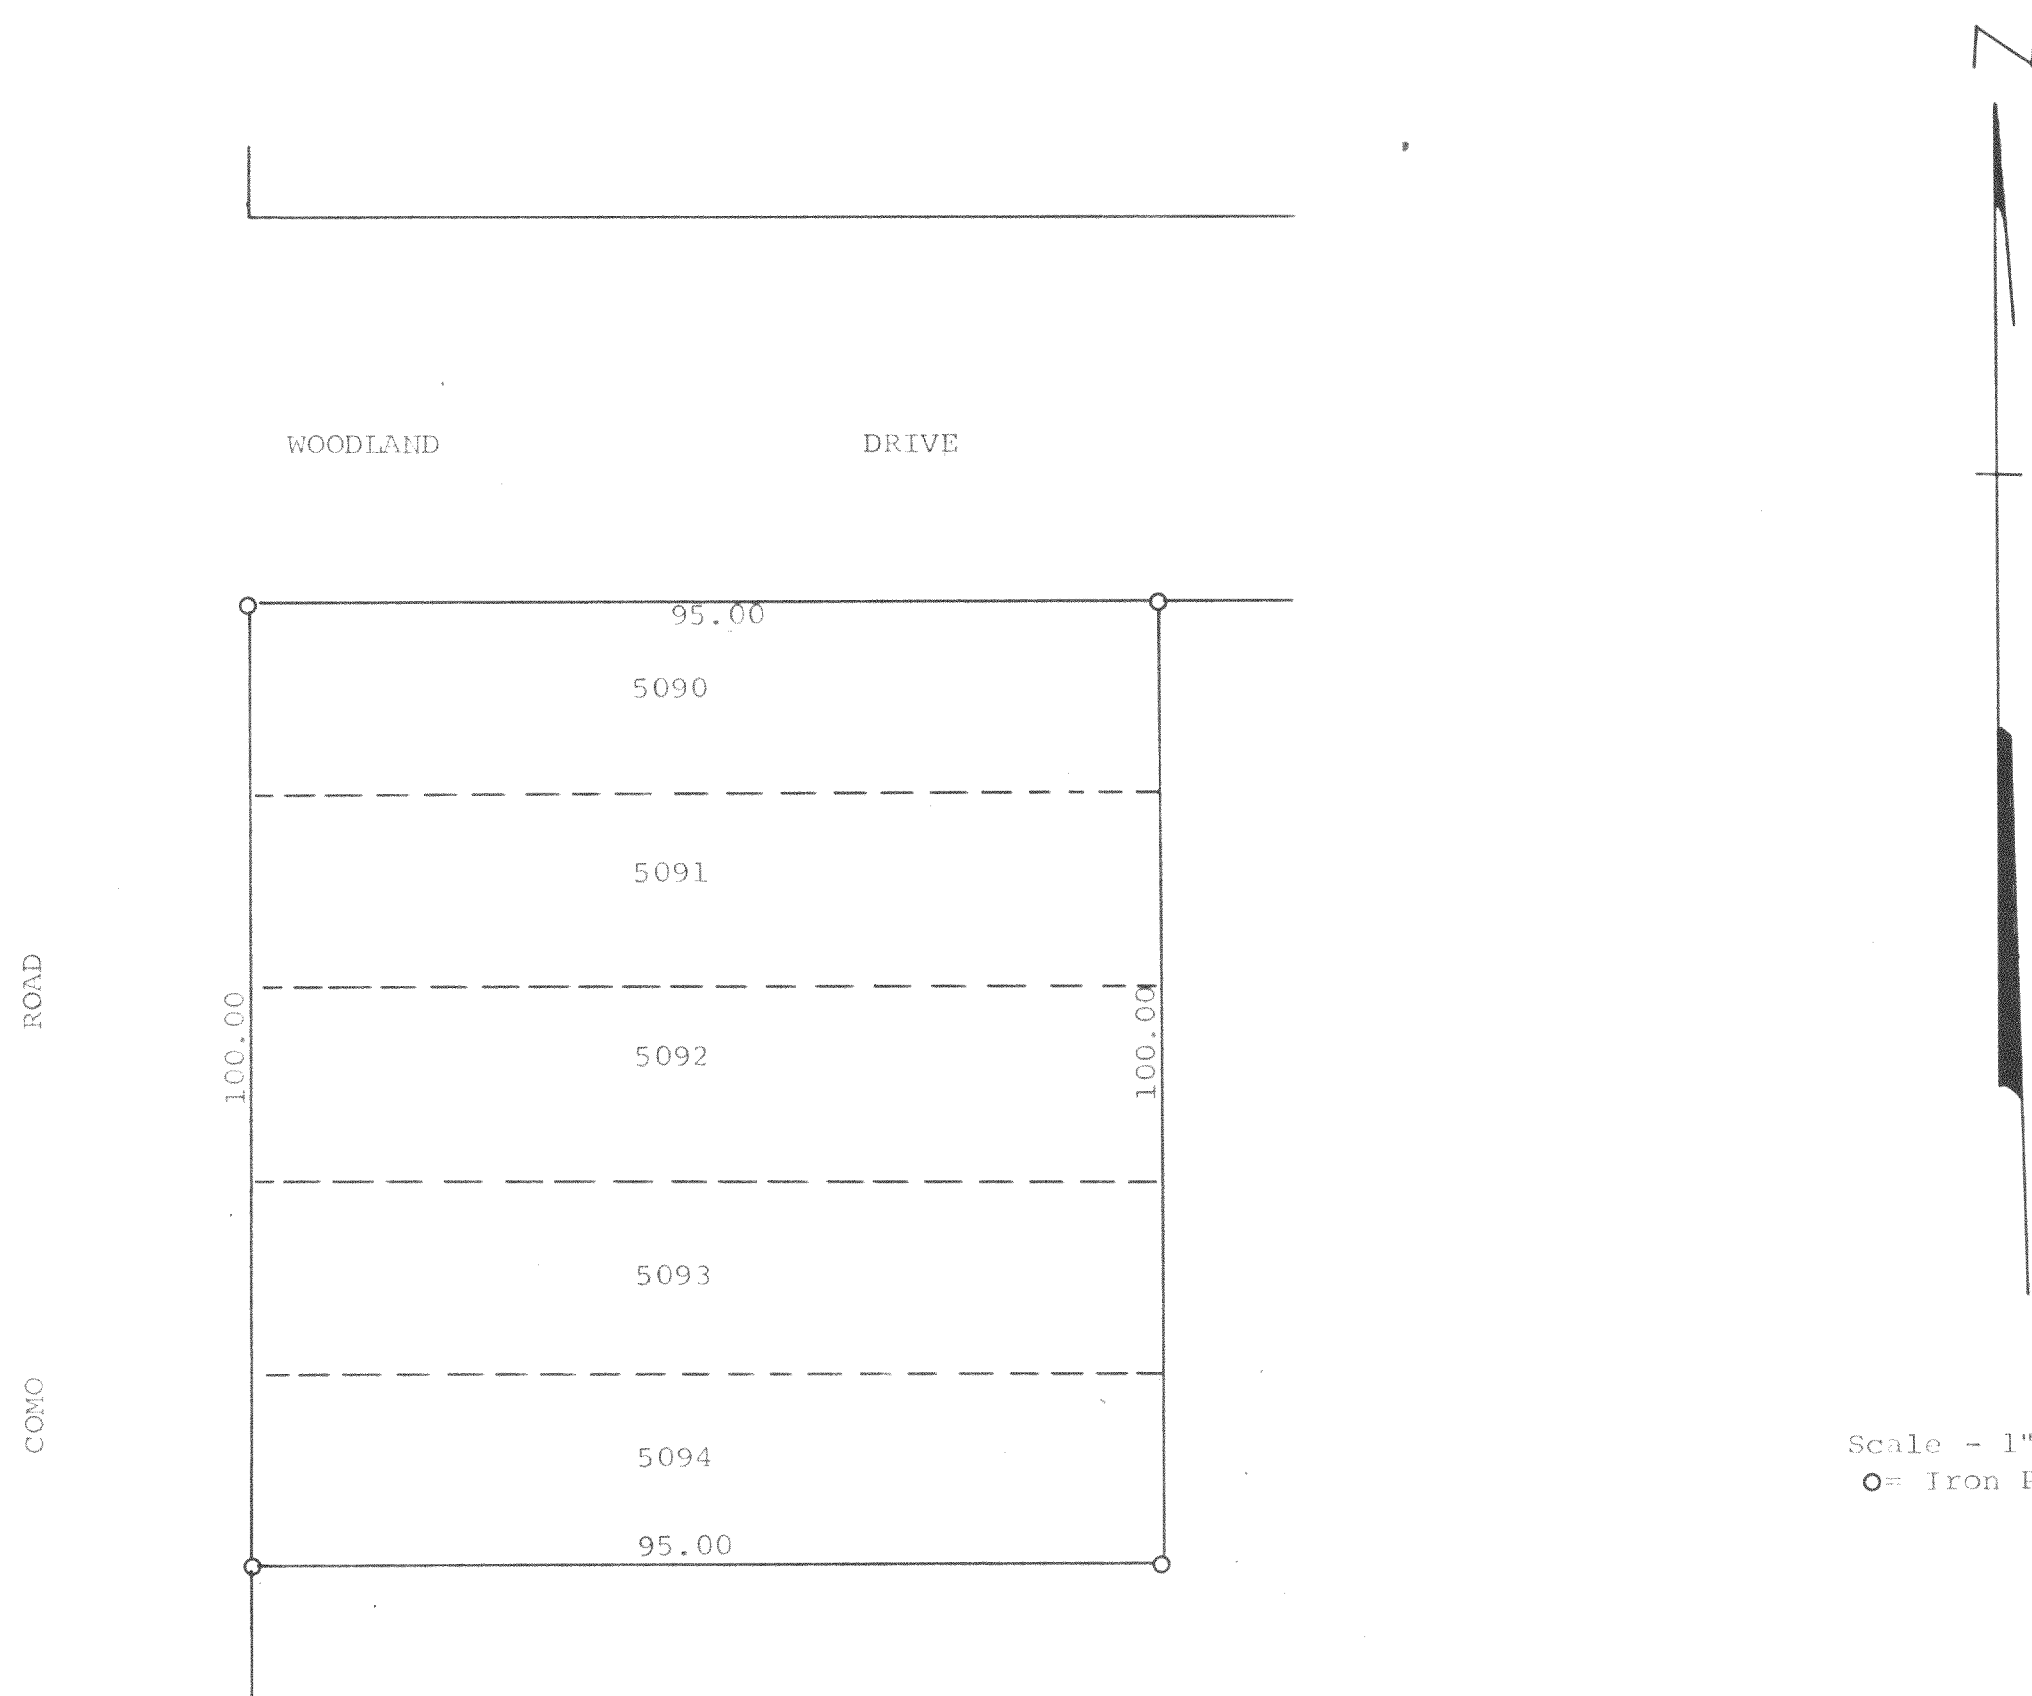

Plat of survey of Lots 5090-5094 inclusive in
Lake Como Beach, a subdivision located in the
Town of Geneva, Walworth County, Wisconsin as
surveyed on September 14, 1968
November 9, 1969

George T. Dunham
George T. Dunham, Surveyor