


HAROLD H. KOLB

REGISTERED PROFESSIONAL LAND SURVEYOR
LAKE GENEVA, WISCONSIN

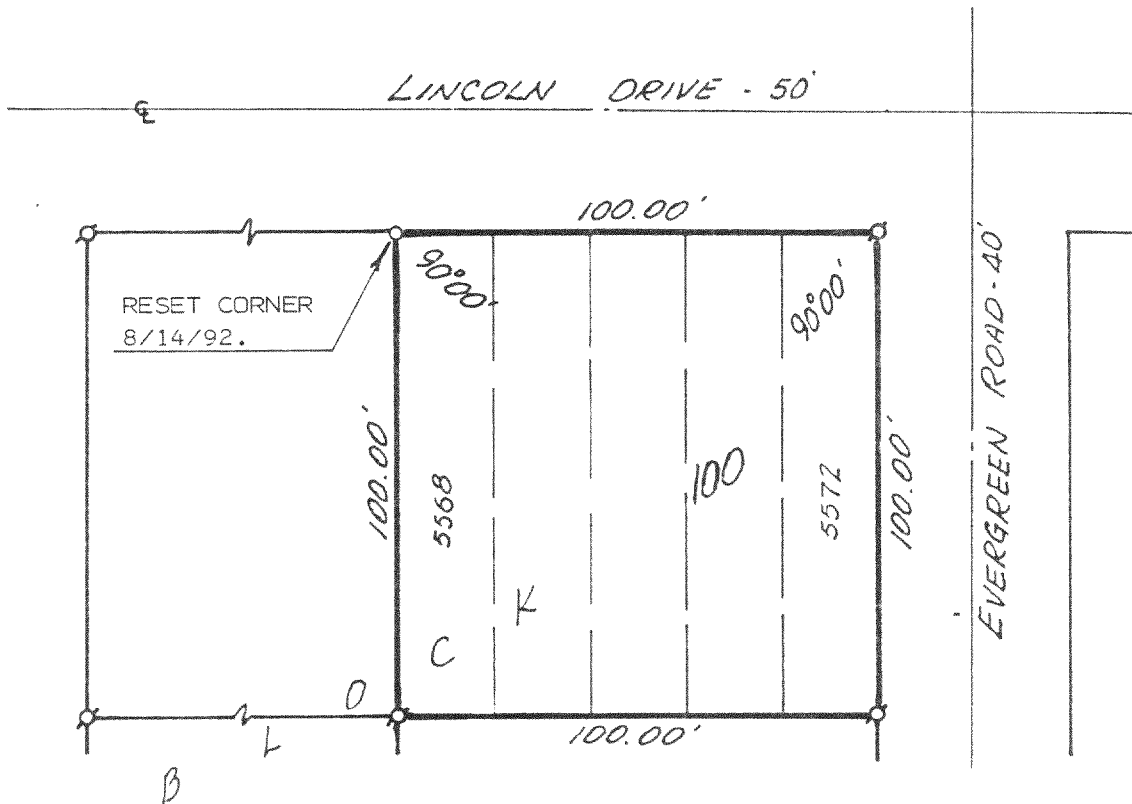

ORDERED BY: MATT LOIBL
1616 N. 22ND AVE.
MELROSE IL 60160

PLAT OF SURVEY OF

LOTS 5568-5572, BLOCK 100, OF LAKE COMO
BEACH SUBDIVISION LOCATED IN T2N, R17E,
TOWN OF GENEVA, WALWORTH COUNTY, WIS-
CONSIN.



LEGEND

- Ø - IRON PIPE FOUND
 - - IRON PIPE PLACED
 - - CONCRETE MONUMENT
 - x - SPIKE
- SCALE - 1" = 40'



I, HAROLD H. KOLB, DO HEREBY CERTIFY
THAT I HAVE SURVEYED THE PROPERTY
HEREON DESCRIBED ACCORDING TO THE
OFFICIAL RECORDS AND THAT THE PLAT
HEREON IS A CORRECT REPRESENTATION
OF THE LOT LINES TO THE BEST OF MY
KNOWLEDGE AND BELIEF.
SURVEY NOT VALID UNLESS SURVEYOR'S SIGNATURE
IS IN RED.

HAROLD H. KOLB
WISCONSIN REGISTERED LAND SURVEYOR, S-187

DATE: AUG. 17, 1992

REVISED:

REVISED:

217-1137

JLB-1132

2-17-6A