


DUNHAM SURVEYING, S.C.
SURVEYING & SUBDIVIDING
DELAVER, WISCONSIN 53115

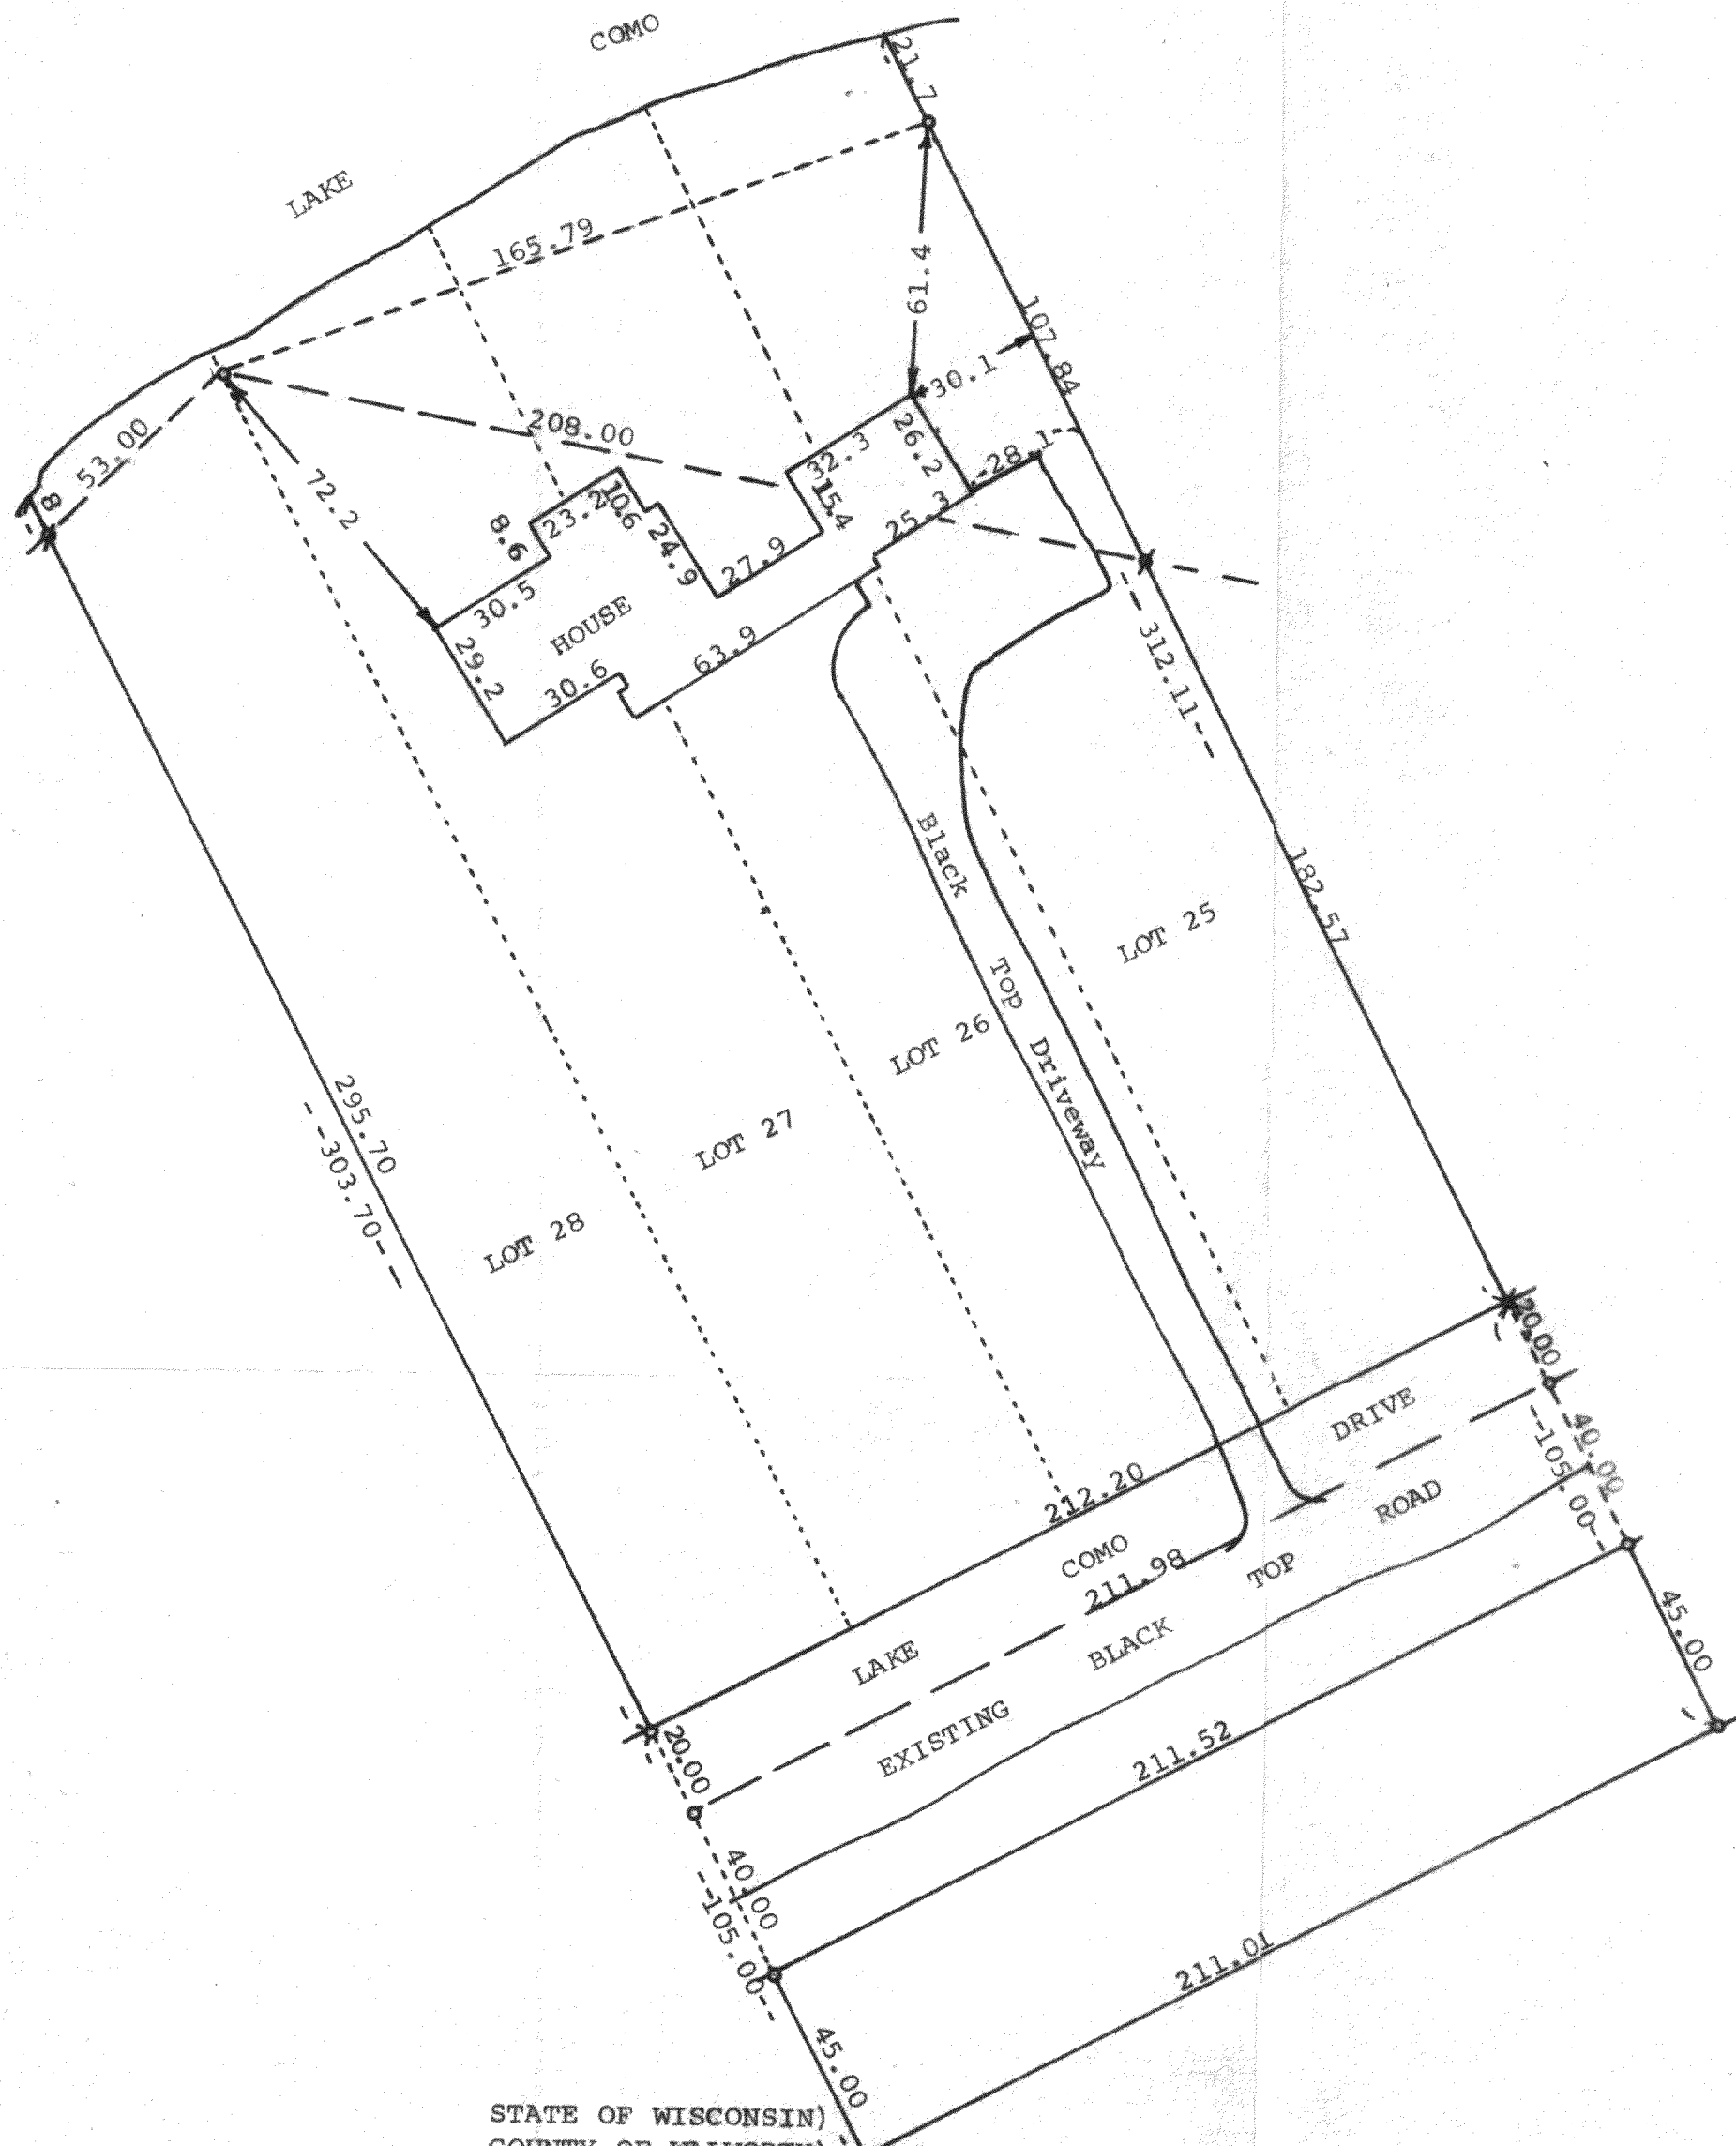

Scale - 1" = 40'
⊗ = Iron Pipe Found
○ = Iron Pipe Set

STATE OF WISCONSIN)
COUNTY OF WALWORTH)

I, George T. Dunham, Surveyor, certify that I have surveyed the property described as follows:

Lots 25, 26, 27, and 28, the Consumers Company Subdivision located in Sections 28, 32 and 33 T2N, R17E, Walworth County, Wisconsin,
Also commencing at the most southerly corner of said Lot 28; thence Southeasterly along the southeasterly extension of the southwesterly line of said Lot 28, 20.00 feet to the place of beginning; thence continue southeasterly along said line 85.00 feet to a point located 15.00 feet northwesterly of the southeasterly line of the abandoned Chicago & Northwestern Railroad Right of Way; thence northeasterly along a curved line running parallel with and 15.00 feet northwesterly of the southeasterly line of said right of way, a chord distance of 211.01 feet to a point on the southeasterly extension of the northeasterly line of said Lot 25; thence northwesterly along said line 85.00 feet to a point located 20.00 feet southeasterly of the most easterly corner of said Lot 25; thence southwesterly 211.98 feet to the place of beginning, subject to a right of way for an existing road across the northwesterly 40.00 feet of the above described parcel and subject to any other right of ways and easements of record.

and the above map is a true representation thereof and shows the size and location of the property, its exterior boundaries, the location and dimensions of all structures thereon, fences, apparent easements and roadways and visible encroachments, if any.
This survey is made for the exclusive use of the present owners of the property, and also those who purchase, mortgage, or guarantee the title thereto within one (1) year from date hereof; and as to them I warrant the accuracy of said survey and map.
August 3, 1978

George T. Dunham
George T. Dunham, Surveyor

